
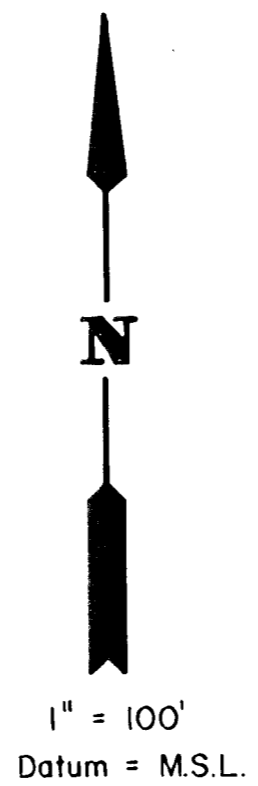


UNPLATTED (BUNDY)

# PRELIMINARY PLAT OF FIRST MENNONITE BRETHREN ADDITION


AUGUST 1984

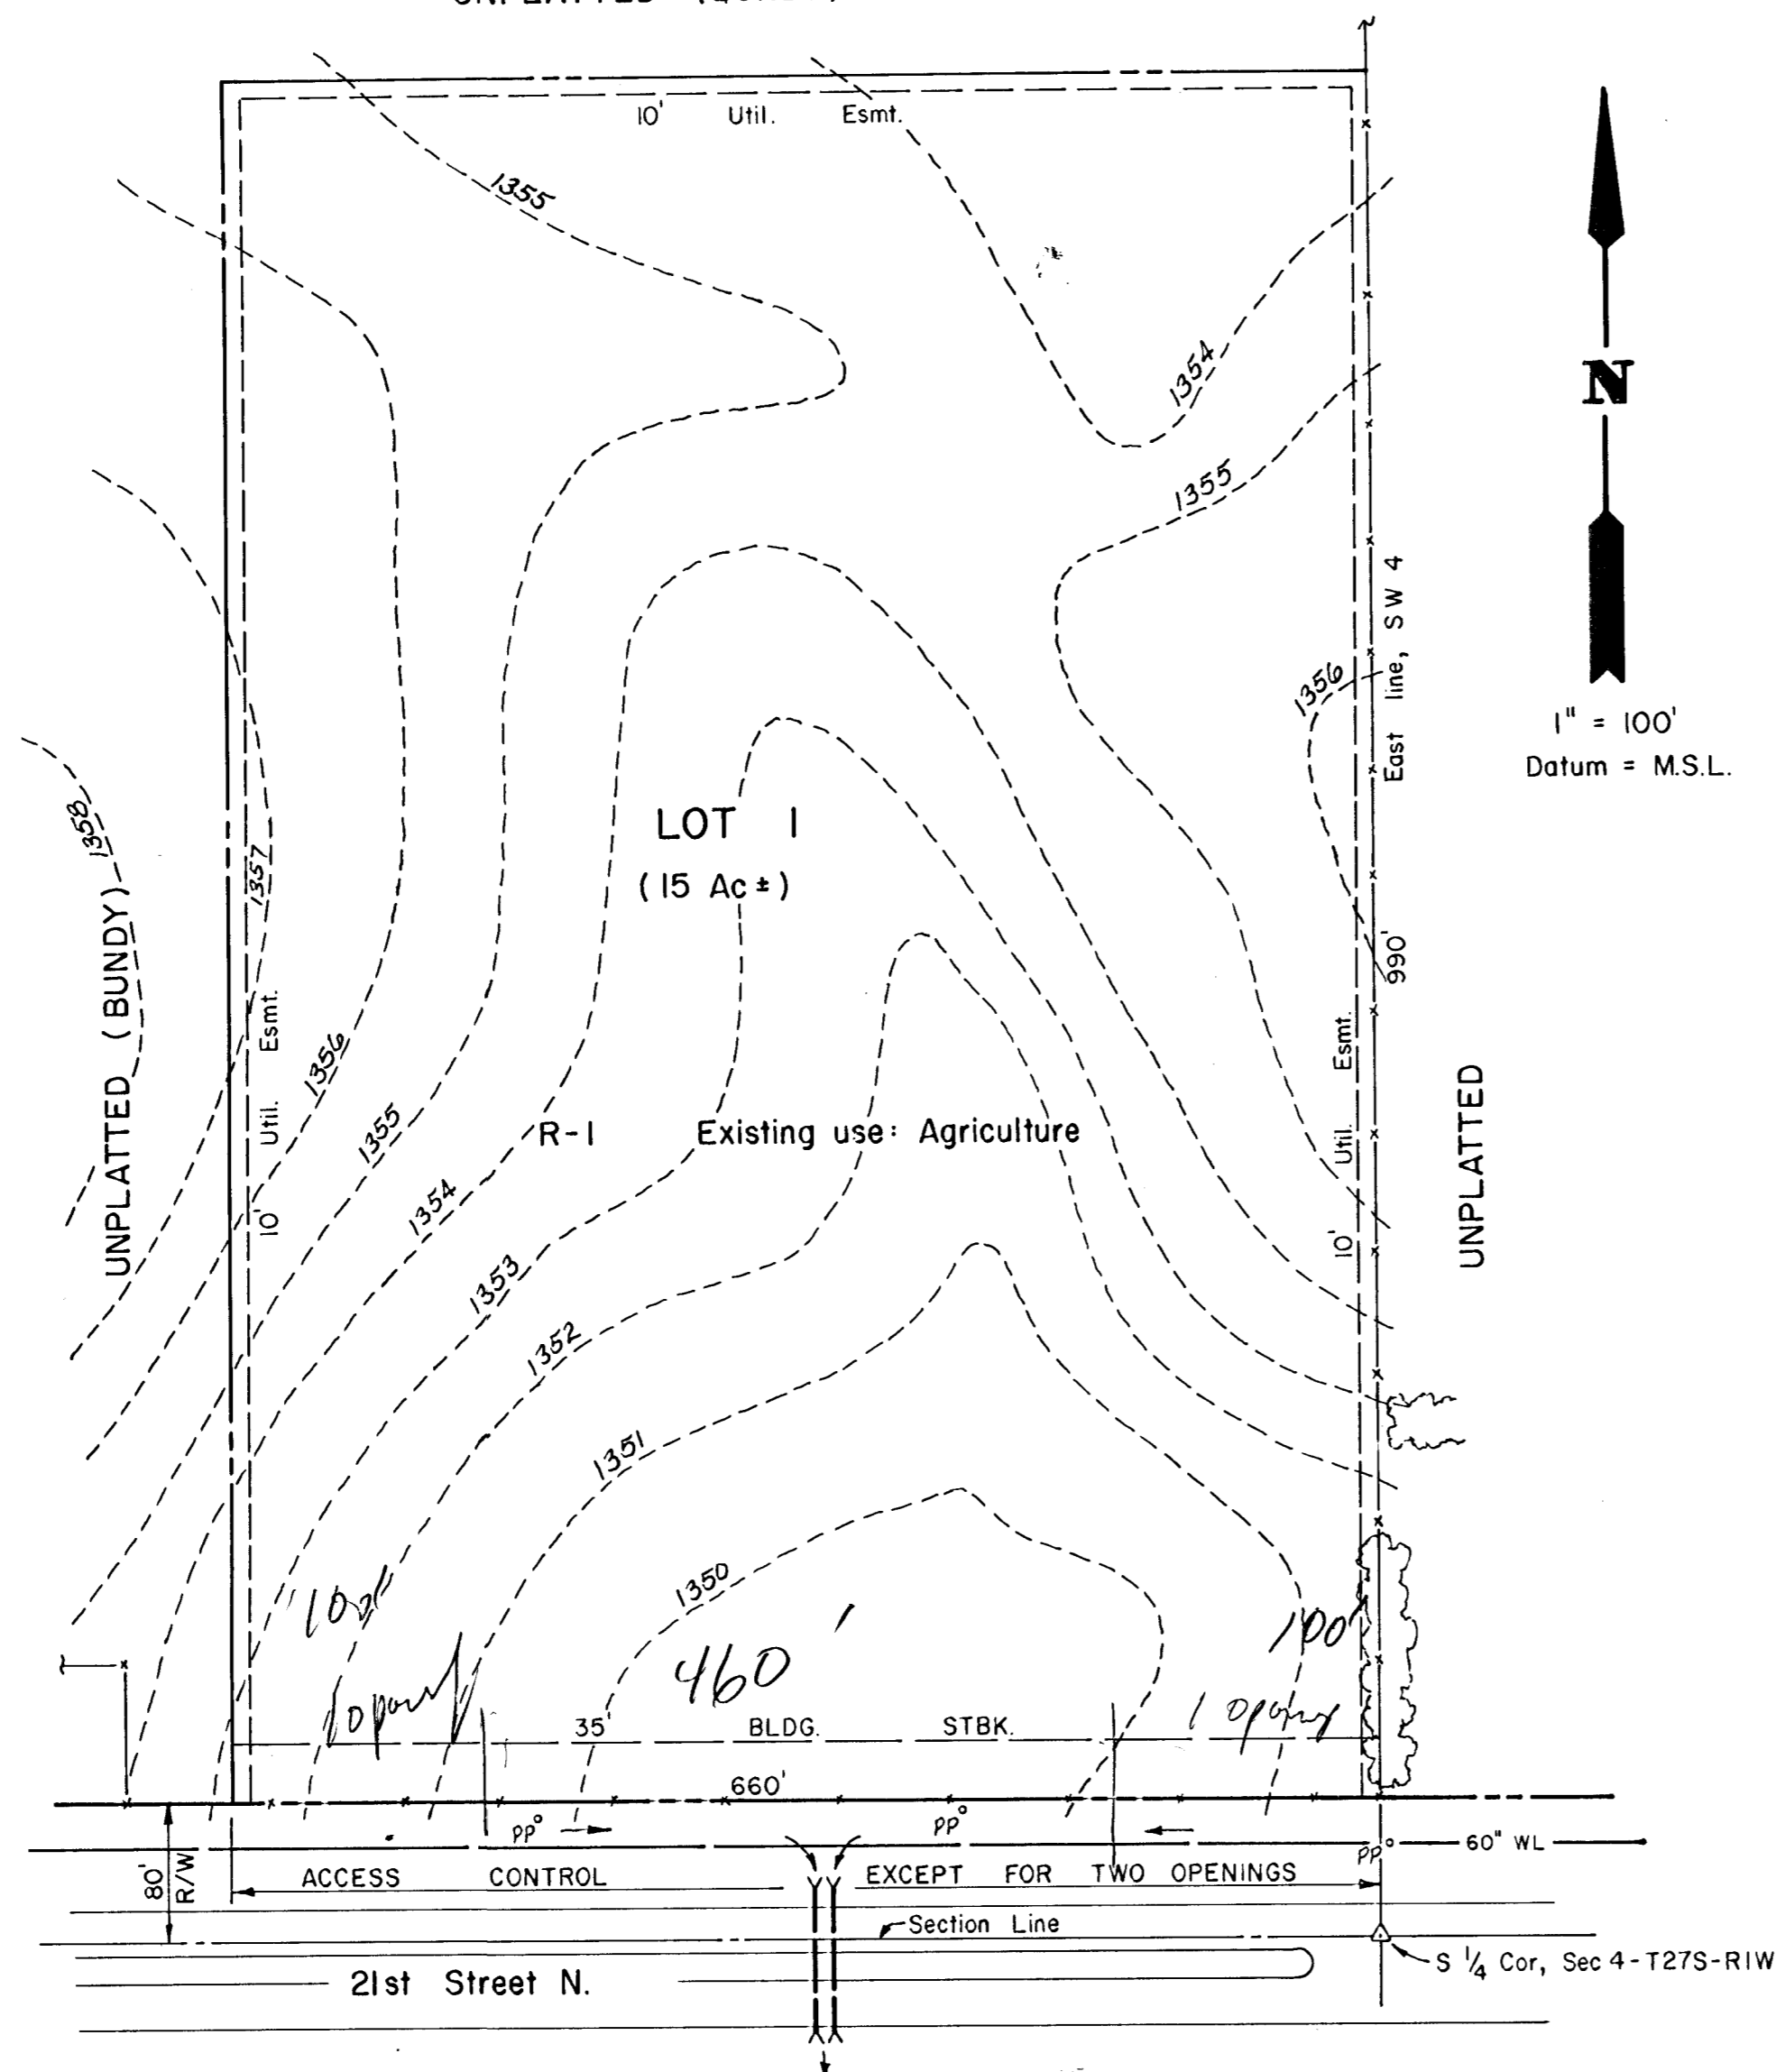

Owner: Angela Bundy  
149 S. Illinois  
Wichita, KS 67213  
943-5683

Developer: 1st Mennonite Brethren Church  
1750 North Gow  
Wichita, KS 67203  
942-4244

Engineer: Van Doren - Hazard - Stallings  
260 N. Rock Rd., Suite 250  
Wichita, KS 67206  
686-7303

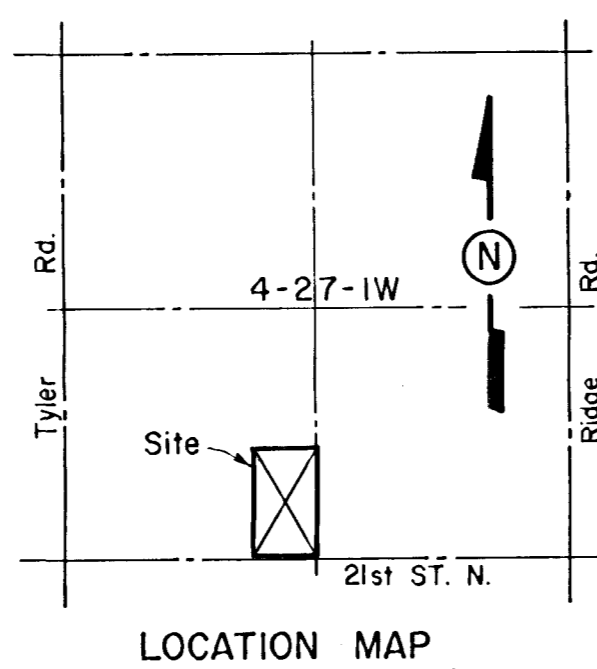

Date of Topography Survey: July 1984



Van Doren - Hazard - Stallings

Architects • Engineers • Planners  
Topeka Wichita Minneapolis