



N.W. COR. OF N.E. 1/4
SEC. 31, T. 26 S., R. 2 E.

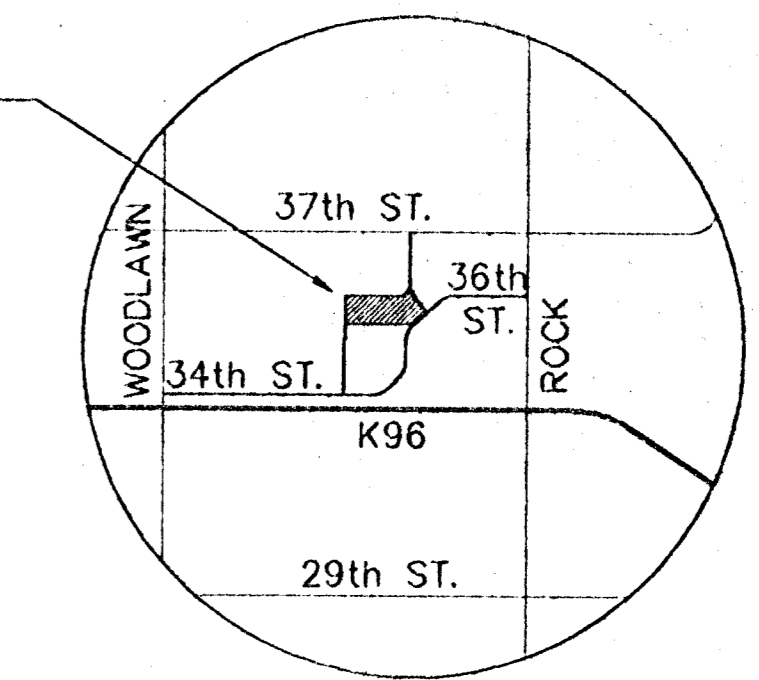

LOCATION MAP

NO SCALE

SCALE: 1"=50'

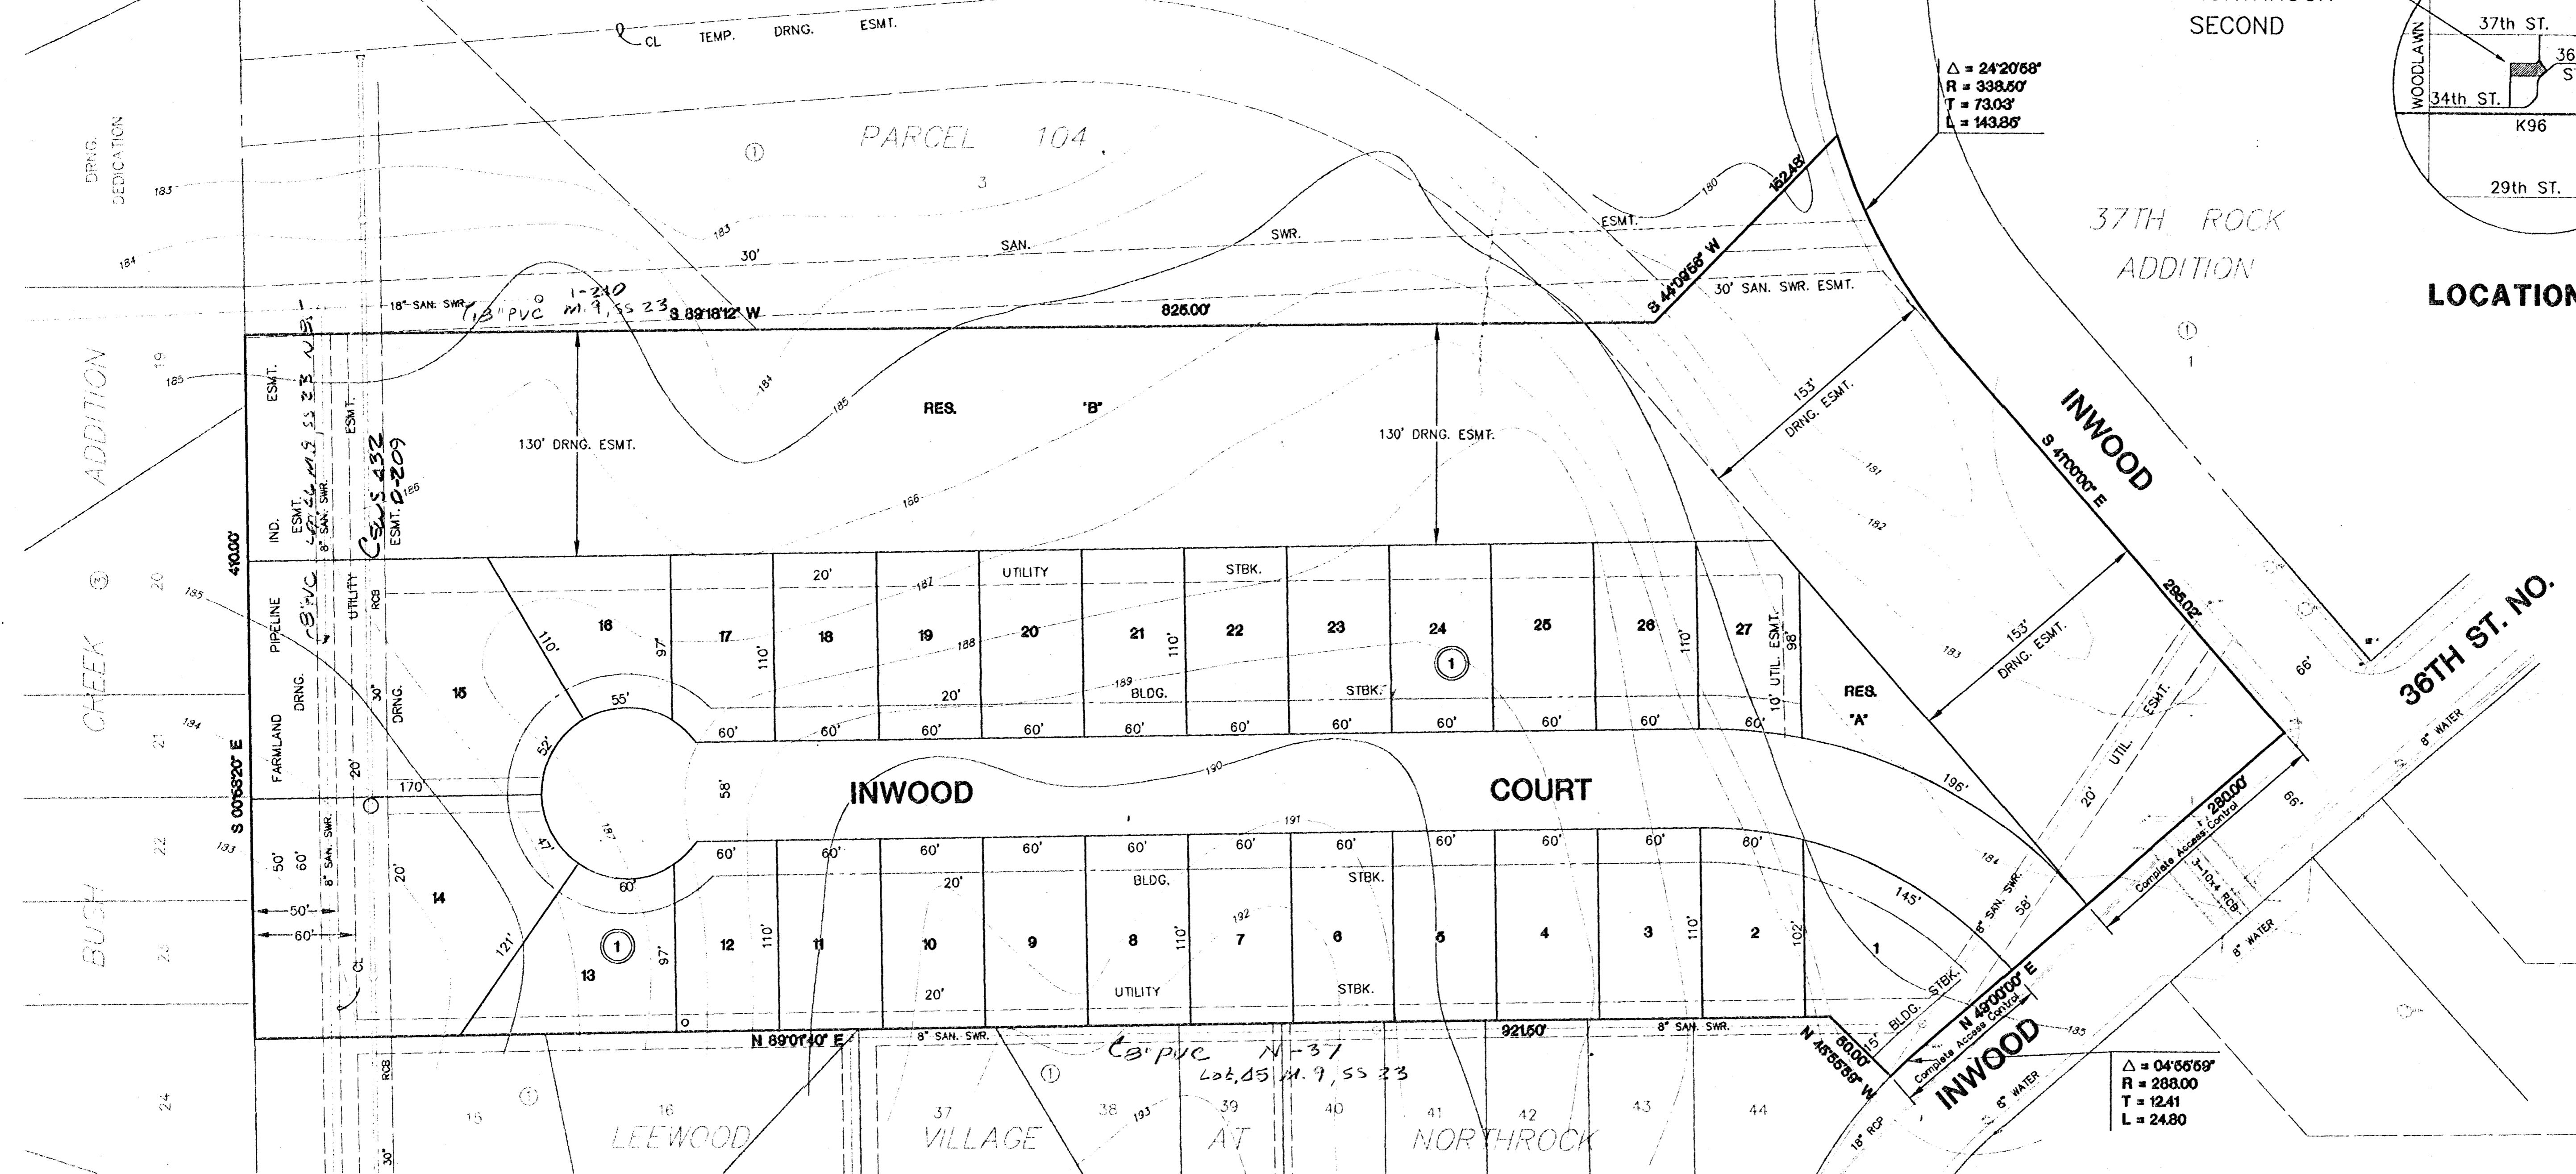

$\Delta = 24'2068"$
 $R = 338.50'$
 $T = 73.03'$
 $L = 143.85'$

$\Delta = 04'5569"$
 $R = 288.00'$
 $T = 12.41'$
 $L = 24.80'$

BENCHMARK:
Conc. Nail on N. Edge of M.H. 72' E. of
Center Sec. 31, 26S, 2E.
Elev.=194.16 (City Datum)

PRELIMINARY PLAT
LEEWOOD VILLAGE AT NORTHRACK SECOND

OWNER: LEEWOOD HOMES INC.
6130 LEGION
WICHITA, KANSAS 67204

	Design	GJA
	Drawn by	KKL
	Checked by	
	Date	6/20/94
LEEWOOD VILLAGE AT NORTHRACK SECOND		Job no.

MID-KANSAS ENGINEERING CONSULTANTS INC.
3500 NORTH ROCK ROAD
BUILDING #800
WICHITA, KANSAS 67226
(316) 636-5566

Sheet 1
of 1