Dist 4 SS N-12 1961

SS J-170 F-282 C-24

SWS A-143 B-170

PRELIMINARY PLAT OF
HARVEST COMMUNICATIONS ADDITION

OWNER DEVELOPER: TRIPLE A PROPERTIES INC.
C/O DON ABLAH
224 E. DOUGLAS SUITE 450
WICHITA KS. 67202

ENGINEER: PROFESSIONAL ENGINEERING CONSULTANTS P.A.
1440 ENGLISH
WICHITA, KS. 67211

Scale: 1" = 30'

Bench Mark - NW Cor. SD Inlet
W. of alley W. of Blvd. Plaza
on S. side Lincoln.
El. 103.72 City Datum

Date 5-6-88
Date of Topo 4-19-88

LEGEND

- WM• Water Meter
- GM⊡ Gas Meter w/3'x3' Guard Pipes
- Buried Gas Line (2")
- PPo Power Pole (Overhead Line)
- DM⊗ Deadman
- T&PPo Telephone & Power Pole (Overhead Lines)
- Buried Telephone Line
- WV• Water Valve
- SS MHO Sanitary Sewer Manhole
- C&G 2.5' Std. Type Curb & Gutter
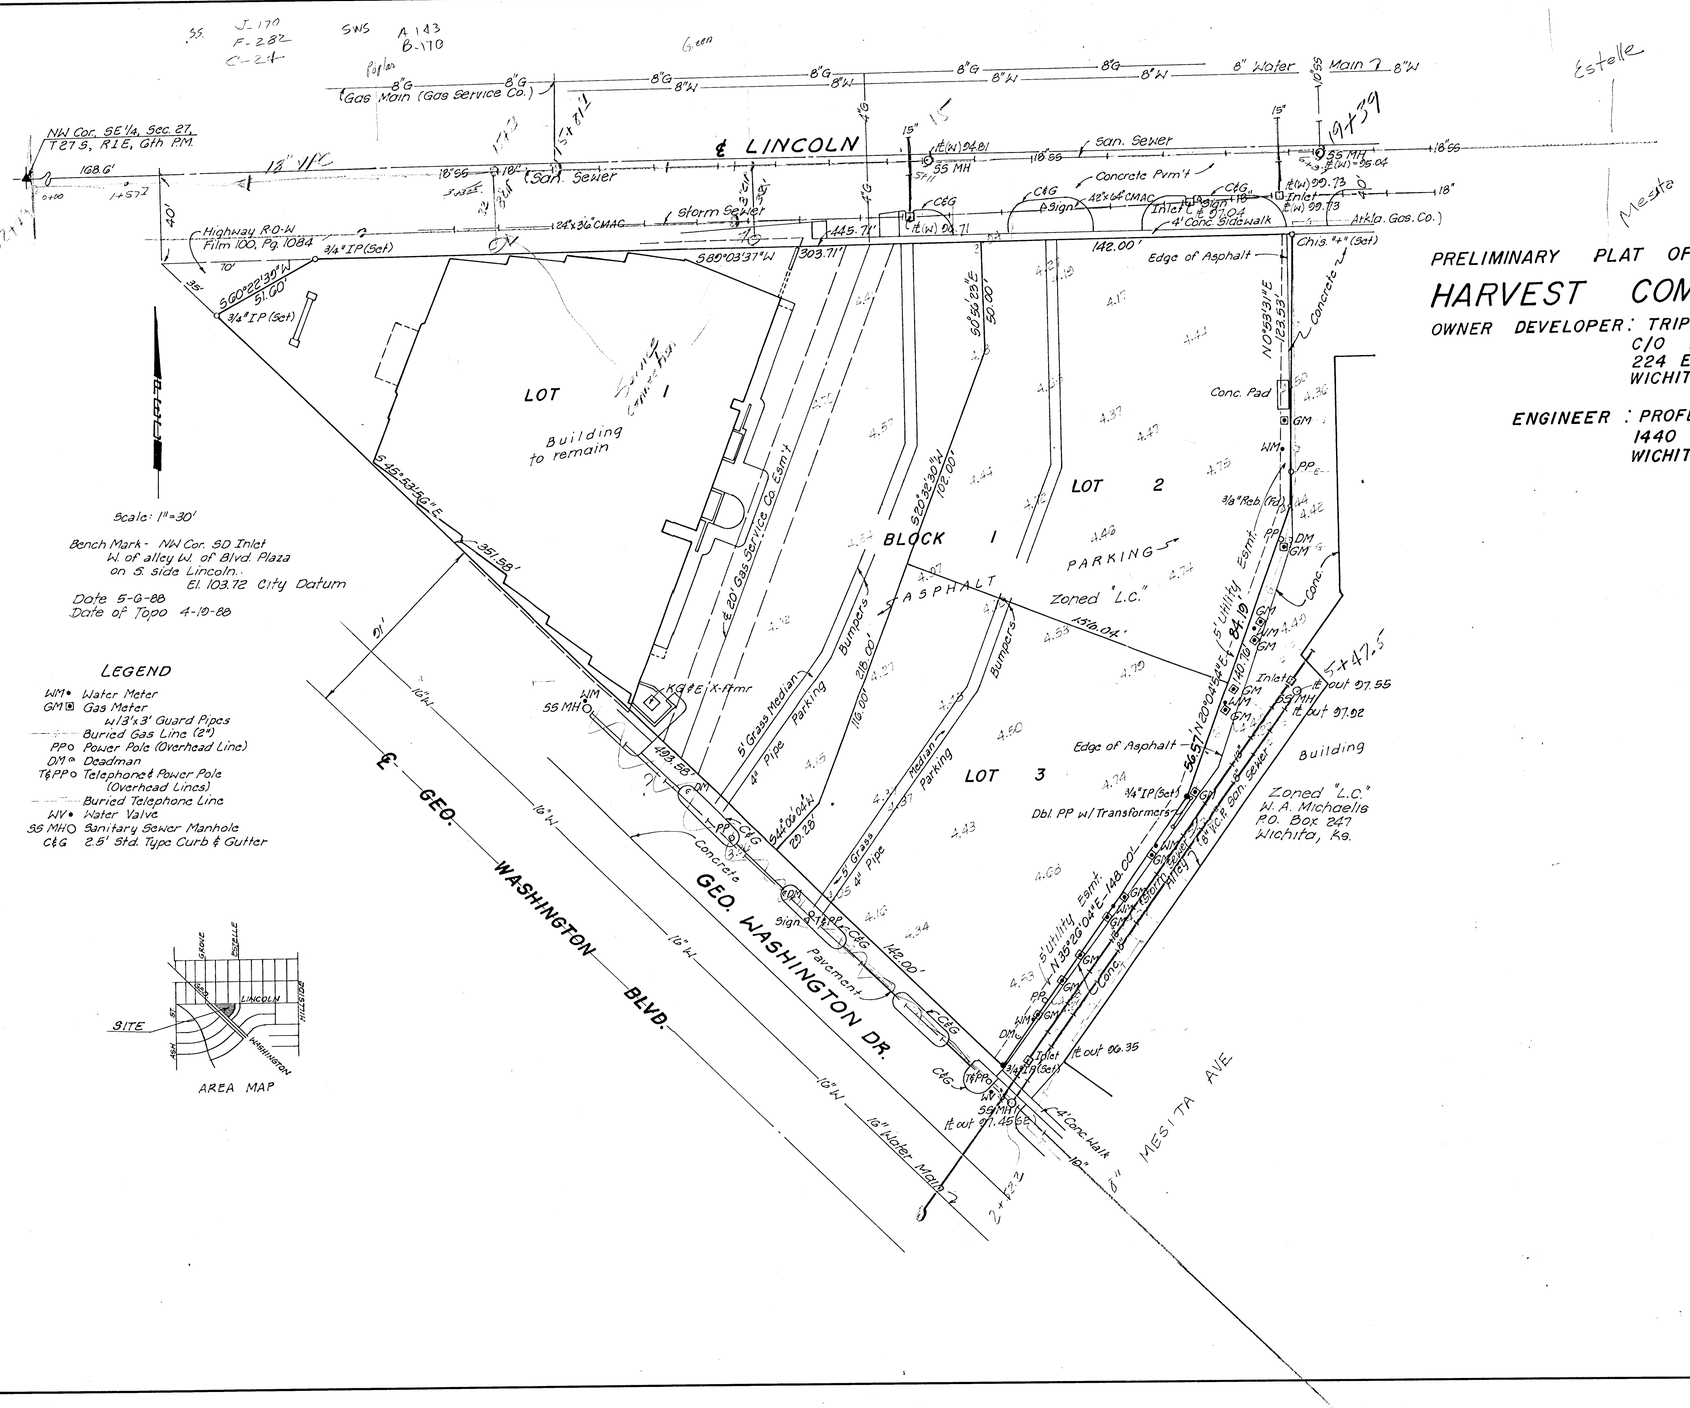
AREA MAP