


LOCATION MAP



PRELIMINARY PLAT GUY'S ADDITION

OWNER: CASADO INC. REALTORS, 236 S. TOPEKA, NICHITA, KANSAS

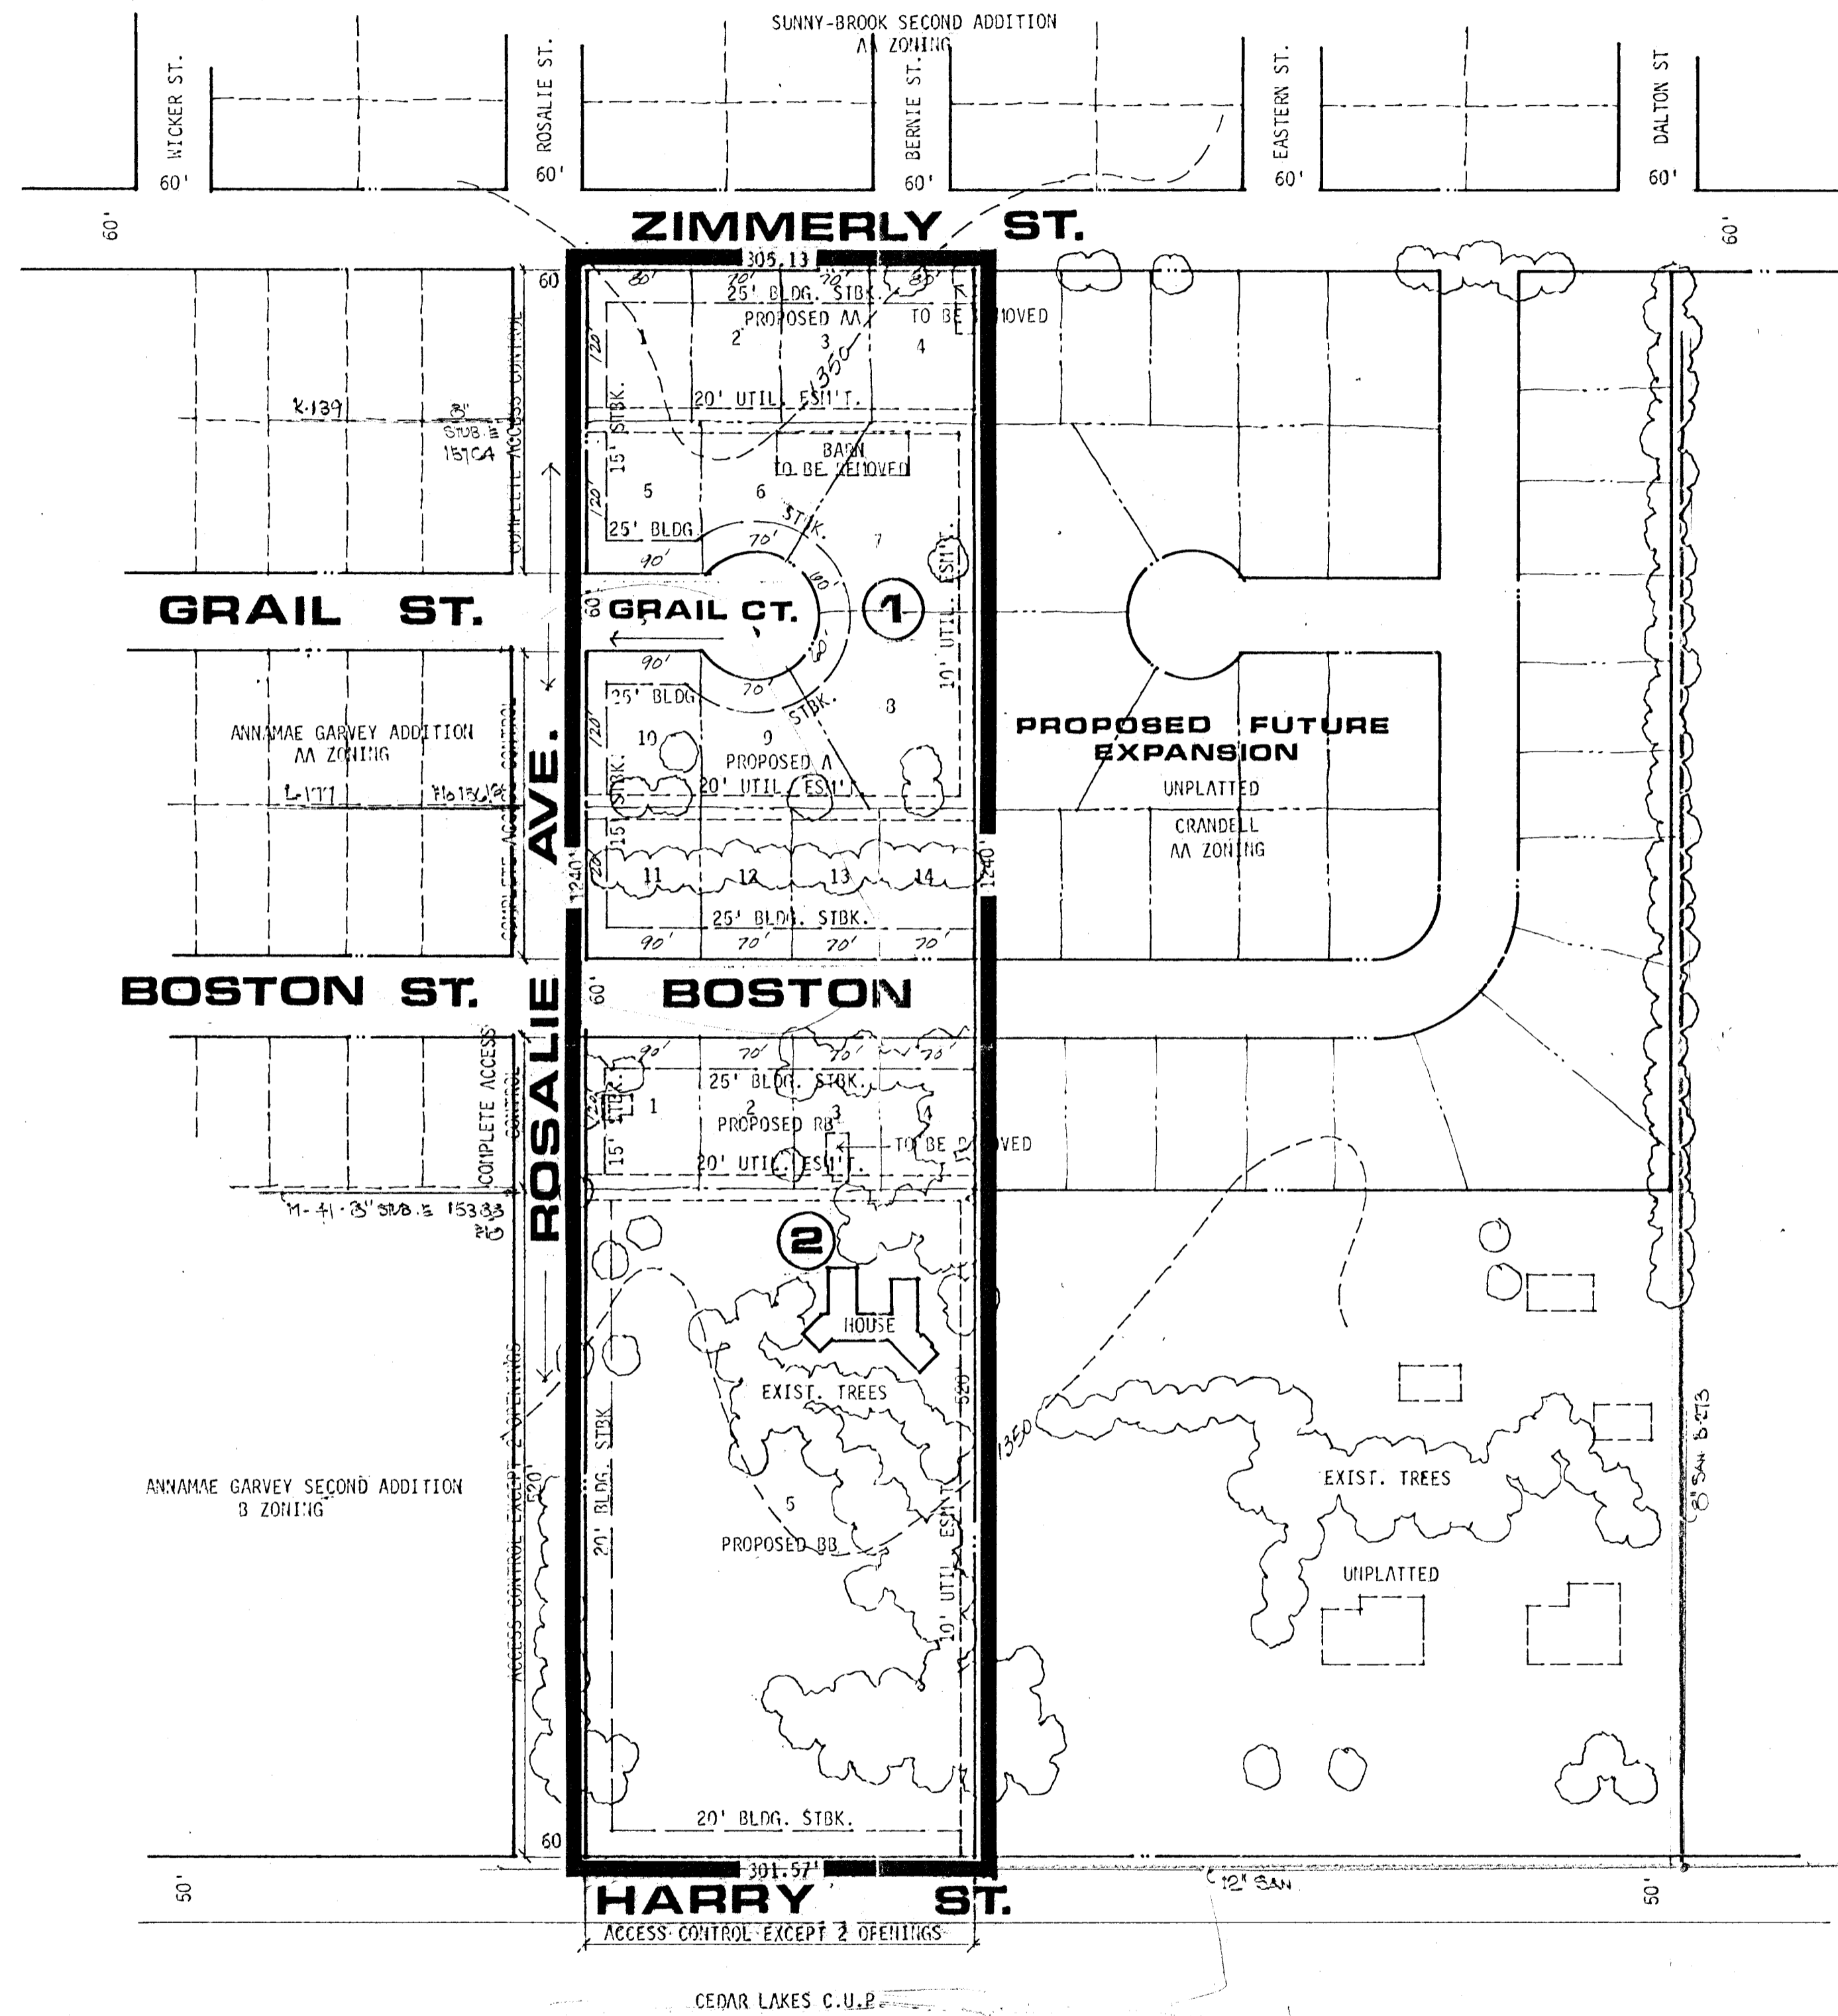

BILL G. YUNG DESIGN
1856 NORTH WACO, WICHITA, KANSAS, 67203
316-284-0676

date DATE: OCTOBER, 2013 USD
rev.

sheet title
PRELIMINARY PLAT

project
CASADO, INC. REALTORS

sheet
of