REVISED
PRELIMINARY PLAT
FORMERLY GRAY'S SECOND ADDITION

GRAY'S 4TH ADDITION

TO SEDGWICK CO., KANSAS

Approved
Fire Hydt. Map

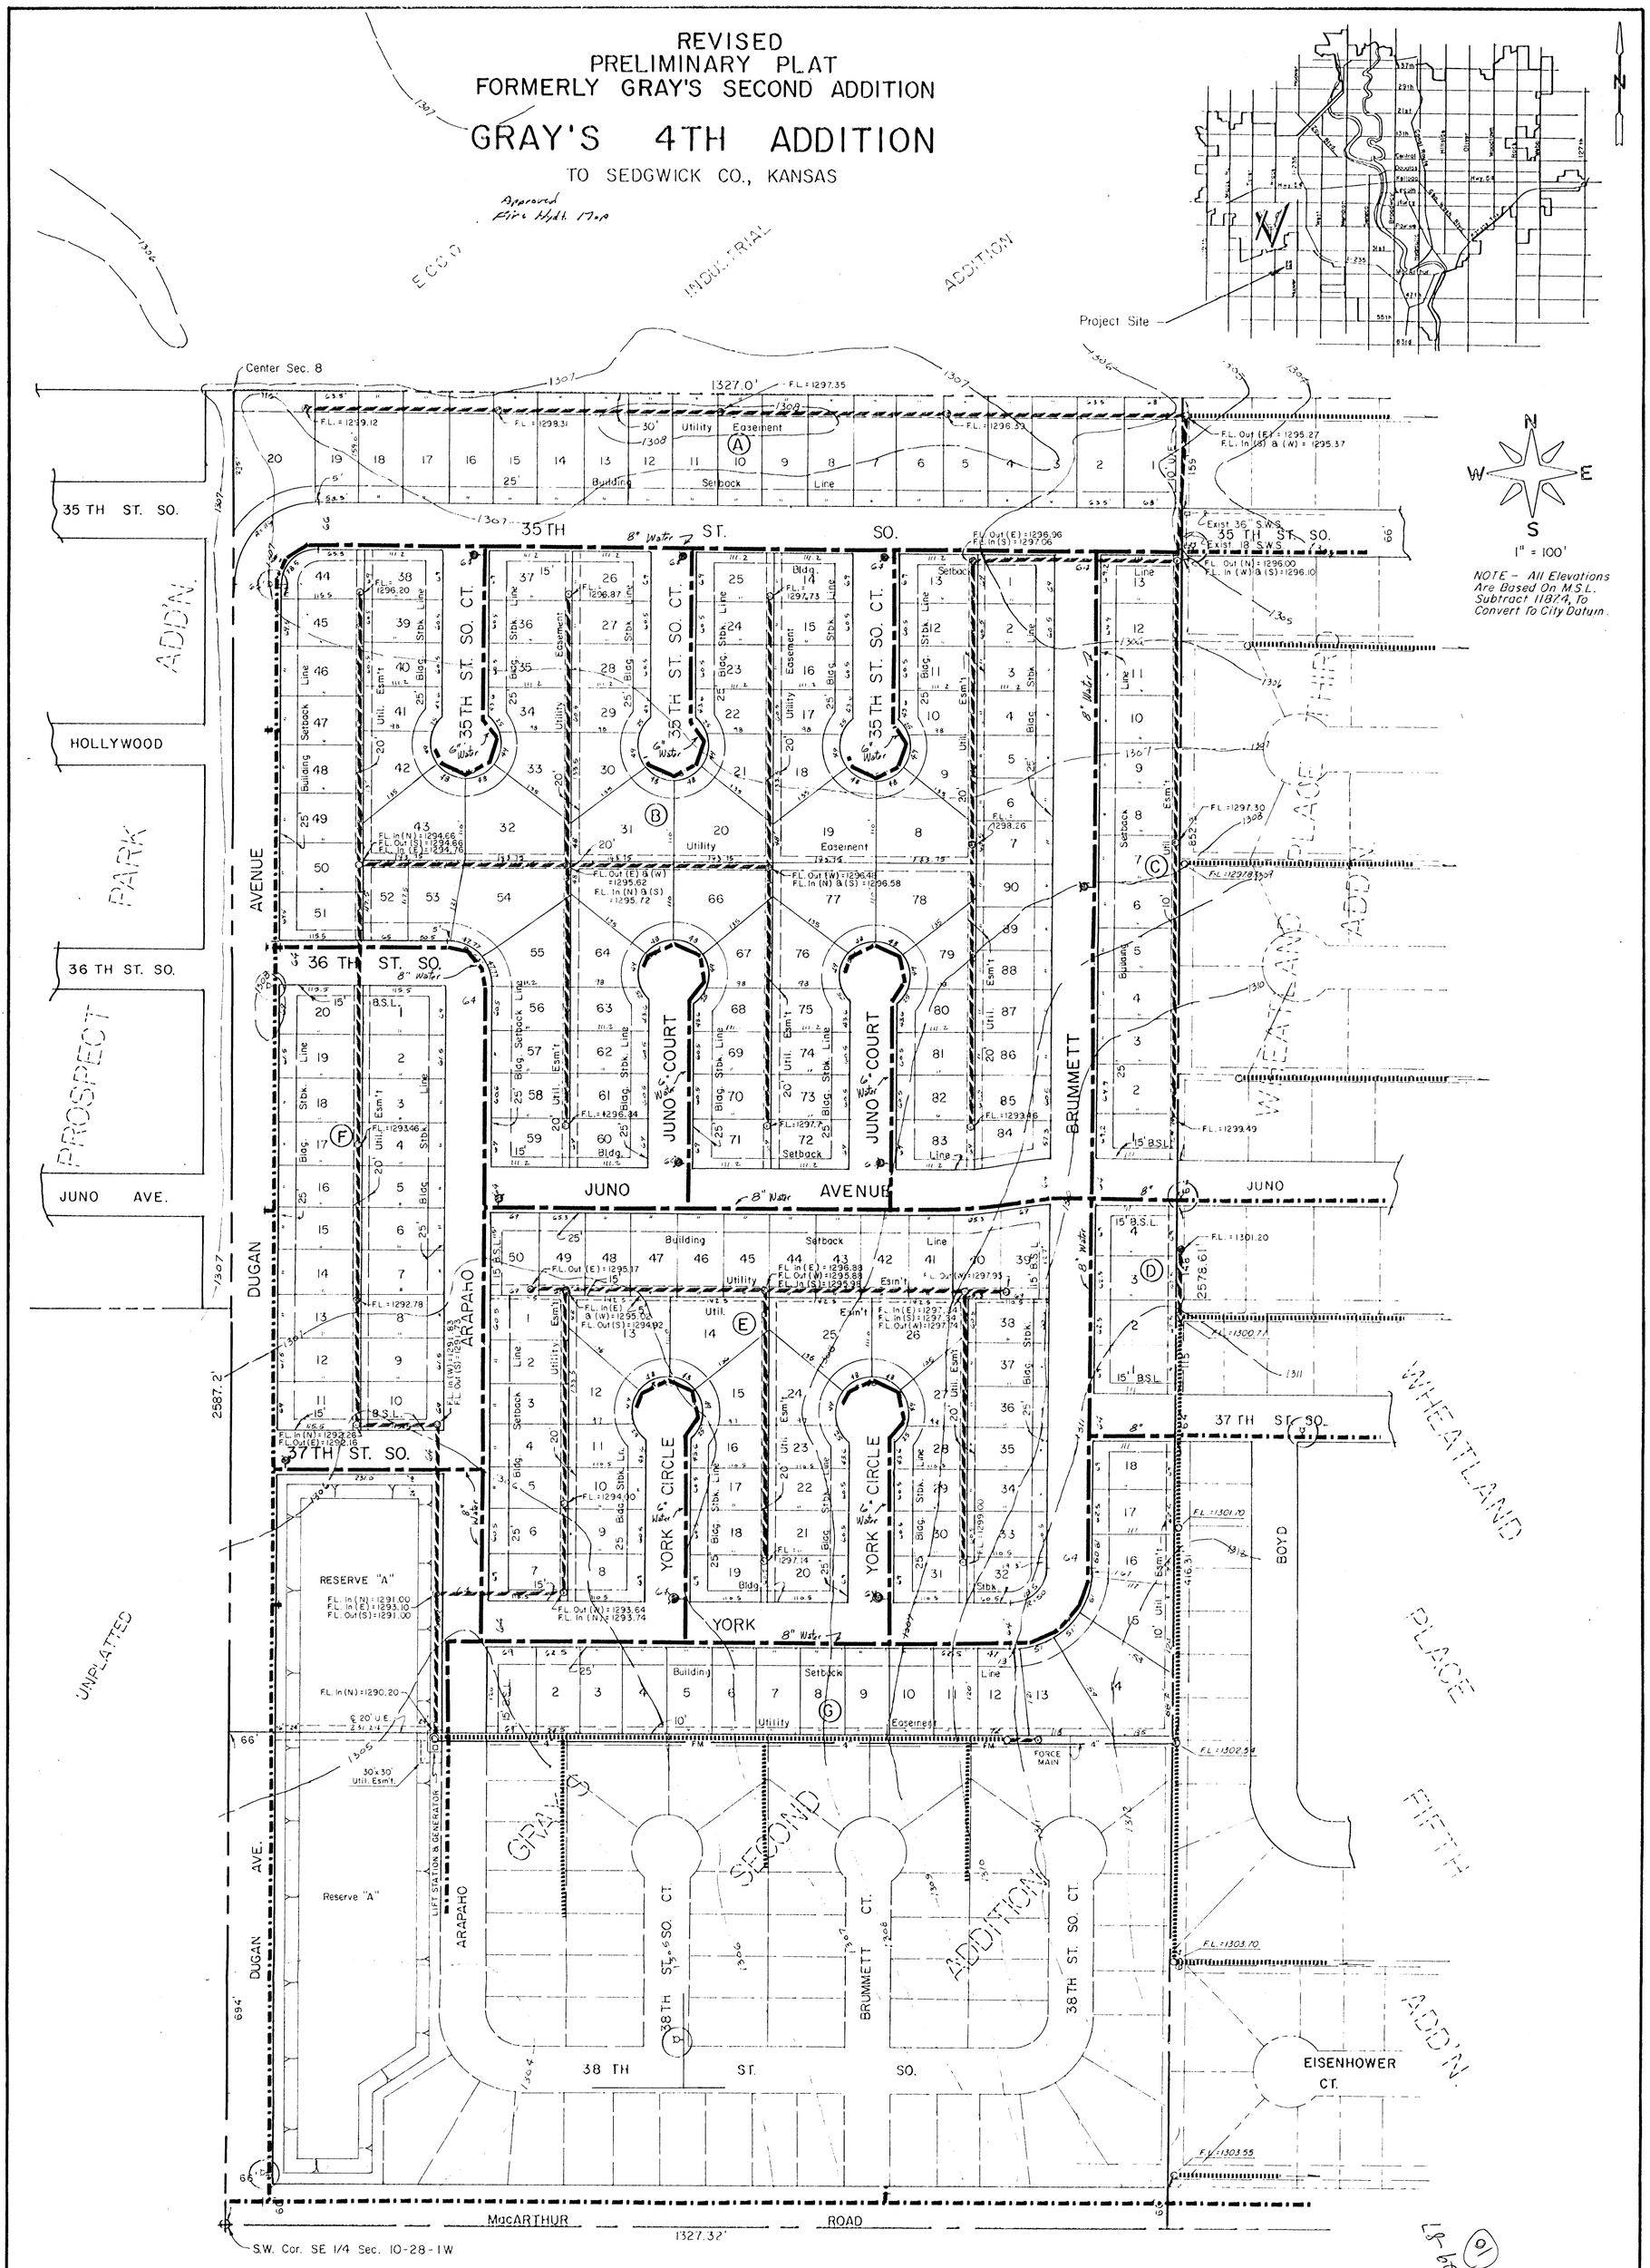

LEGEND

- = Existing Sewer
- = Proposed Sewer
- = Existing Water
- = Proposed Water

LEGAL DESCRIPTION

West 1/2 of SE 1/4 of Sec. 10-28-1W,
Except the South 694' Thereof.

WATER & SEWER PLAN

MOEHRING & ASSOCIATES
CONSULTING ENGINEERS
WICHITA

Revised 11/11/87