PRELIMINARY PLAT

FOR THE REPLAT OF LOT 2
NORTH OLIVER INDUSTRIAL PARK ADDITION
SEDGWICK COUNTY, KANSAS

MAY 1, 1980

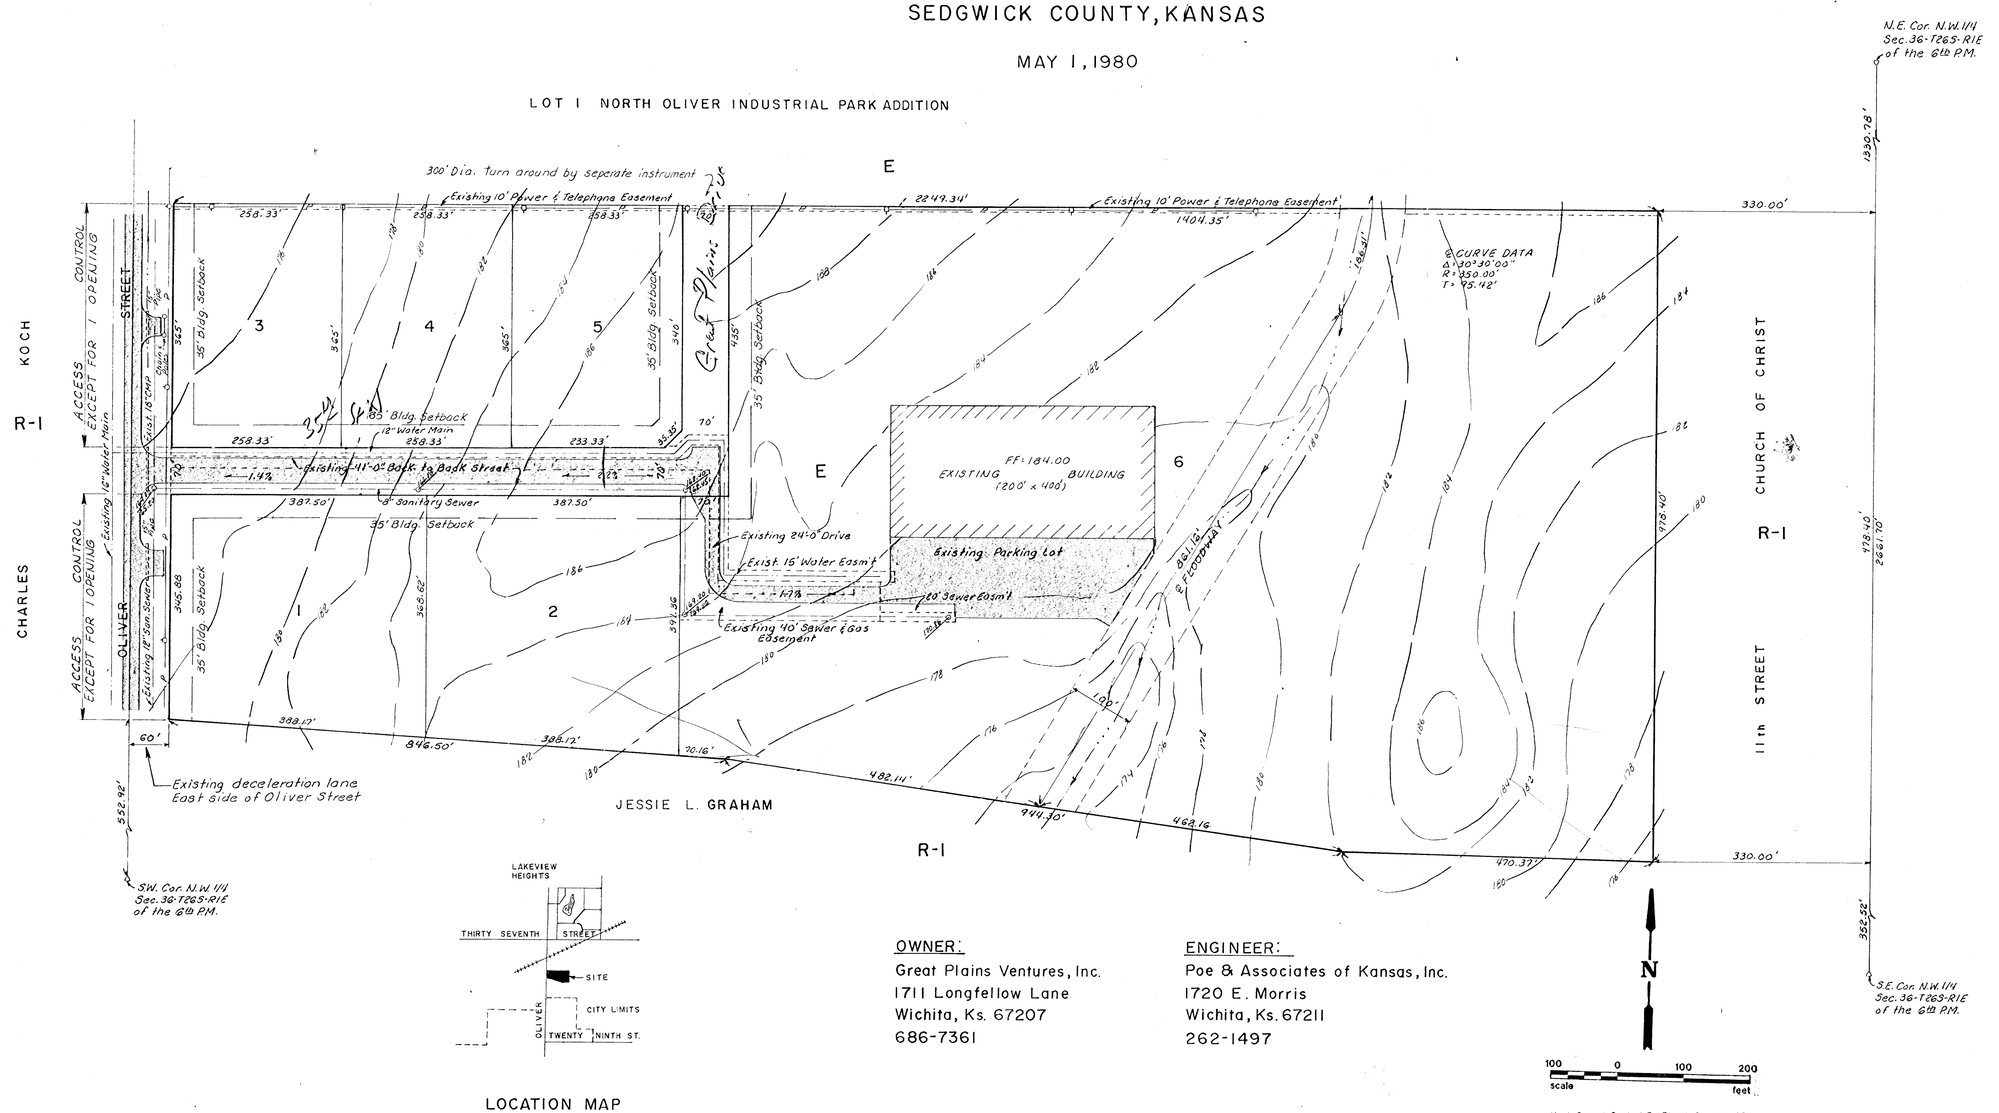

LOCATION MAP

OWNER:
Great Plains Ventures, Inc.
1711 Longfellow Lane
Wichita, Ks. 67207
686-7361

ENGINEER:
Poe & Associates of Kansas, Inc.
1720 E. Morris
Wichita, Ks. 67211
262-1497

B.M. (City Datum) "□" Cut on S.W. Cor. of East Hdwl. of R.C.B. culvert crossing Oliver about 133' South of ℄ Railroad track Elev. 177.50