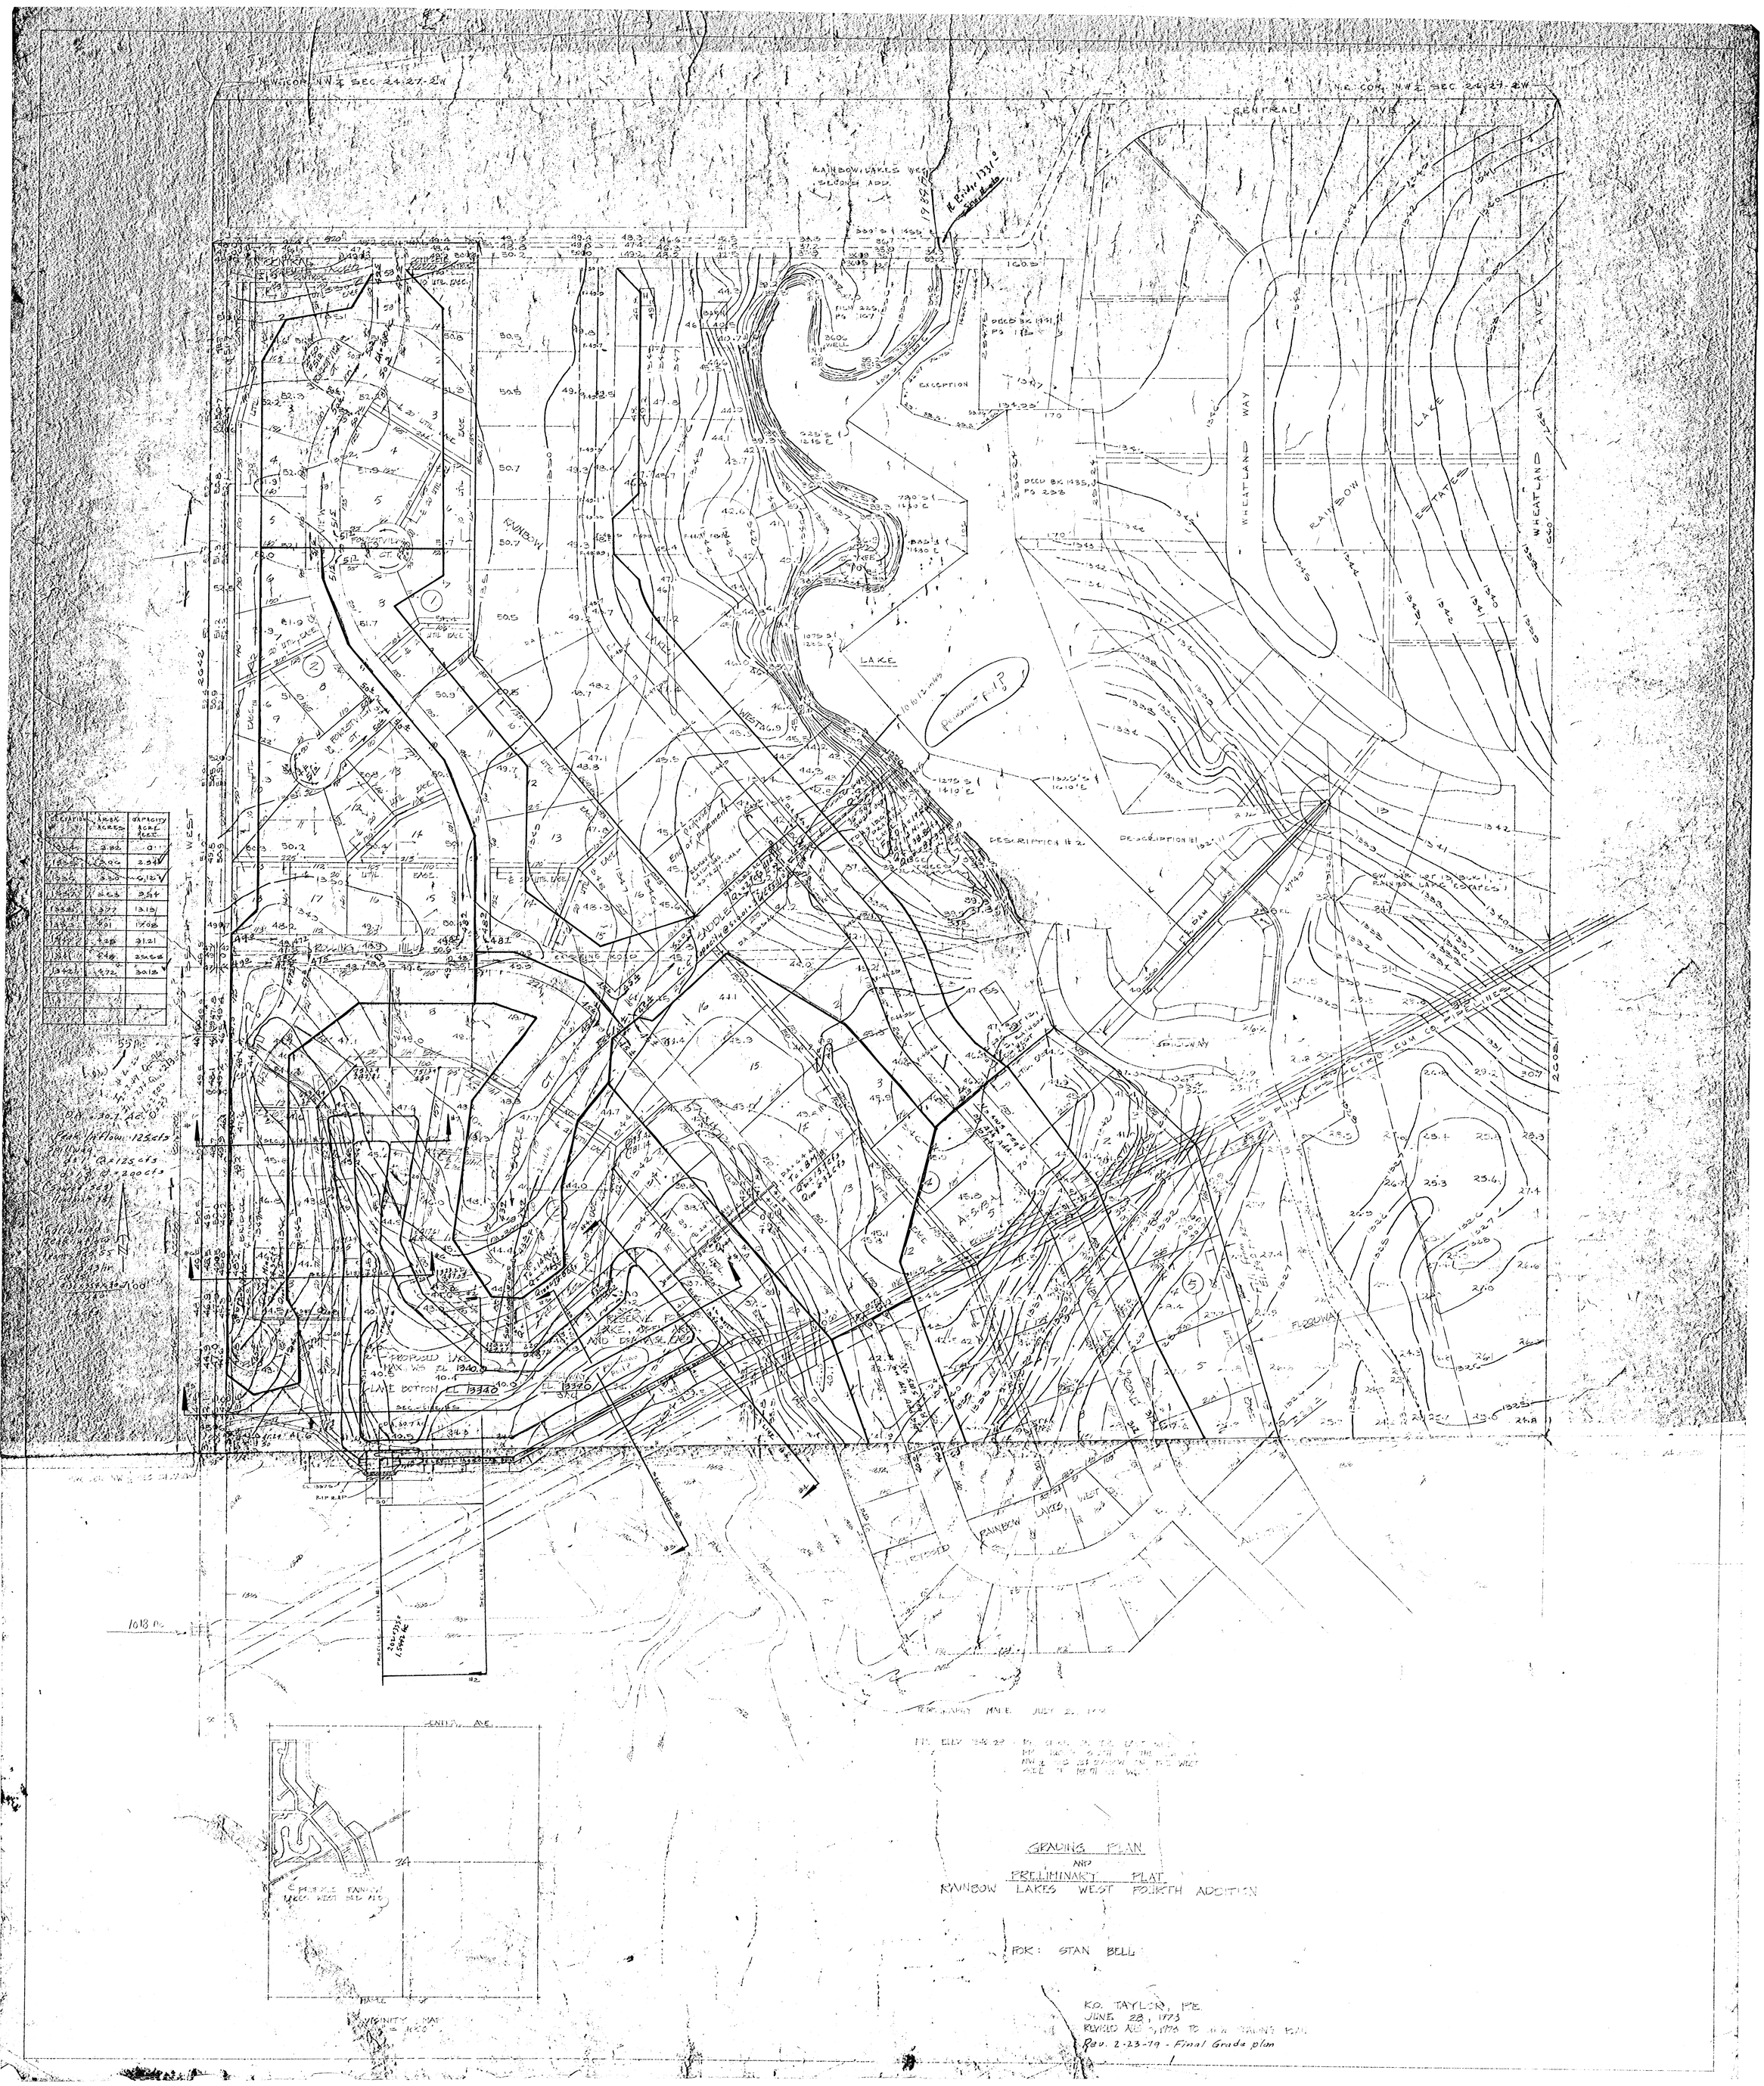
N.W. COR. NW¼ SEC 24-27-2W
N.E. COR. NW¼ SEC 24-27-2W
CENTRAL AVE
RAINBOW LAKES WEST SECOND ADD.
WHEATLAND WAY
RAINBOW LAKE ESTATES
WHEATLAND AVE
LAKE
EXCEPTION
DESCRIPTION #2
DESCRIPTION #1
SPILLWAY
FLOODWAY
RAINBOW LAKES WEST
PROPOSED LAKE
MAX. WS EL 1340.0
LAKE BOTTOM EL 1330.0
RESERVE FOR LAKE DEVELOPMENT AND DRAINAGE
RIP RAP
SEC. LINE
PROPERTY LINE
1018 Ac
CENTRAL AVE
VICINITY MAP
GRADING PLAN
AND
PRELIMINARY PLAT
RAINBOW LAKES WEST FOURTH ADDITION
FOR: STAN BELL
K.O. TAYLOR, P.E.
JUNE 28, 1973
REVISED AUG 3, 1973 TO
Rev. 2-23-79 - Final Grade plan