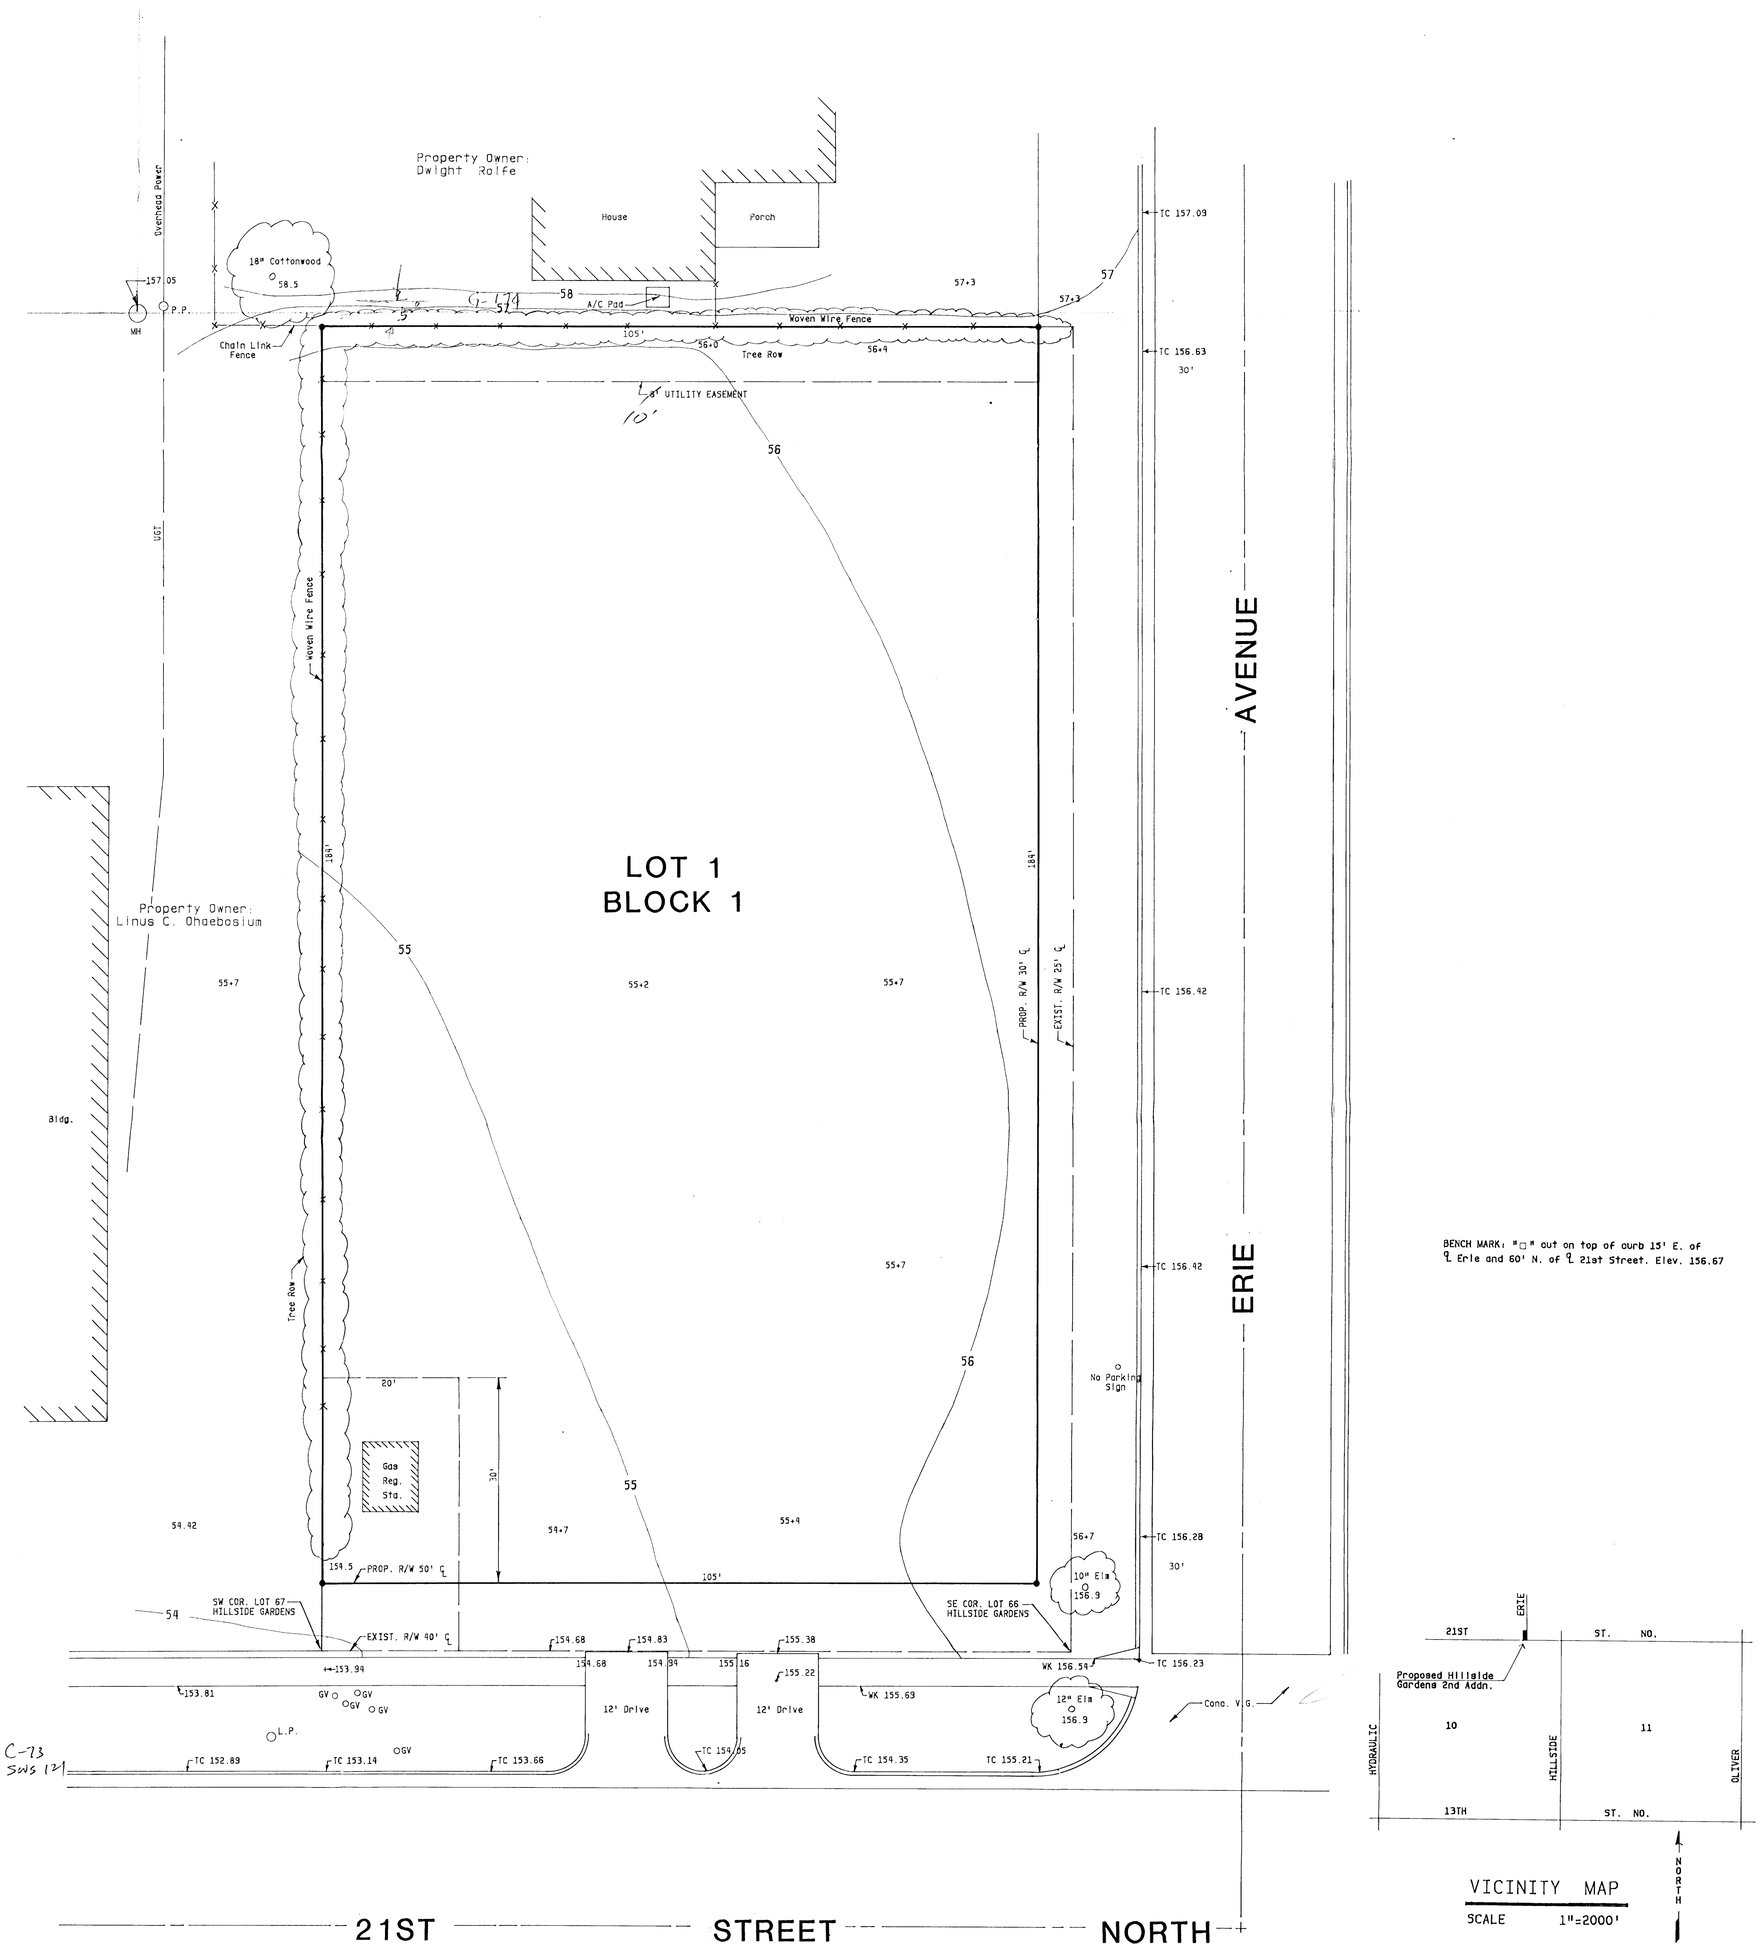

PRELIMINARY PLAT

HILLSIDE GARDENS 2ND ADDITION
TO
WICHITA, SEDGWICK COUNTY, KANSAS

POE & ASSOCIATES OF KANSAS INC.
CONSULTING ENGINEERS
434 N. Oliver, Suite 110 • Wichita, KS 67208 • 316/685-4114