

CHISHOLM CREEK PARK

PRELIMINARY PLAT

HINKLE ADDITION


LEGAL DESC.- THE WEST 550' OF THE SOUTH 970' OF THE SOUTH HALF OF THE S.E. 14 OF SECTION 36, T26S, R1E, 6TH P.M.

1" = 50'
Date: April 1989

Min. pad line
all over 1553.6

OWNER: J.R. BARNES

S.W. cor. S.E. 1/4 Sec. 36
T26S - R1E

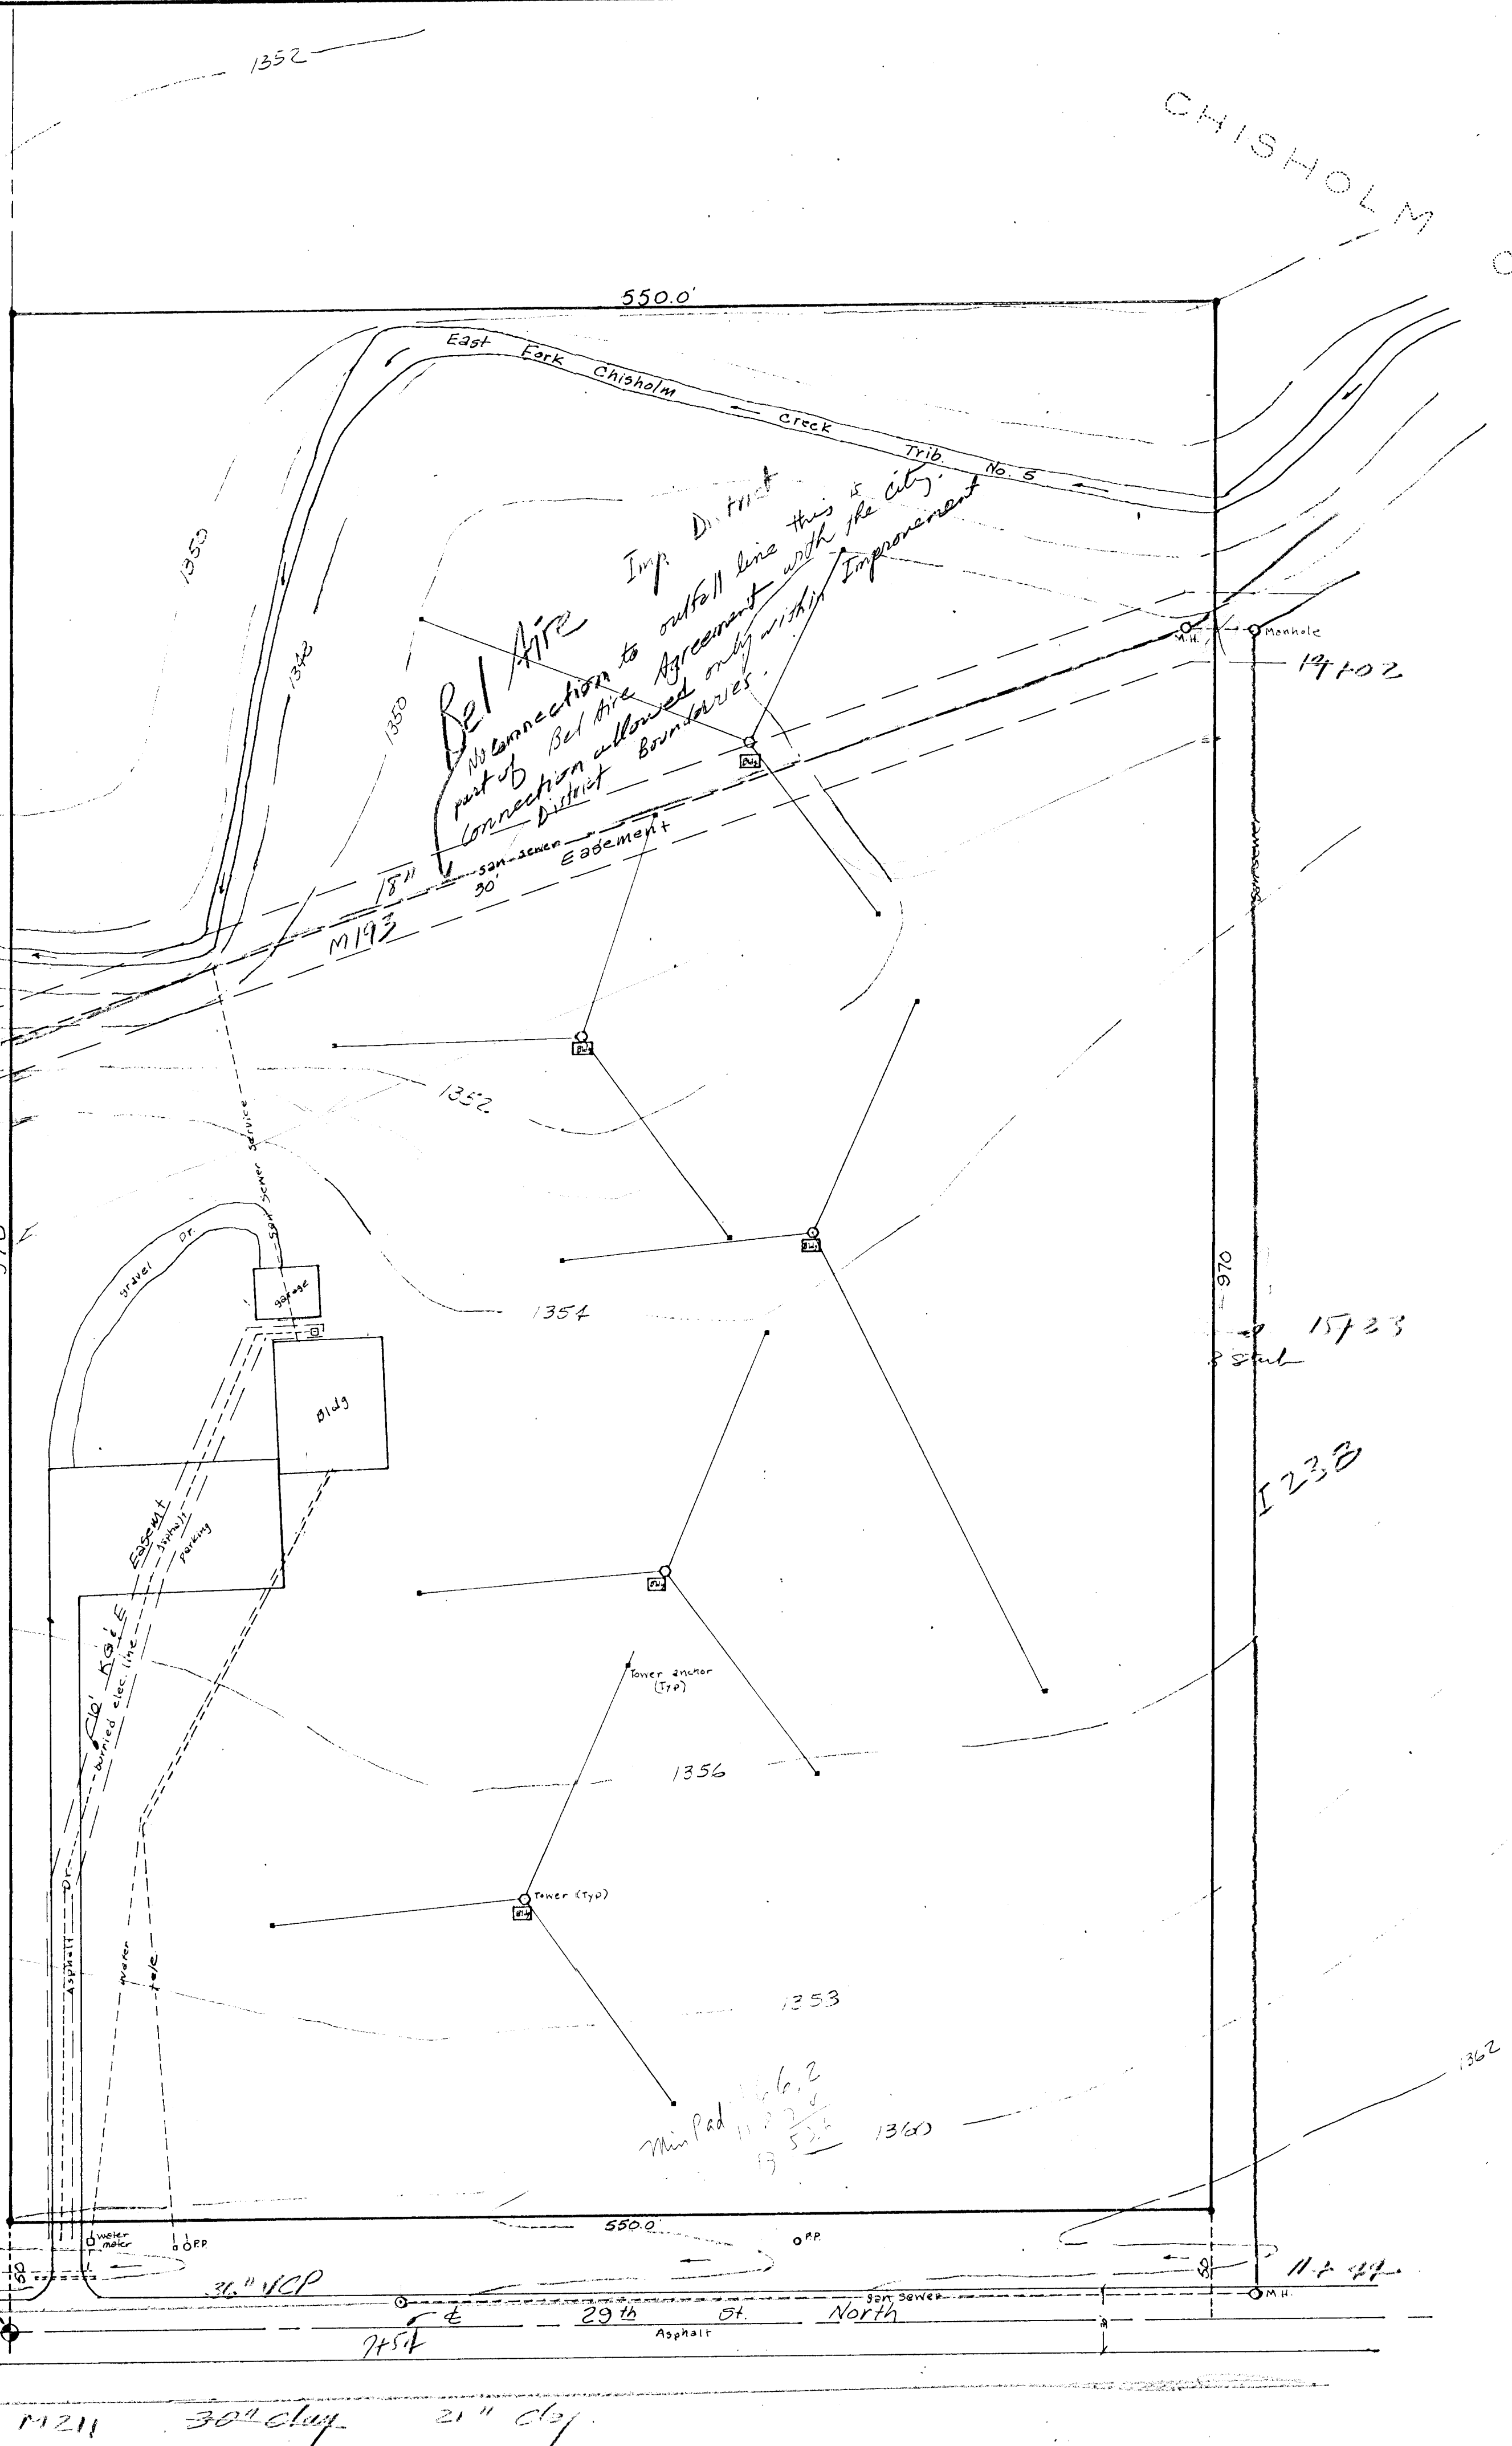


M 211
233

15723
I 233B

Min. Pad 156.2
15723
52.2
13

VICINITY MAP

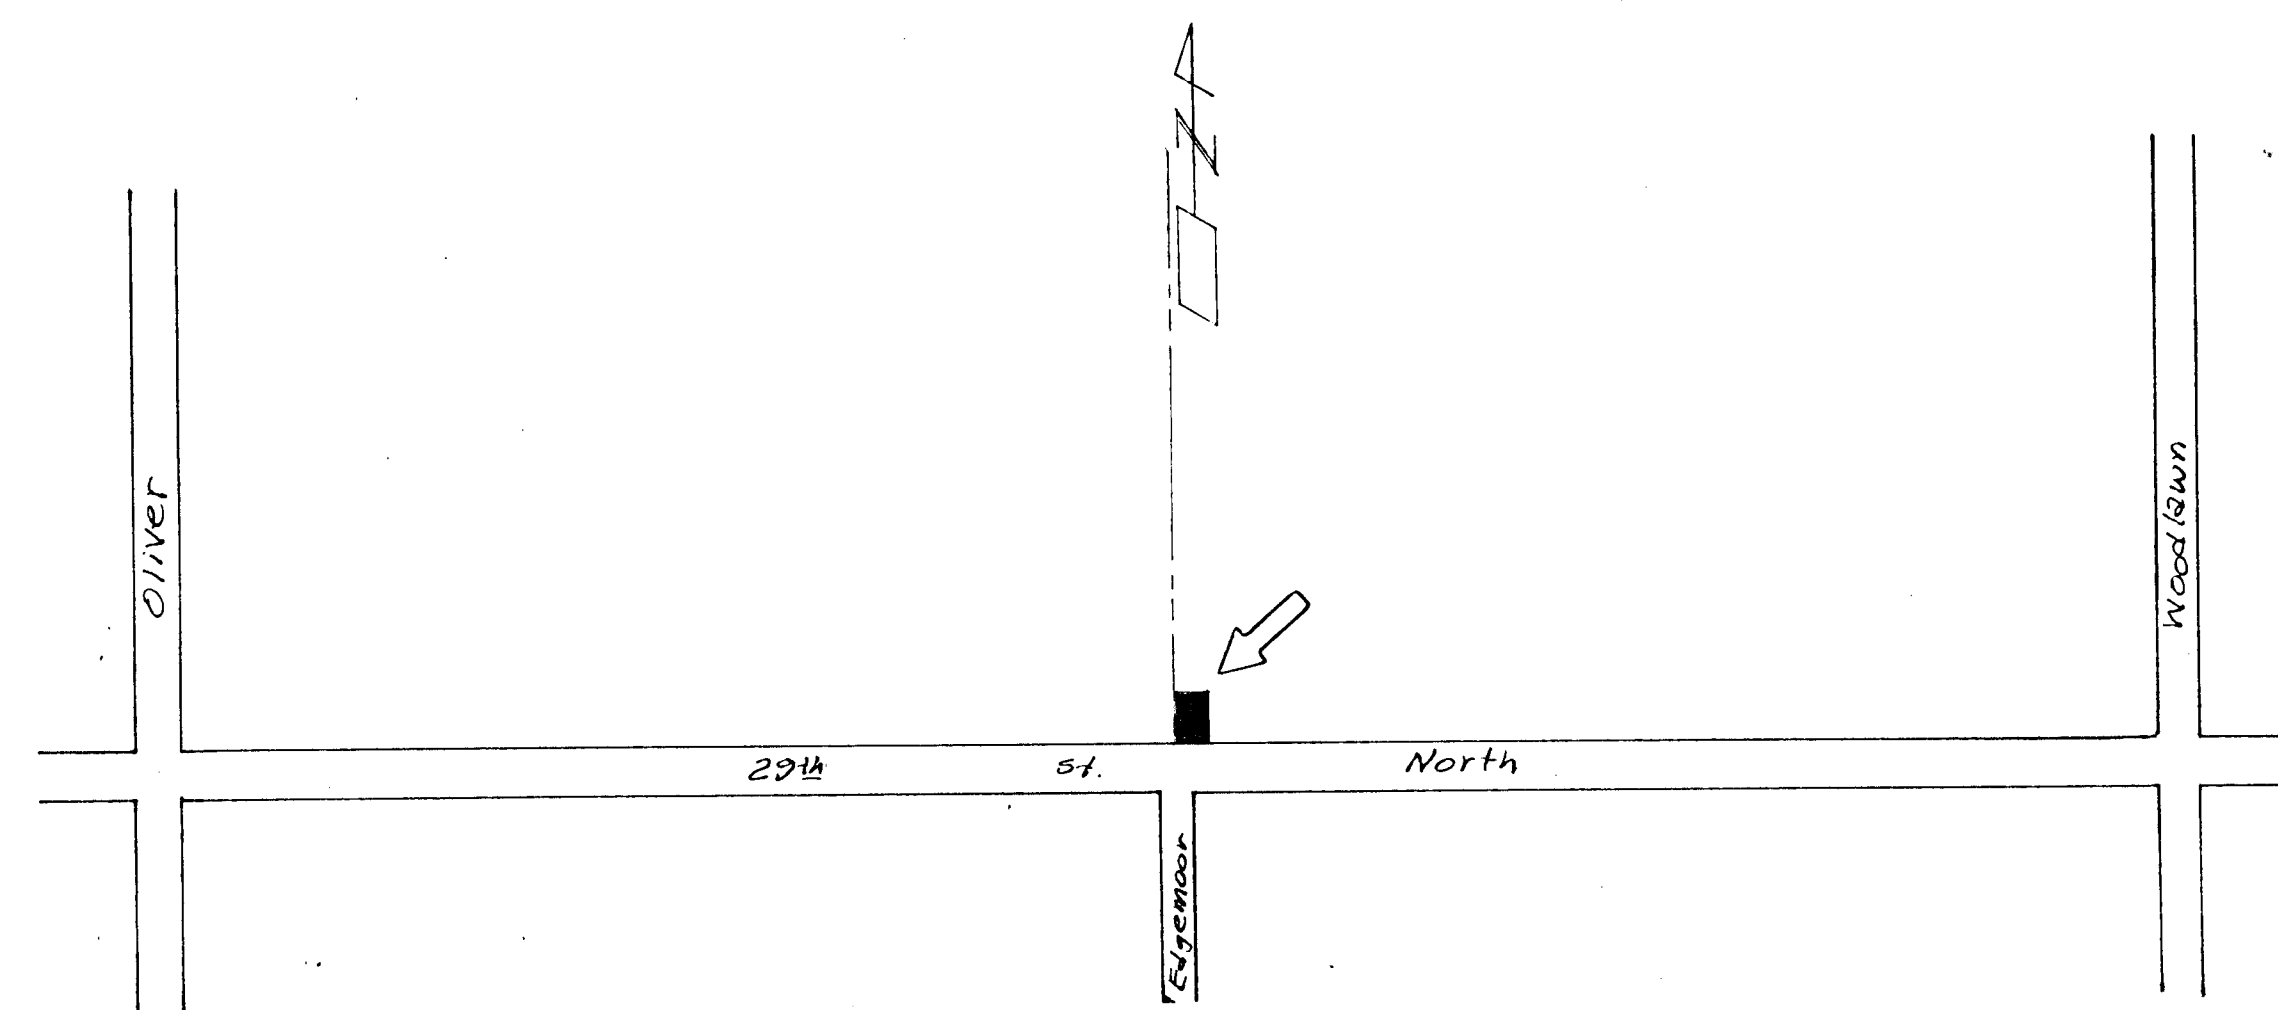

Armstrong Land Survey, P.A.
DONN C. ARMSTRONG, R.L.S.



1021 E. WATERMAN
SLIDE 4
WICHITA, KS 67211
1-316-263-0882