


ROAD

TYLER

15" C.I. WATER

Access Control Except 2 Openings

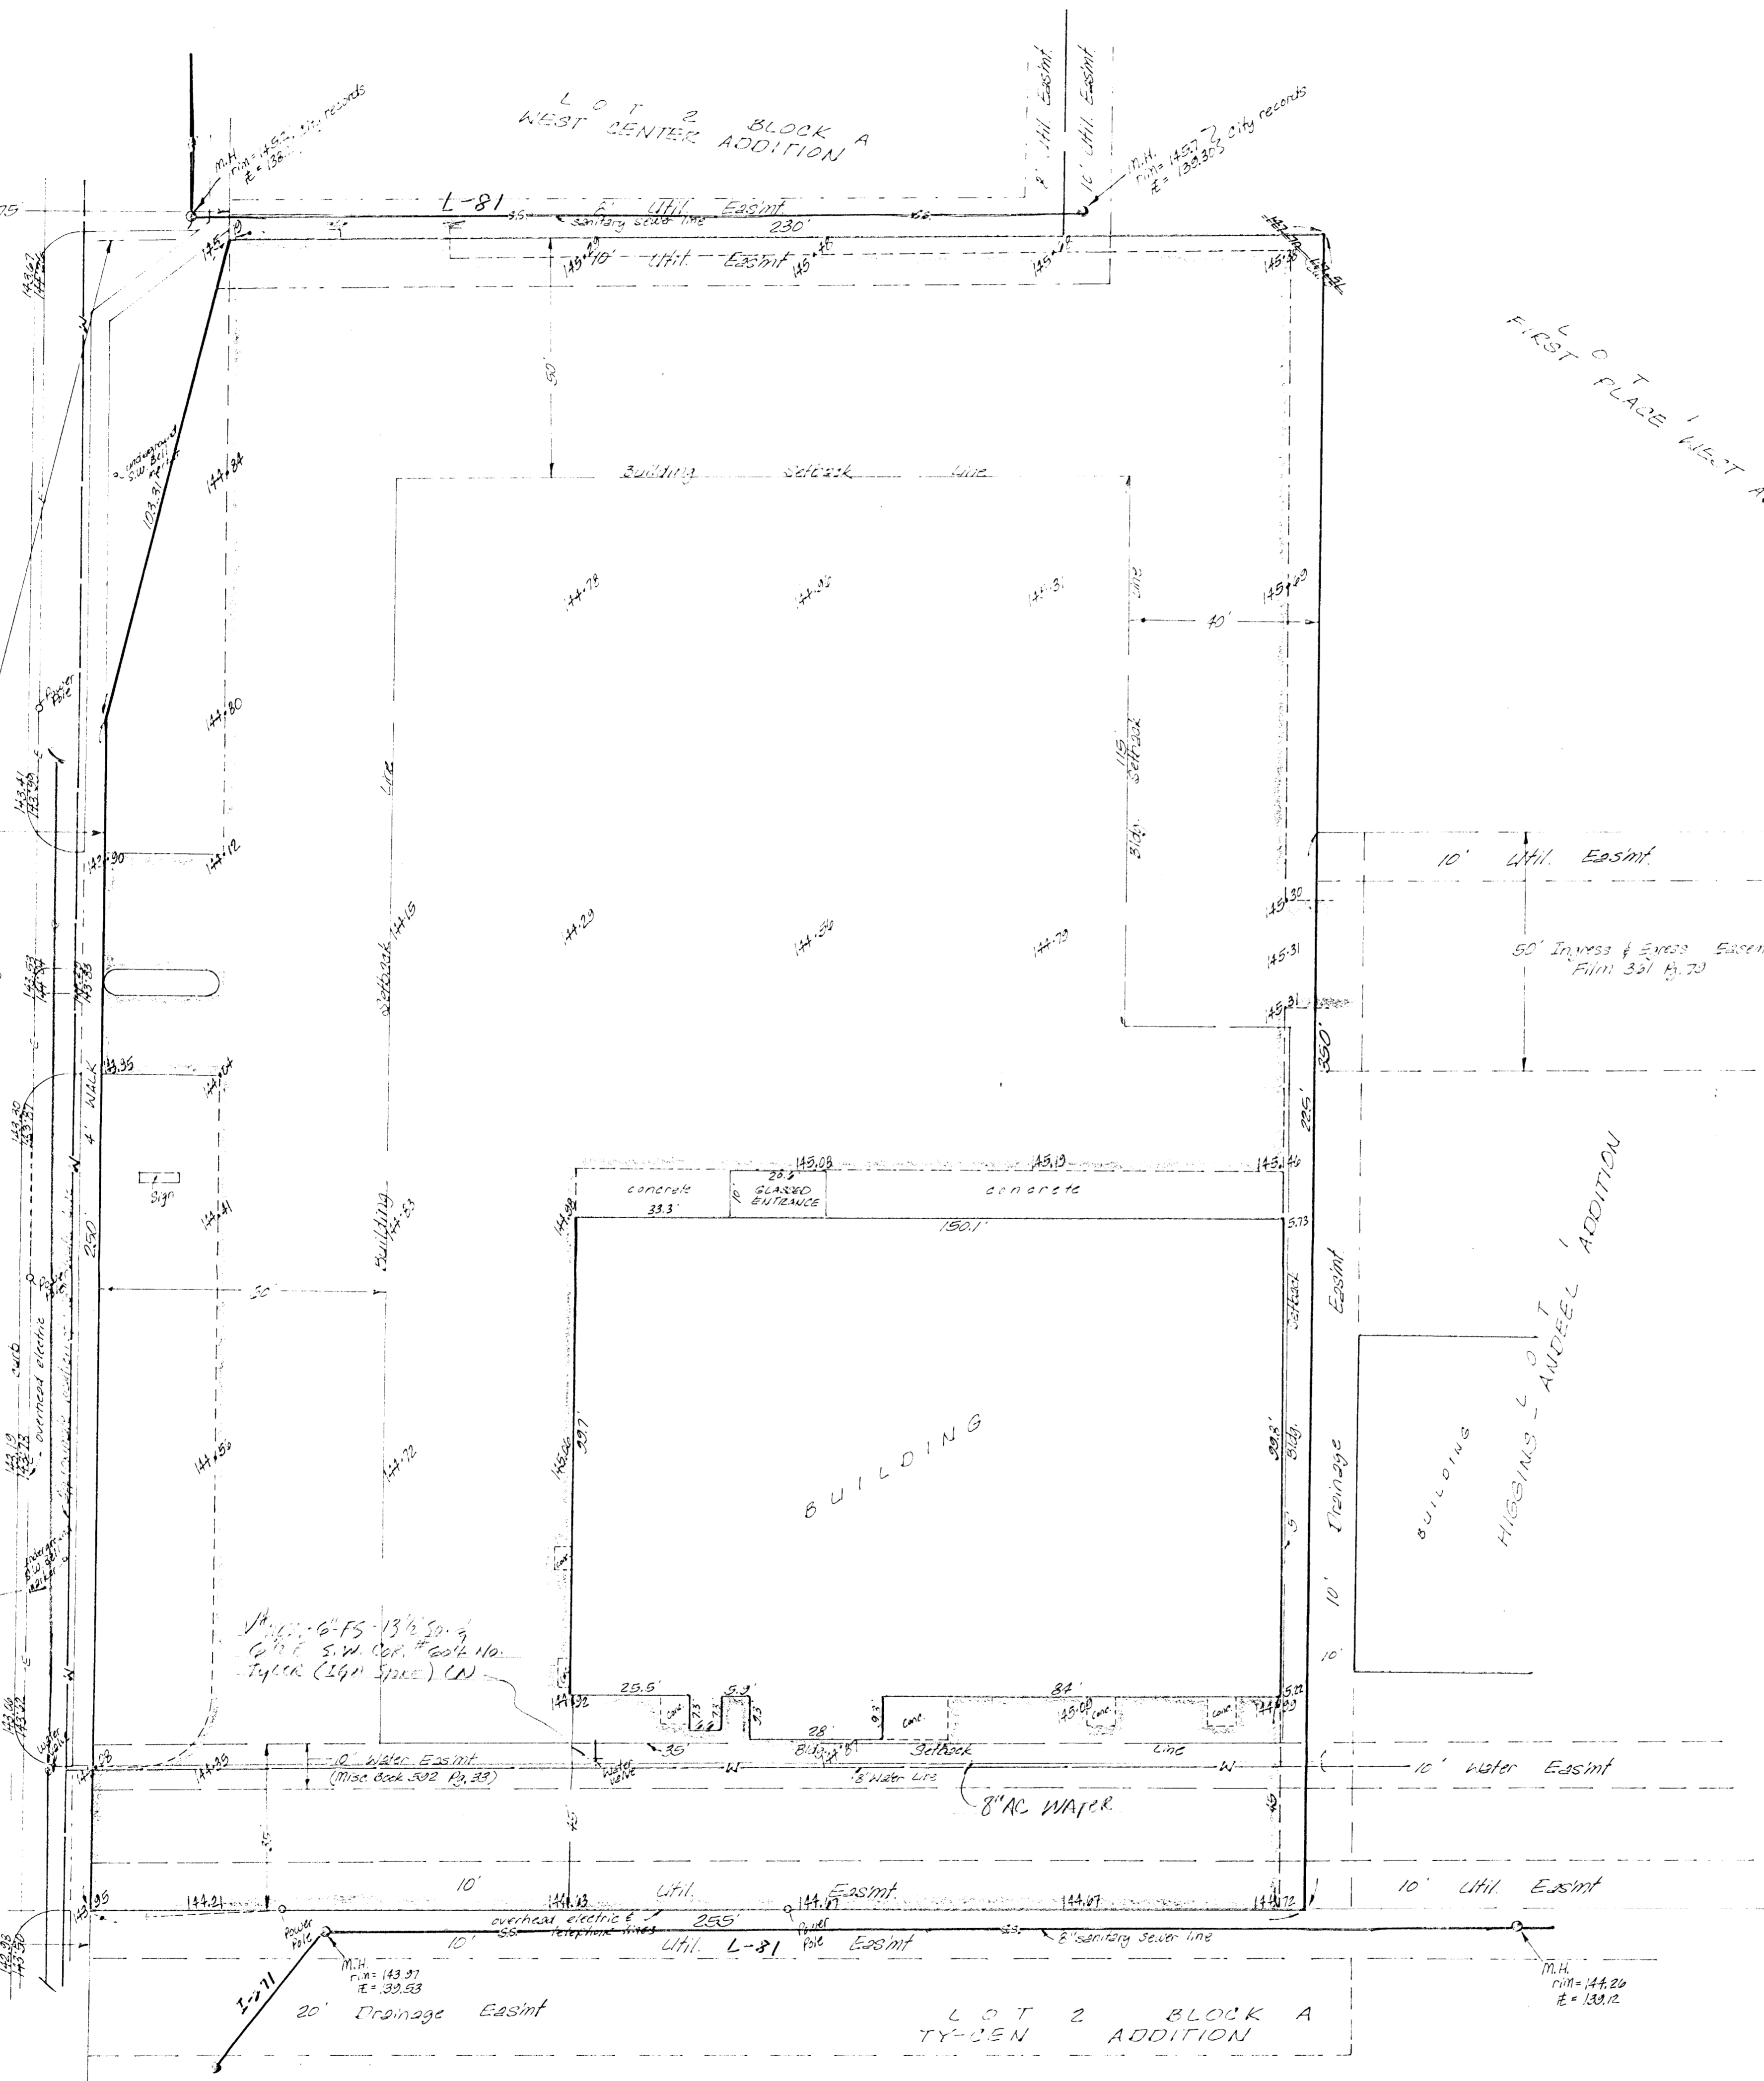

FIRST PLACE WEST ADDITION




Bench mark:
 City disc. 54.2 feet north &
 38 feet west of centerlines
 of Tyler and Central.
 Elevation = 143.30 City Datum

**SKETCH PLAT
 HATTRUP ADDITION**

Part of Lot 1, Block A, West Center Addition
 to Wichita, Sedgwick County, Kansas

OWNER: RICHARD J. HATTRUP