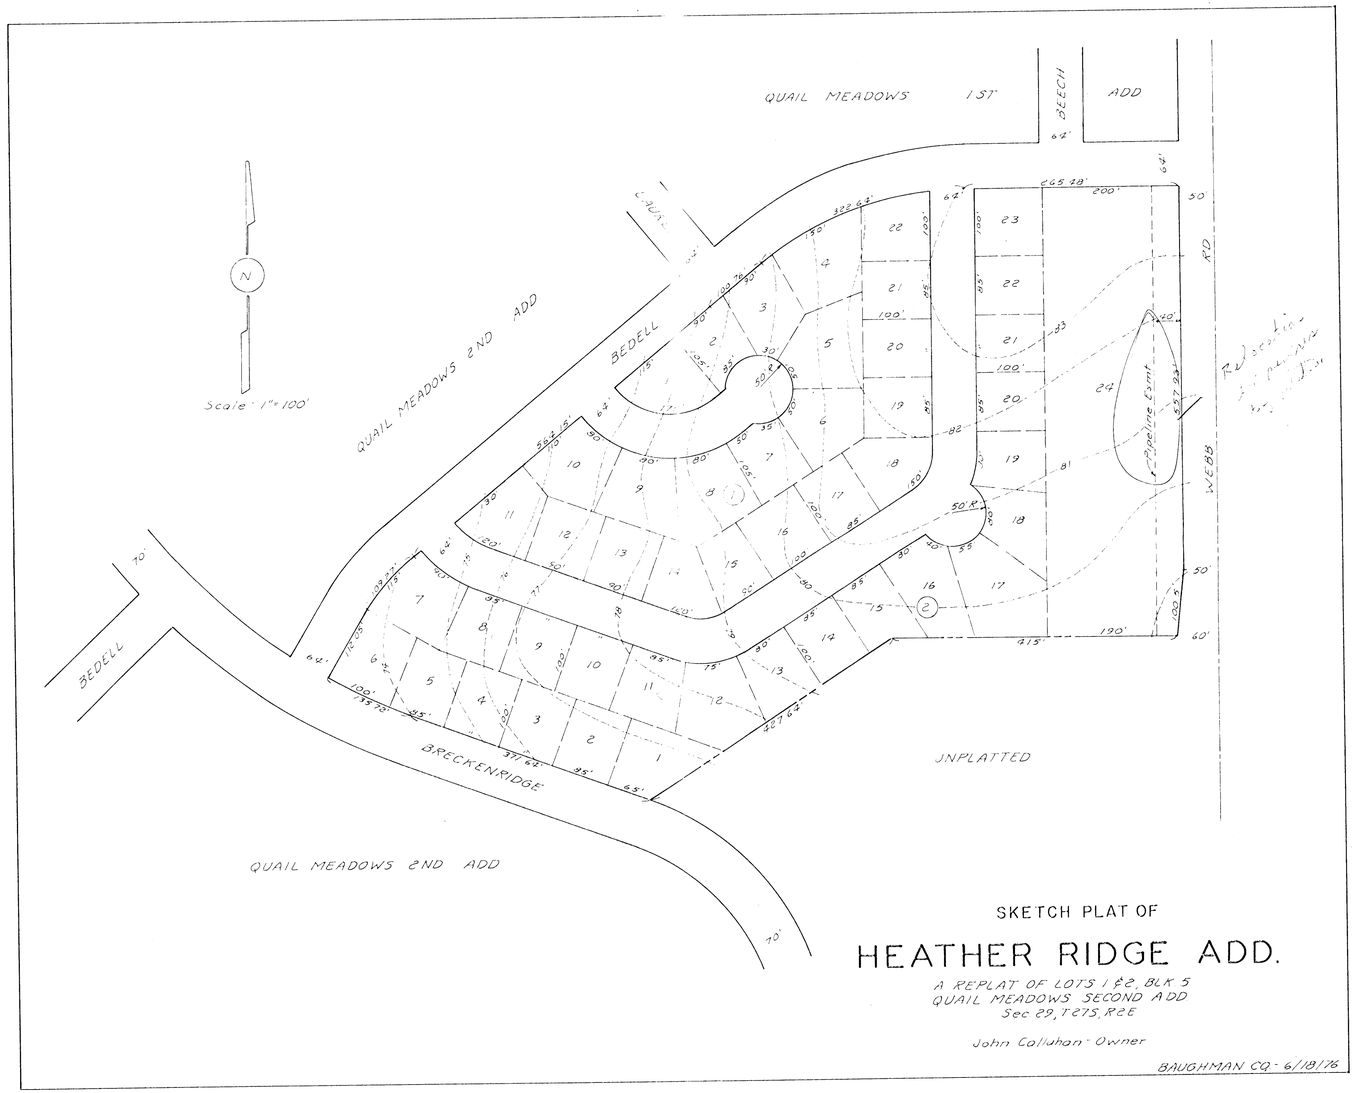
QUAIL MEADOWS 1ST
BEECH
ADD
QUAIL MEADOWS 2ND ADD
BEDELL
Scale: 1" = 100'
N
WEBB
RD
Pipeline Easmt
BRECKENRIDGE
UNPLATTED
QUAIL MEADOWS 2ND ADD
SKETCH PLAT OF
HEATHER RIDGE ADD.
A REPLAT OF LOTS 1 & 2, BLK 5
QUAIL MEADOWS SECOND ADD
Sec 29, T27S, R2E
John Colluhan - Owner
BAUGHMAN CO - 6/18/76