


Note: Lots to drain to streets via drives, flumes, inlets or other approved methods.

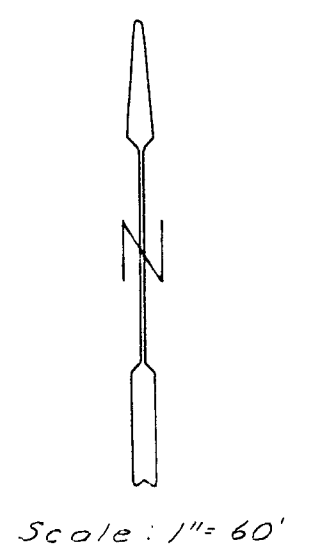

Scale: 1" = 60'
 B.M. 10" cut SE return T.C.
 SE cor. Shade & Par
 E.I. 196.35
 137.72

This is inconsistent w/ SWS 116 plan. Contour elevations seem to be in error.

DRAINAGE PLAN
 PRELIMINARY PLAT

FARMINGTON SQUARE 2ND ADDITION

A REPLAT OF PART OF LOT 4, BLK. 3, FARMINGTON SQUARE

OWNER - DANIEL M. CARNEY

Revised plan w. corrected elevations requested
 11/1/80