1-Type I W=5'10"; 1-Type I W=8'4"; 5-Type I W=3'10"; 7 Pipe Plugs; 89 L.F. Pipe Removed; 98.4 L.F. 15" R.C.P.; 264.2 L.F. 18" R.C.P.

BM 1680.55 "8" cut top W ob S and R Hillside & Shadybrook

Scale: 1"=20'

NOTE: Contact Jr. Boyle, Traffic Eng. Div. City of Wichita at 268-4129, Prior to any Work of Est. R.O.W.

NOTE: Ramp Removed Paid for as S.Y. of Conc. Pavt. Removed.

Remove 36" Pipes as required
Plug remaining Pipes
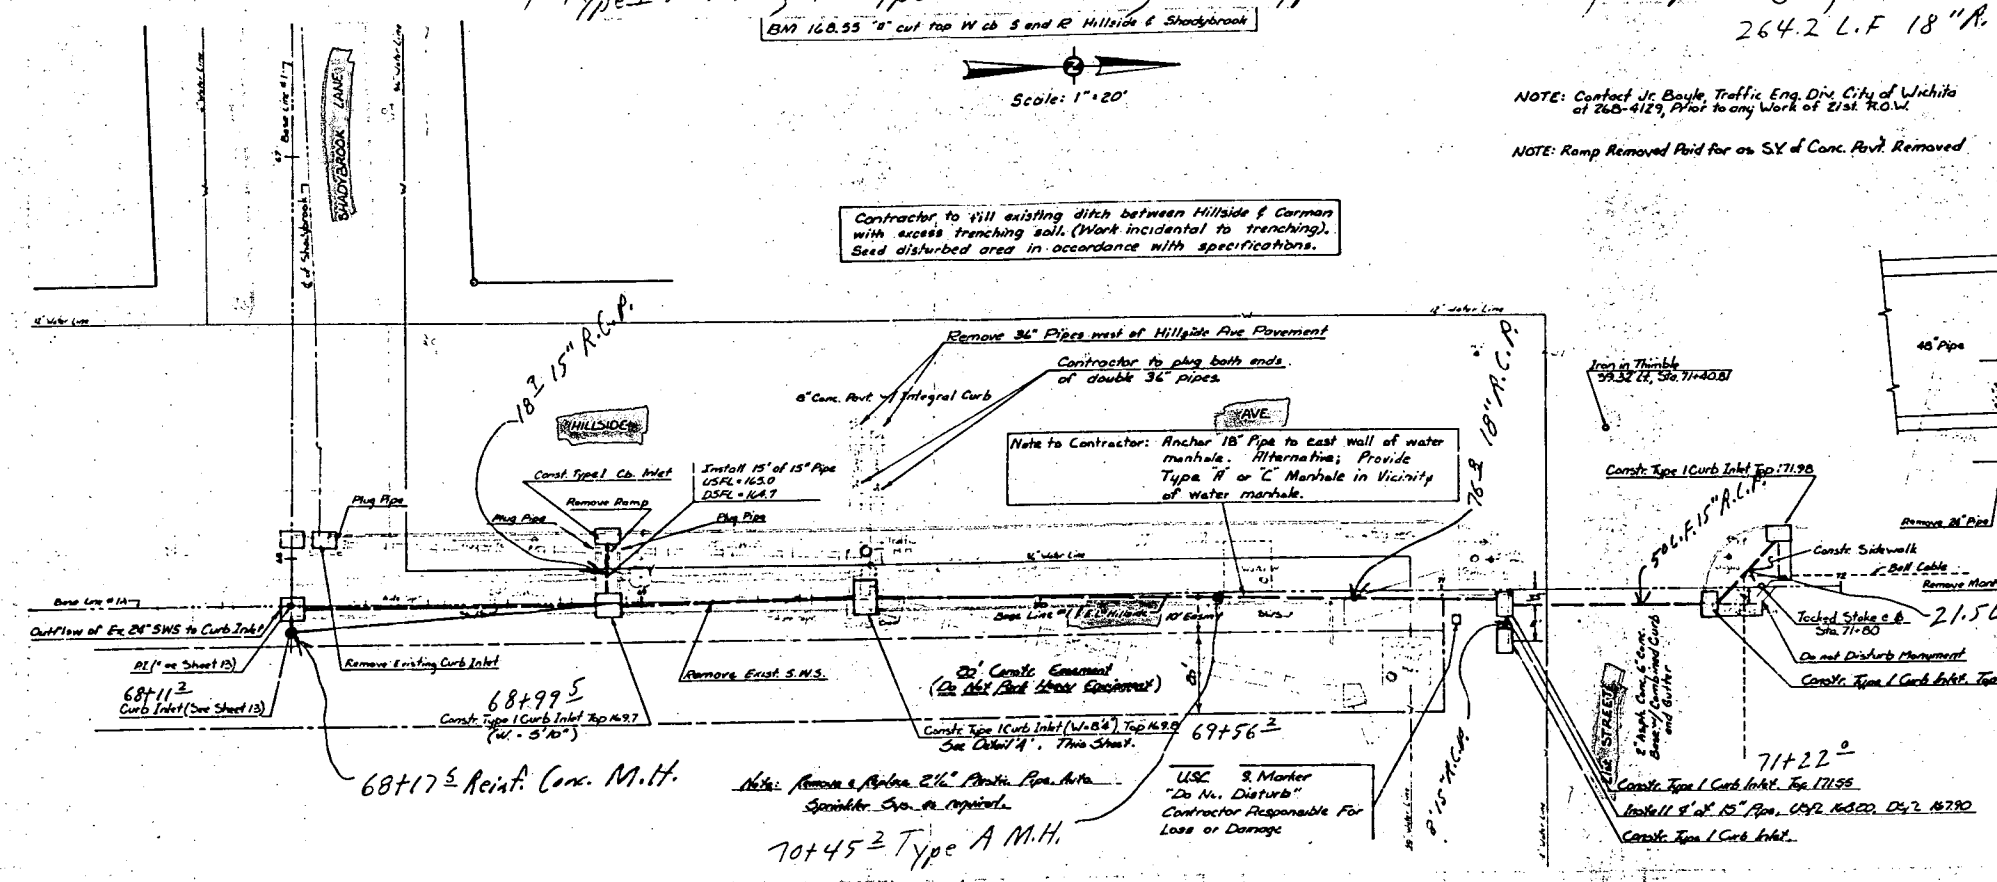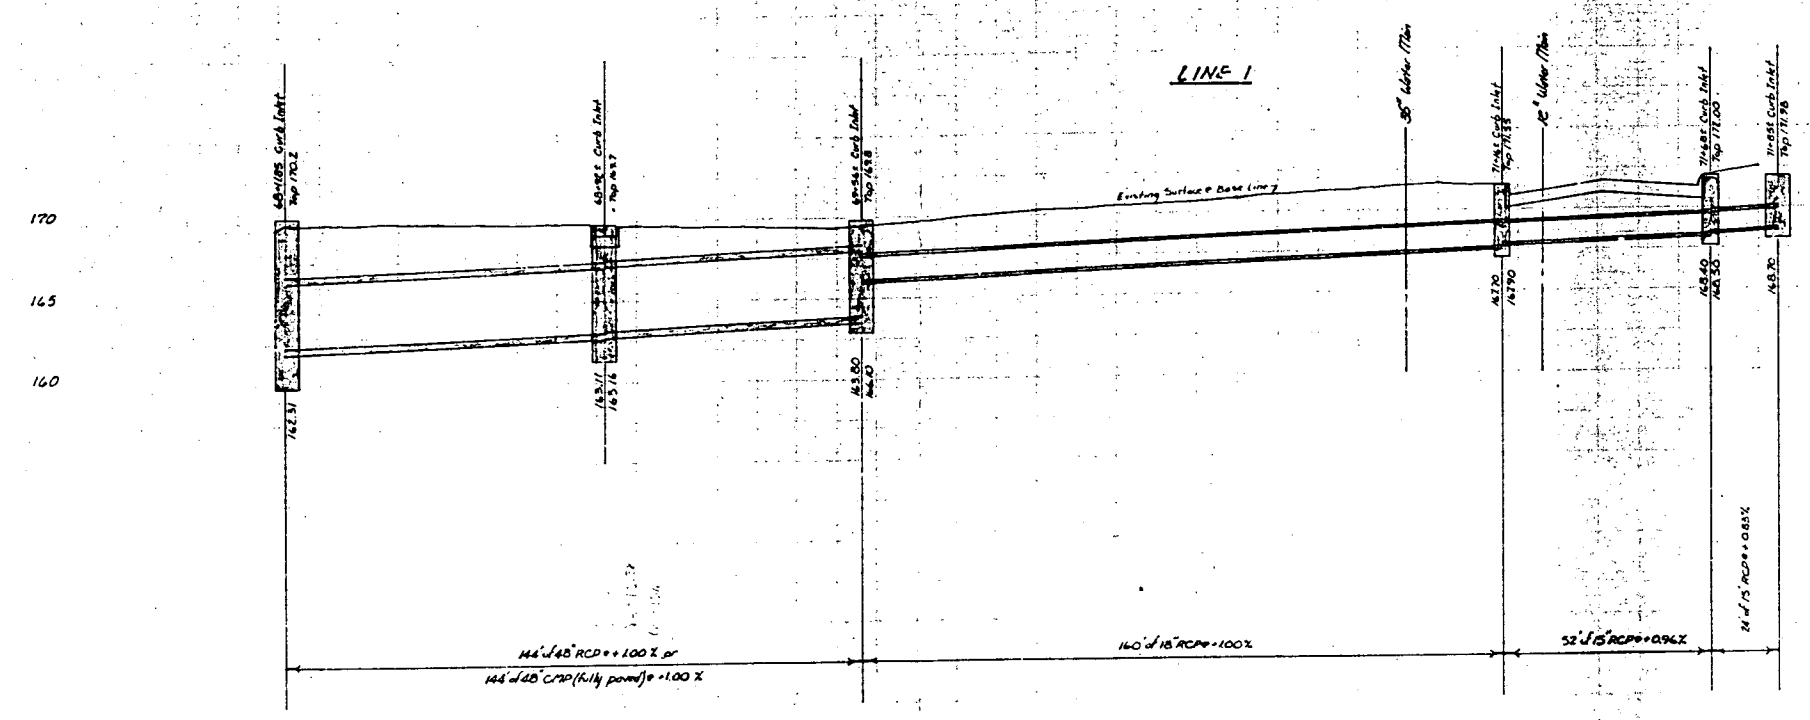
Contractor to fill existing ditch between Hillside & Carman with excess trenching soil. (Work incidental to trenching). Seed disturbed area in accordance with specifications.