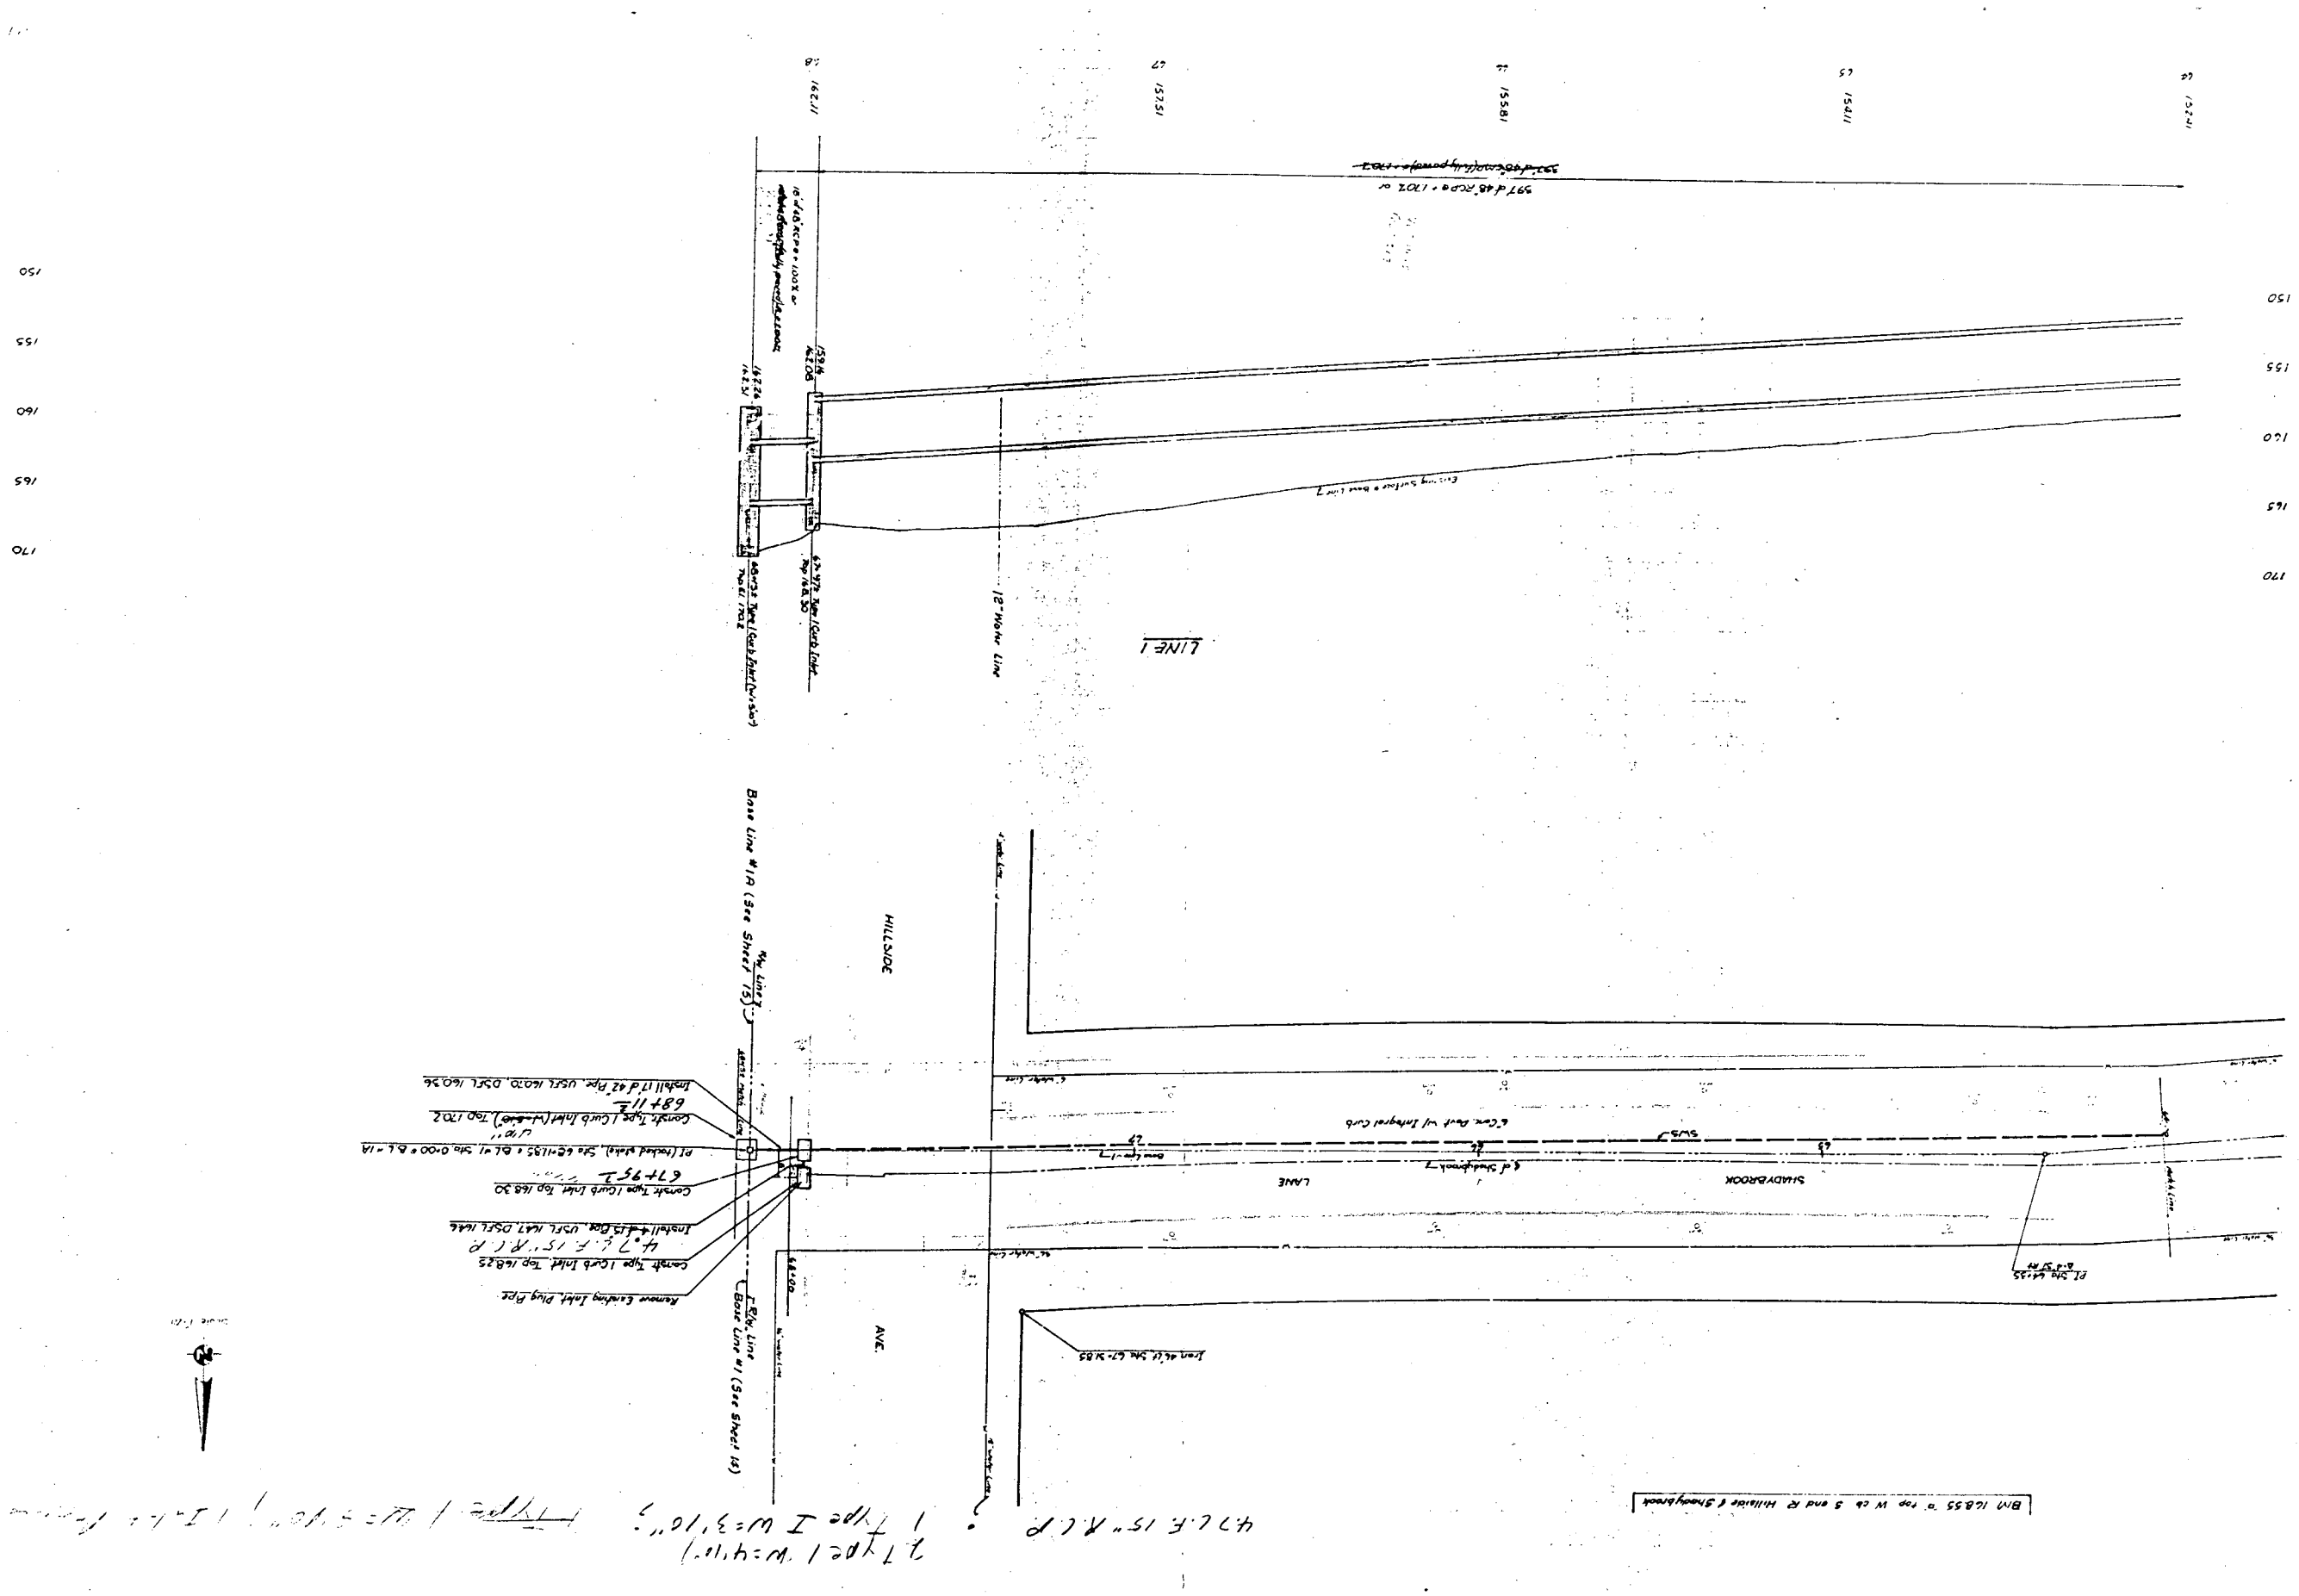
Remove Existing Inlet Plug Pipe
Construct Type I Curb Inlet Top 16825
Install 4-15" RCP USCL 1647 OSCL 1646
Construct Type I Curb Inlet Top 16830
Construct Type I Curb Inlet (Modified) Top 17012
Base Line W/A (See Sheet 15)
Base Line W/A (See Sheet 14)
HILLSIDE
AVE.
SHADYBROOK
LANE
Curb Back of Sidewalk
Existing Surface Base Line
LINE 1
BM 16855 To top W cb S end of Hillside & Shadybrook
Type 1 W=4'10"
Type I W=3'10"
4" C.I.P. 15" R.C.P.