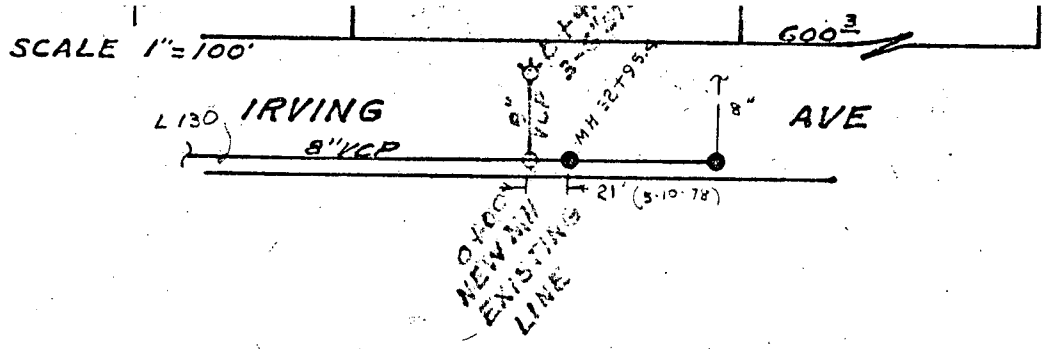

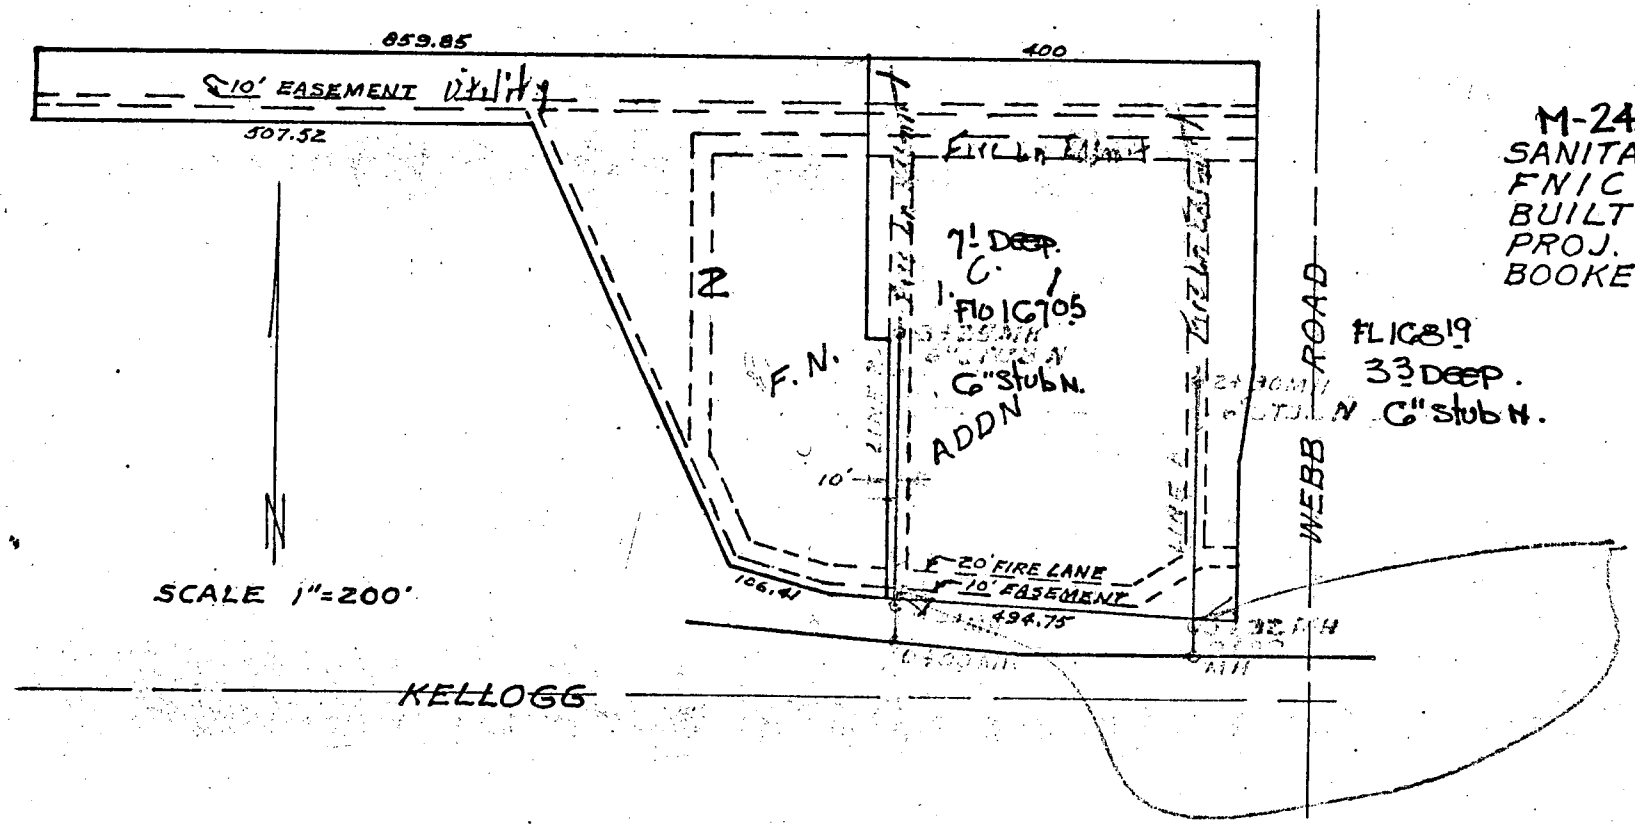

M-248.
SANITARY SEWER E
FNIC ADDN
BUILT BY: PRIVAT
PROJ. Nº DBKW703
BOOKED 11-23-74

City mai
at H