



PRELIMINARY PLAT OF

MARANATHA ADDITION

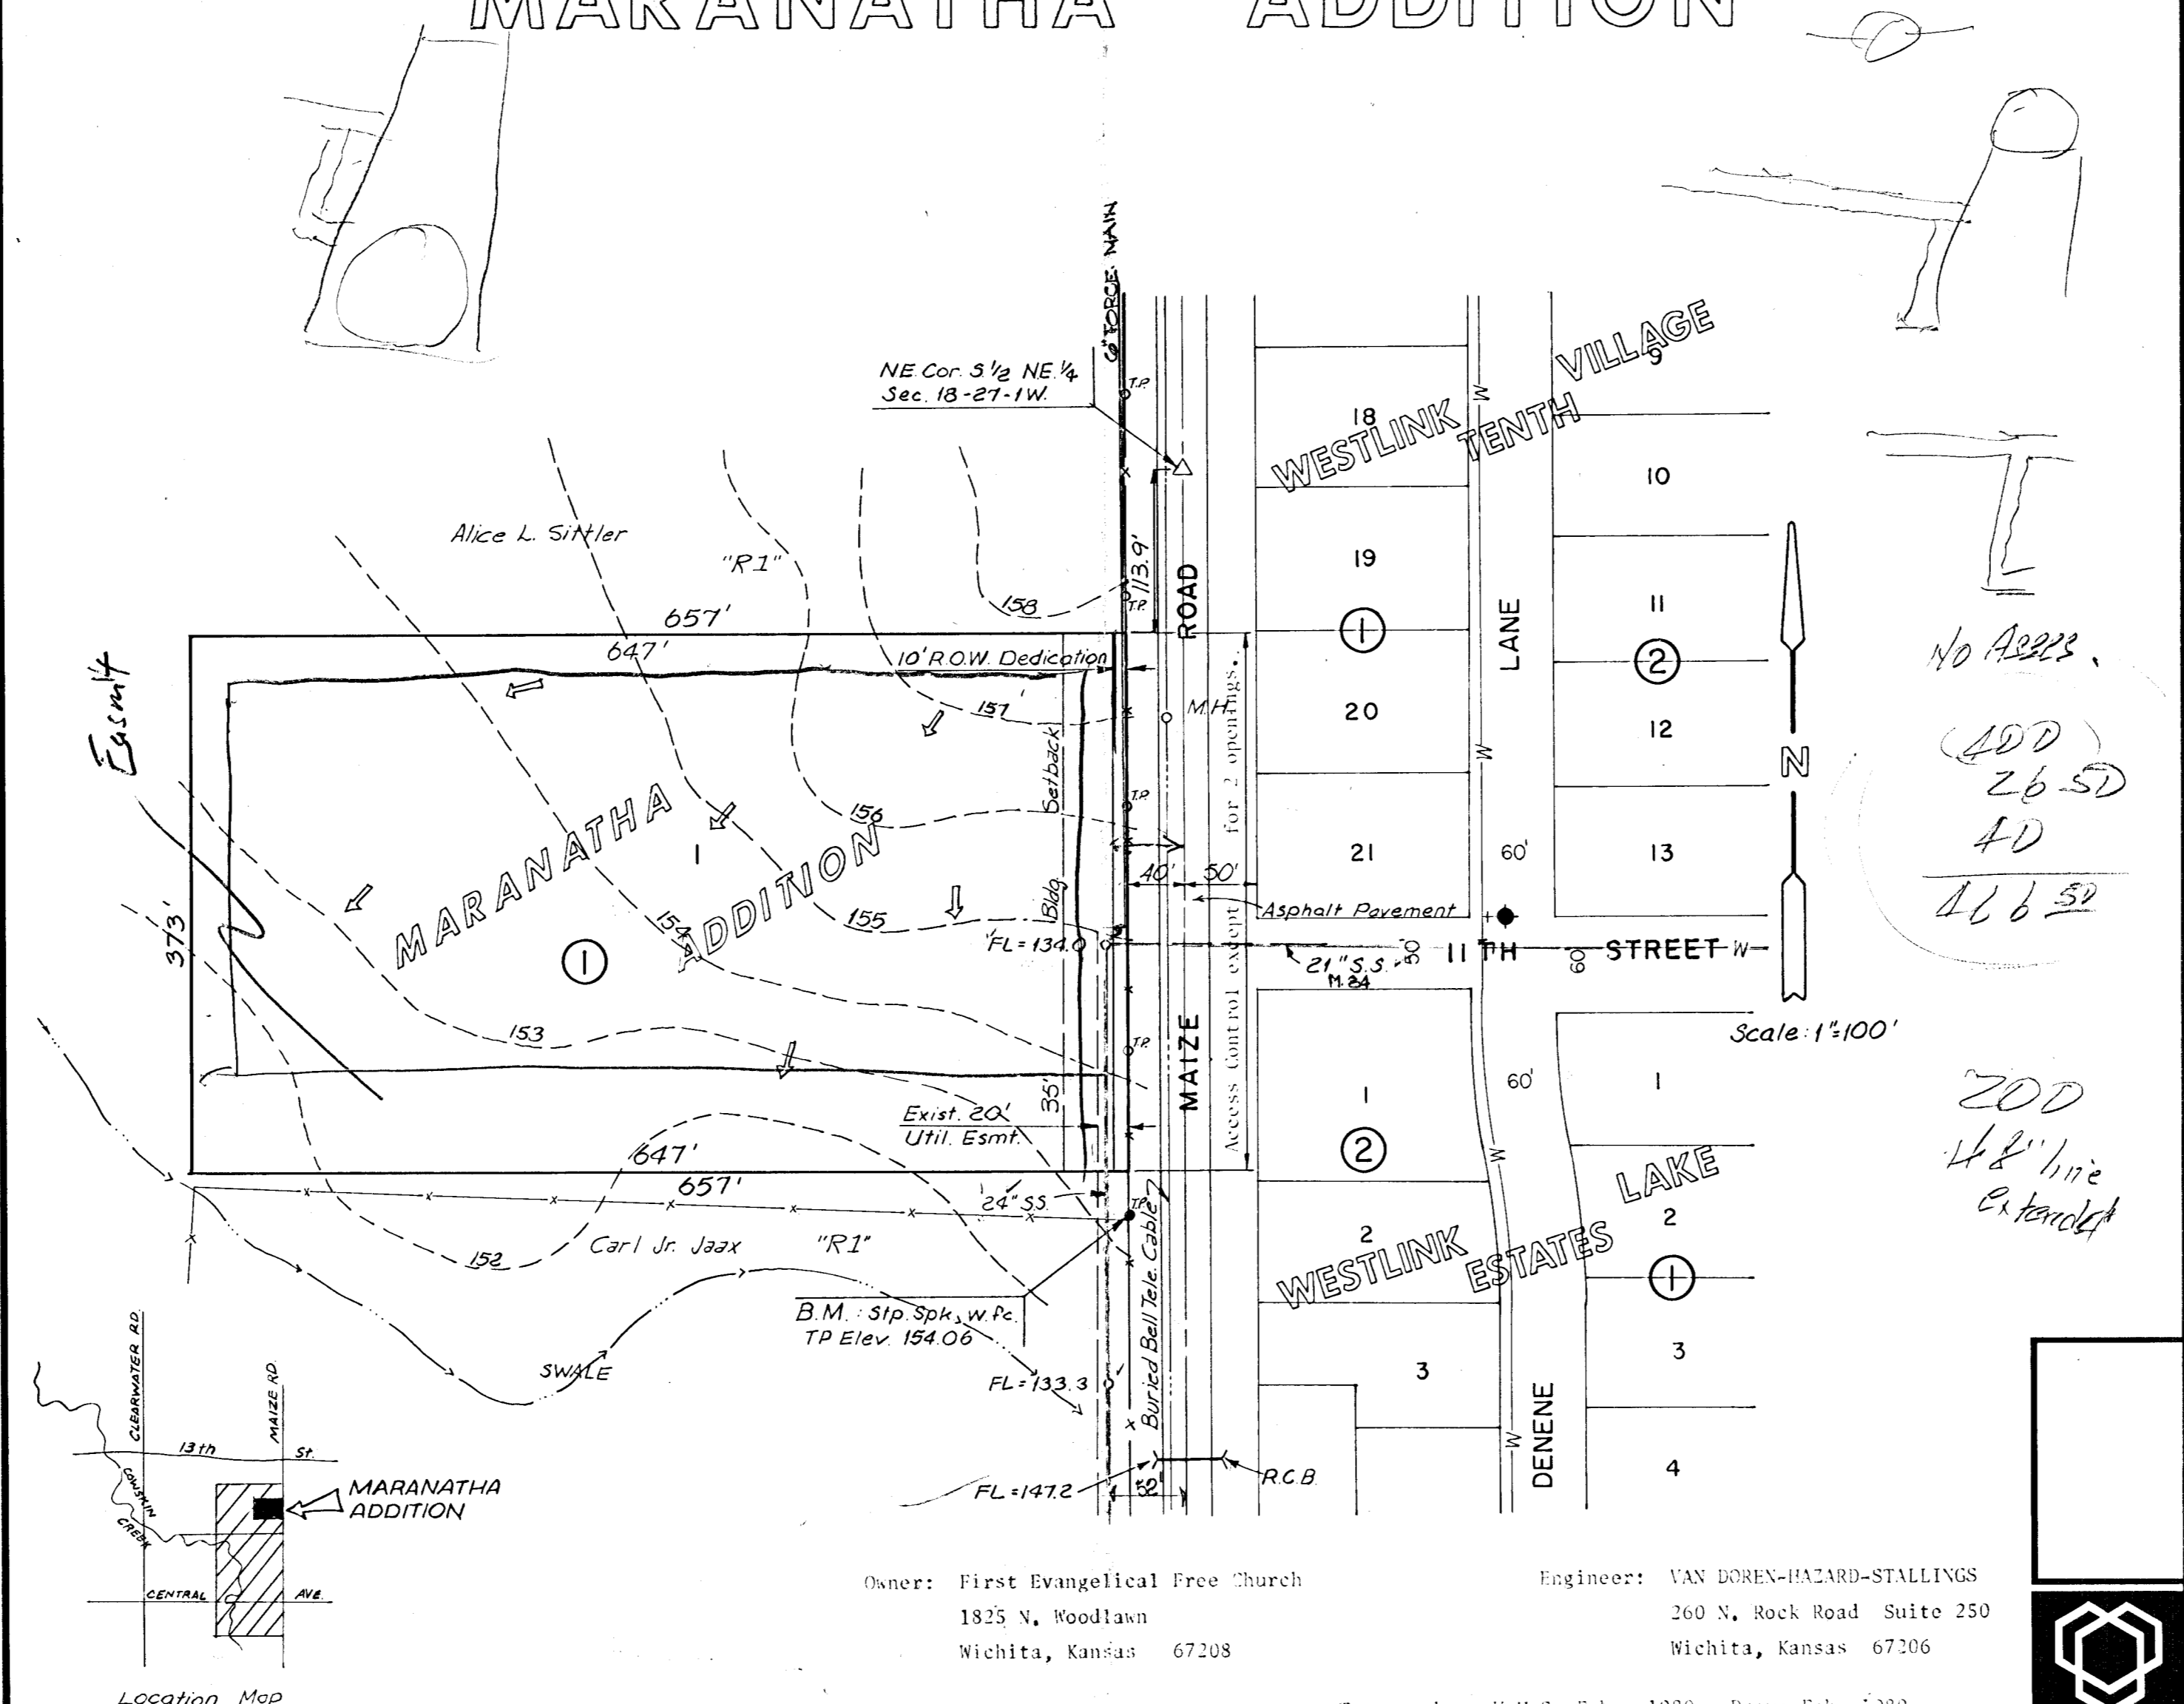

No Access
 (ADD)
 26.50
 40
 46.50

200
 1/8' line
 extended

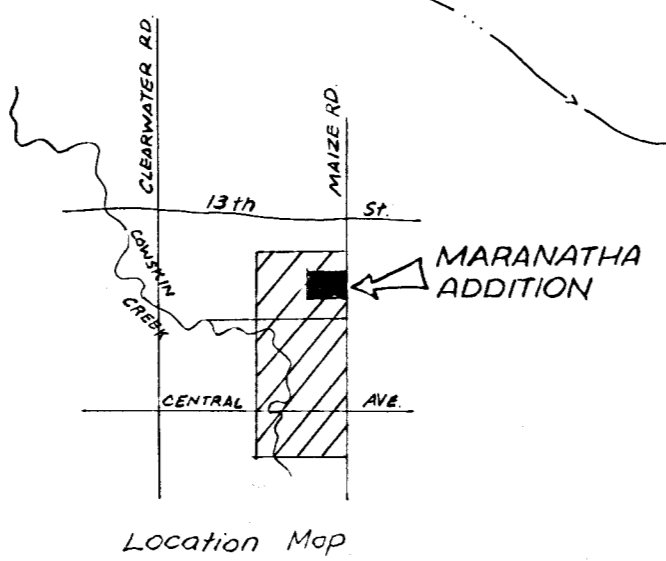

Owner: First Evangelical Free Church
 1825 N. Woodlawn
 Wichita, Kansas 67208

Engineer: VAN DOREN-BAZARD-STALLINGS
 260 N. Rock Road Suite 250
 Wichita, Kansas 67206

Topography: V.H.S., Feb., 1980 Drawn Feb. 1980

