


B.M. : ELEV. 129.87 - "D" CHISELED ON NW COR. BRIDGE AT  
MAPLE & BIG DITCH.

TOPO MADE DEC. 1984.

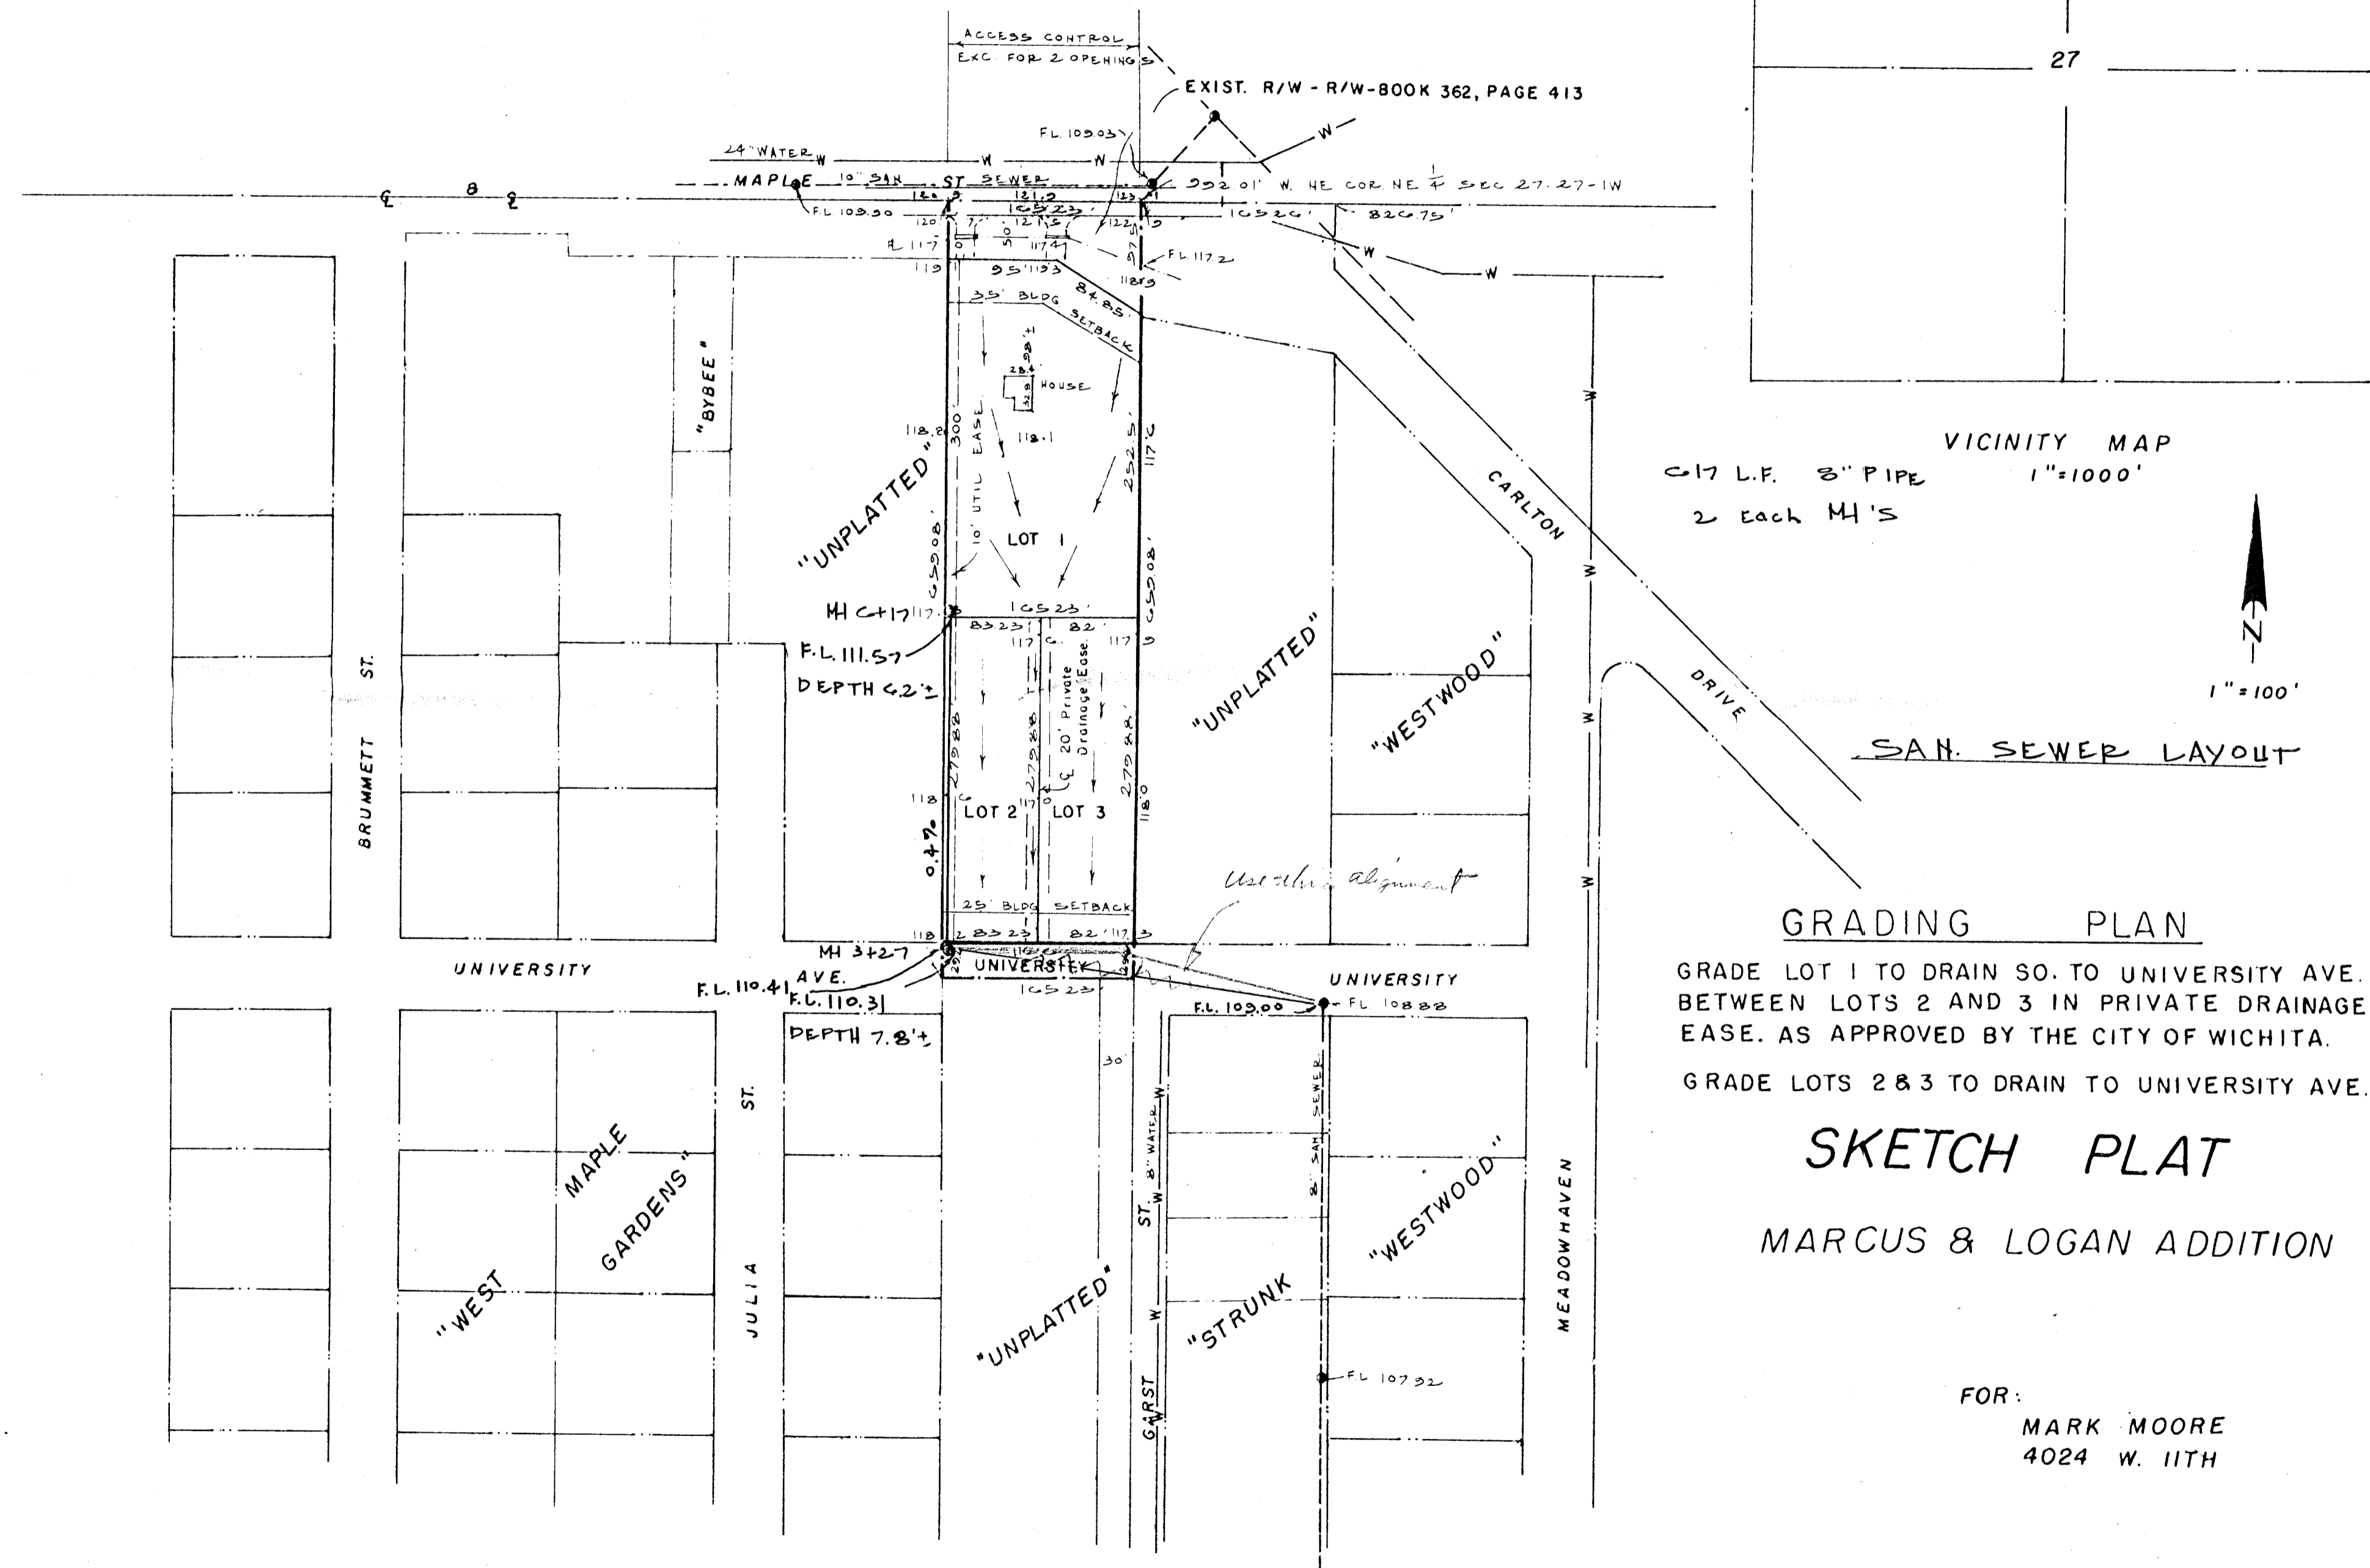

VICINITY MAP  
1"=1000'  
C-17 L.F. 8" PIPE  
2 Each MH'S  
1"=100'

GRADING PLAN  
GRADE LOT 1 TO DRAIN SO. TO UNIVERSITY AVE.  
BETWEEN LOTS 2 AND 3 IN PRIVATE DRAINAGE  
EASE. AS APPROVED BY THE CITY OF WICHITA.  
GRADE LOTS 2 & 3 TO DRAIN TO UNIVERSITY AVE.  
**SKETCH PLAT**  
MARCUS & LOGAN ADDITION

FOR:  
MARK MOORE  
4024 W. 11TH

LOWELL D. HIGH, L.S.  
DEC. 5, 1984