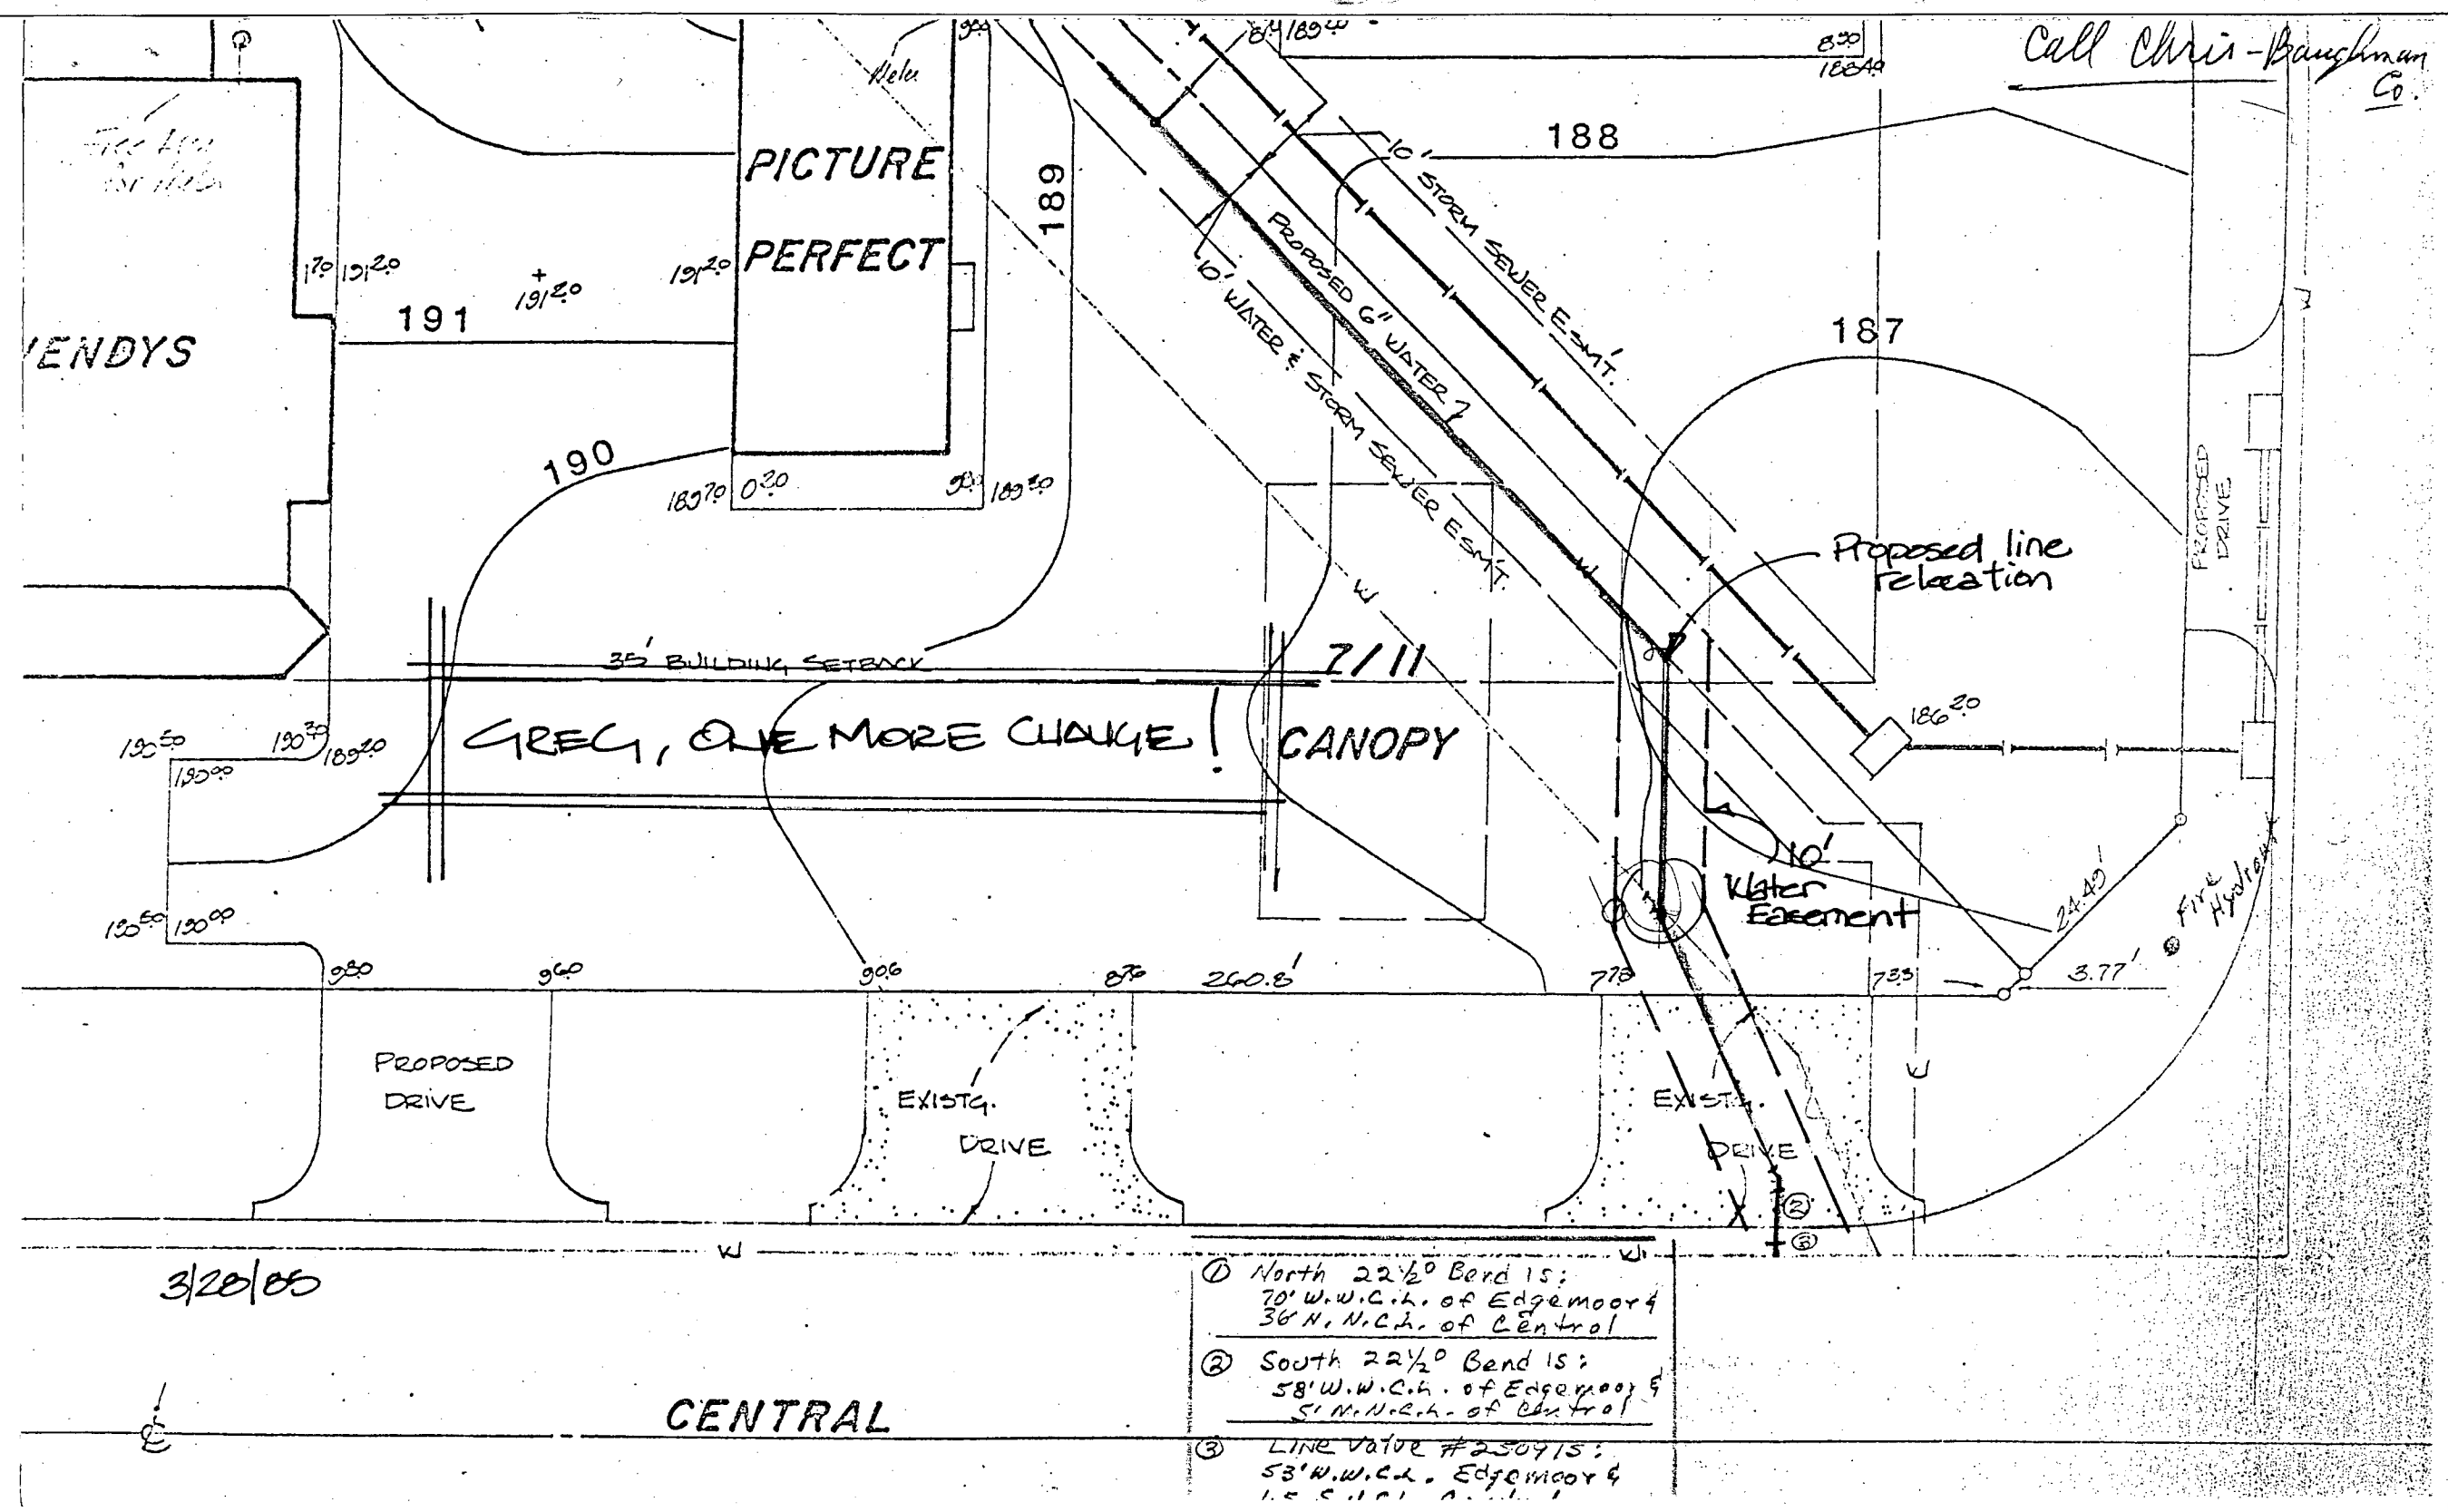
Call Chris - Baughman Co.
PICTURE PERFECT
WENDYS
191
190
189
188
187
10' STORM SEWER ESMT.
PROPOSED 6" WATER
10' WATER & STORM SEWER ESMT.
Proposed line relocation
35' BUILDING SETBACK
7/11
CANOPY
10' Water Easement
PROPOSED DRIVE
Fire Hydrant
260.8'
3.77'
24.49'
PROPOSED DRIVE
EXISTG. DRIVE
EXISTG. DRIVE
① North 22½° Bend is: 70' W.W.C.L. of Edgemoor & 36' N.N.C.L. of Central
② South 22½° Bend is: 58' W.W.C.L. of Edgemoor & 5' N.N.C.L. of Central
③ Line Valve #250715: 53' W.W.C.L. Edgemoor &
CENTRAL