


# drainage plan

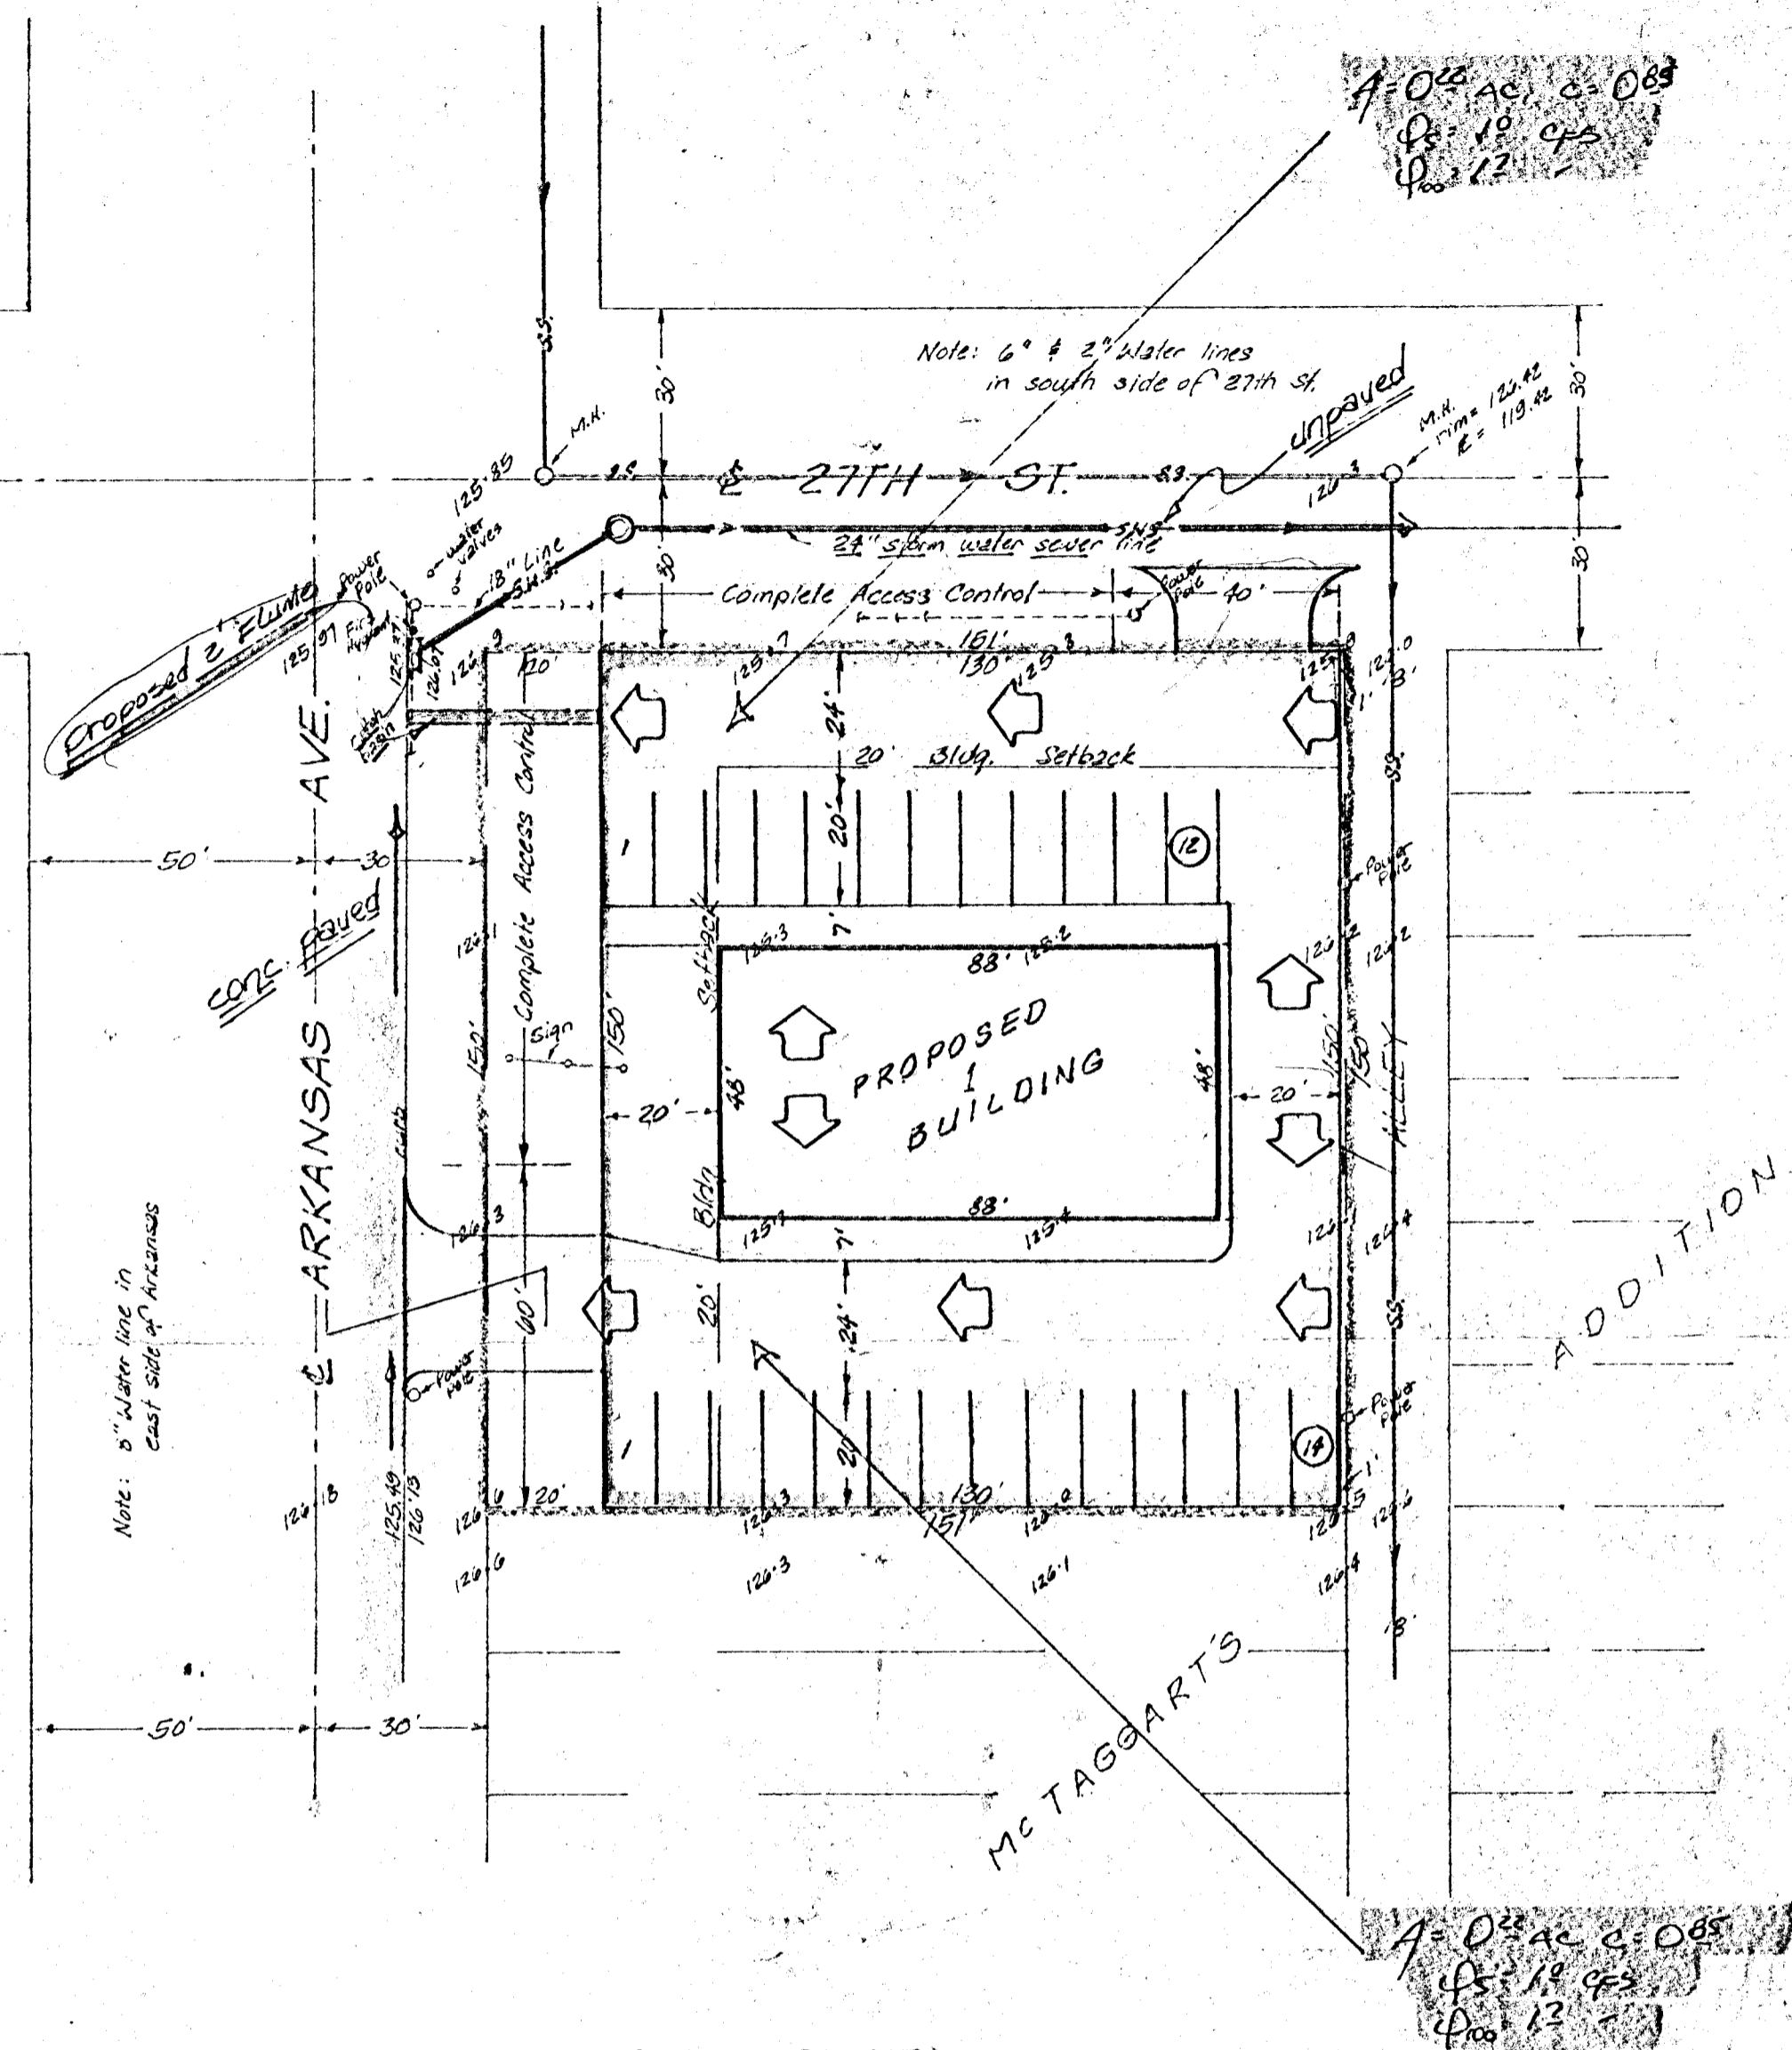

## SKETCH PLAT POWELL'S 8TH ADDITION

LOTS 2-4-6-8-10-12 ON ARKANSAS  
MCTAGGART'S ADDITION TO WICHITA,  
KANSAS

OWNER: JULIE JANINE BRANSON