


File -

WI

Willie - Esque 5th Add²

Torbury Lane

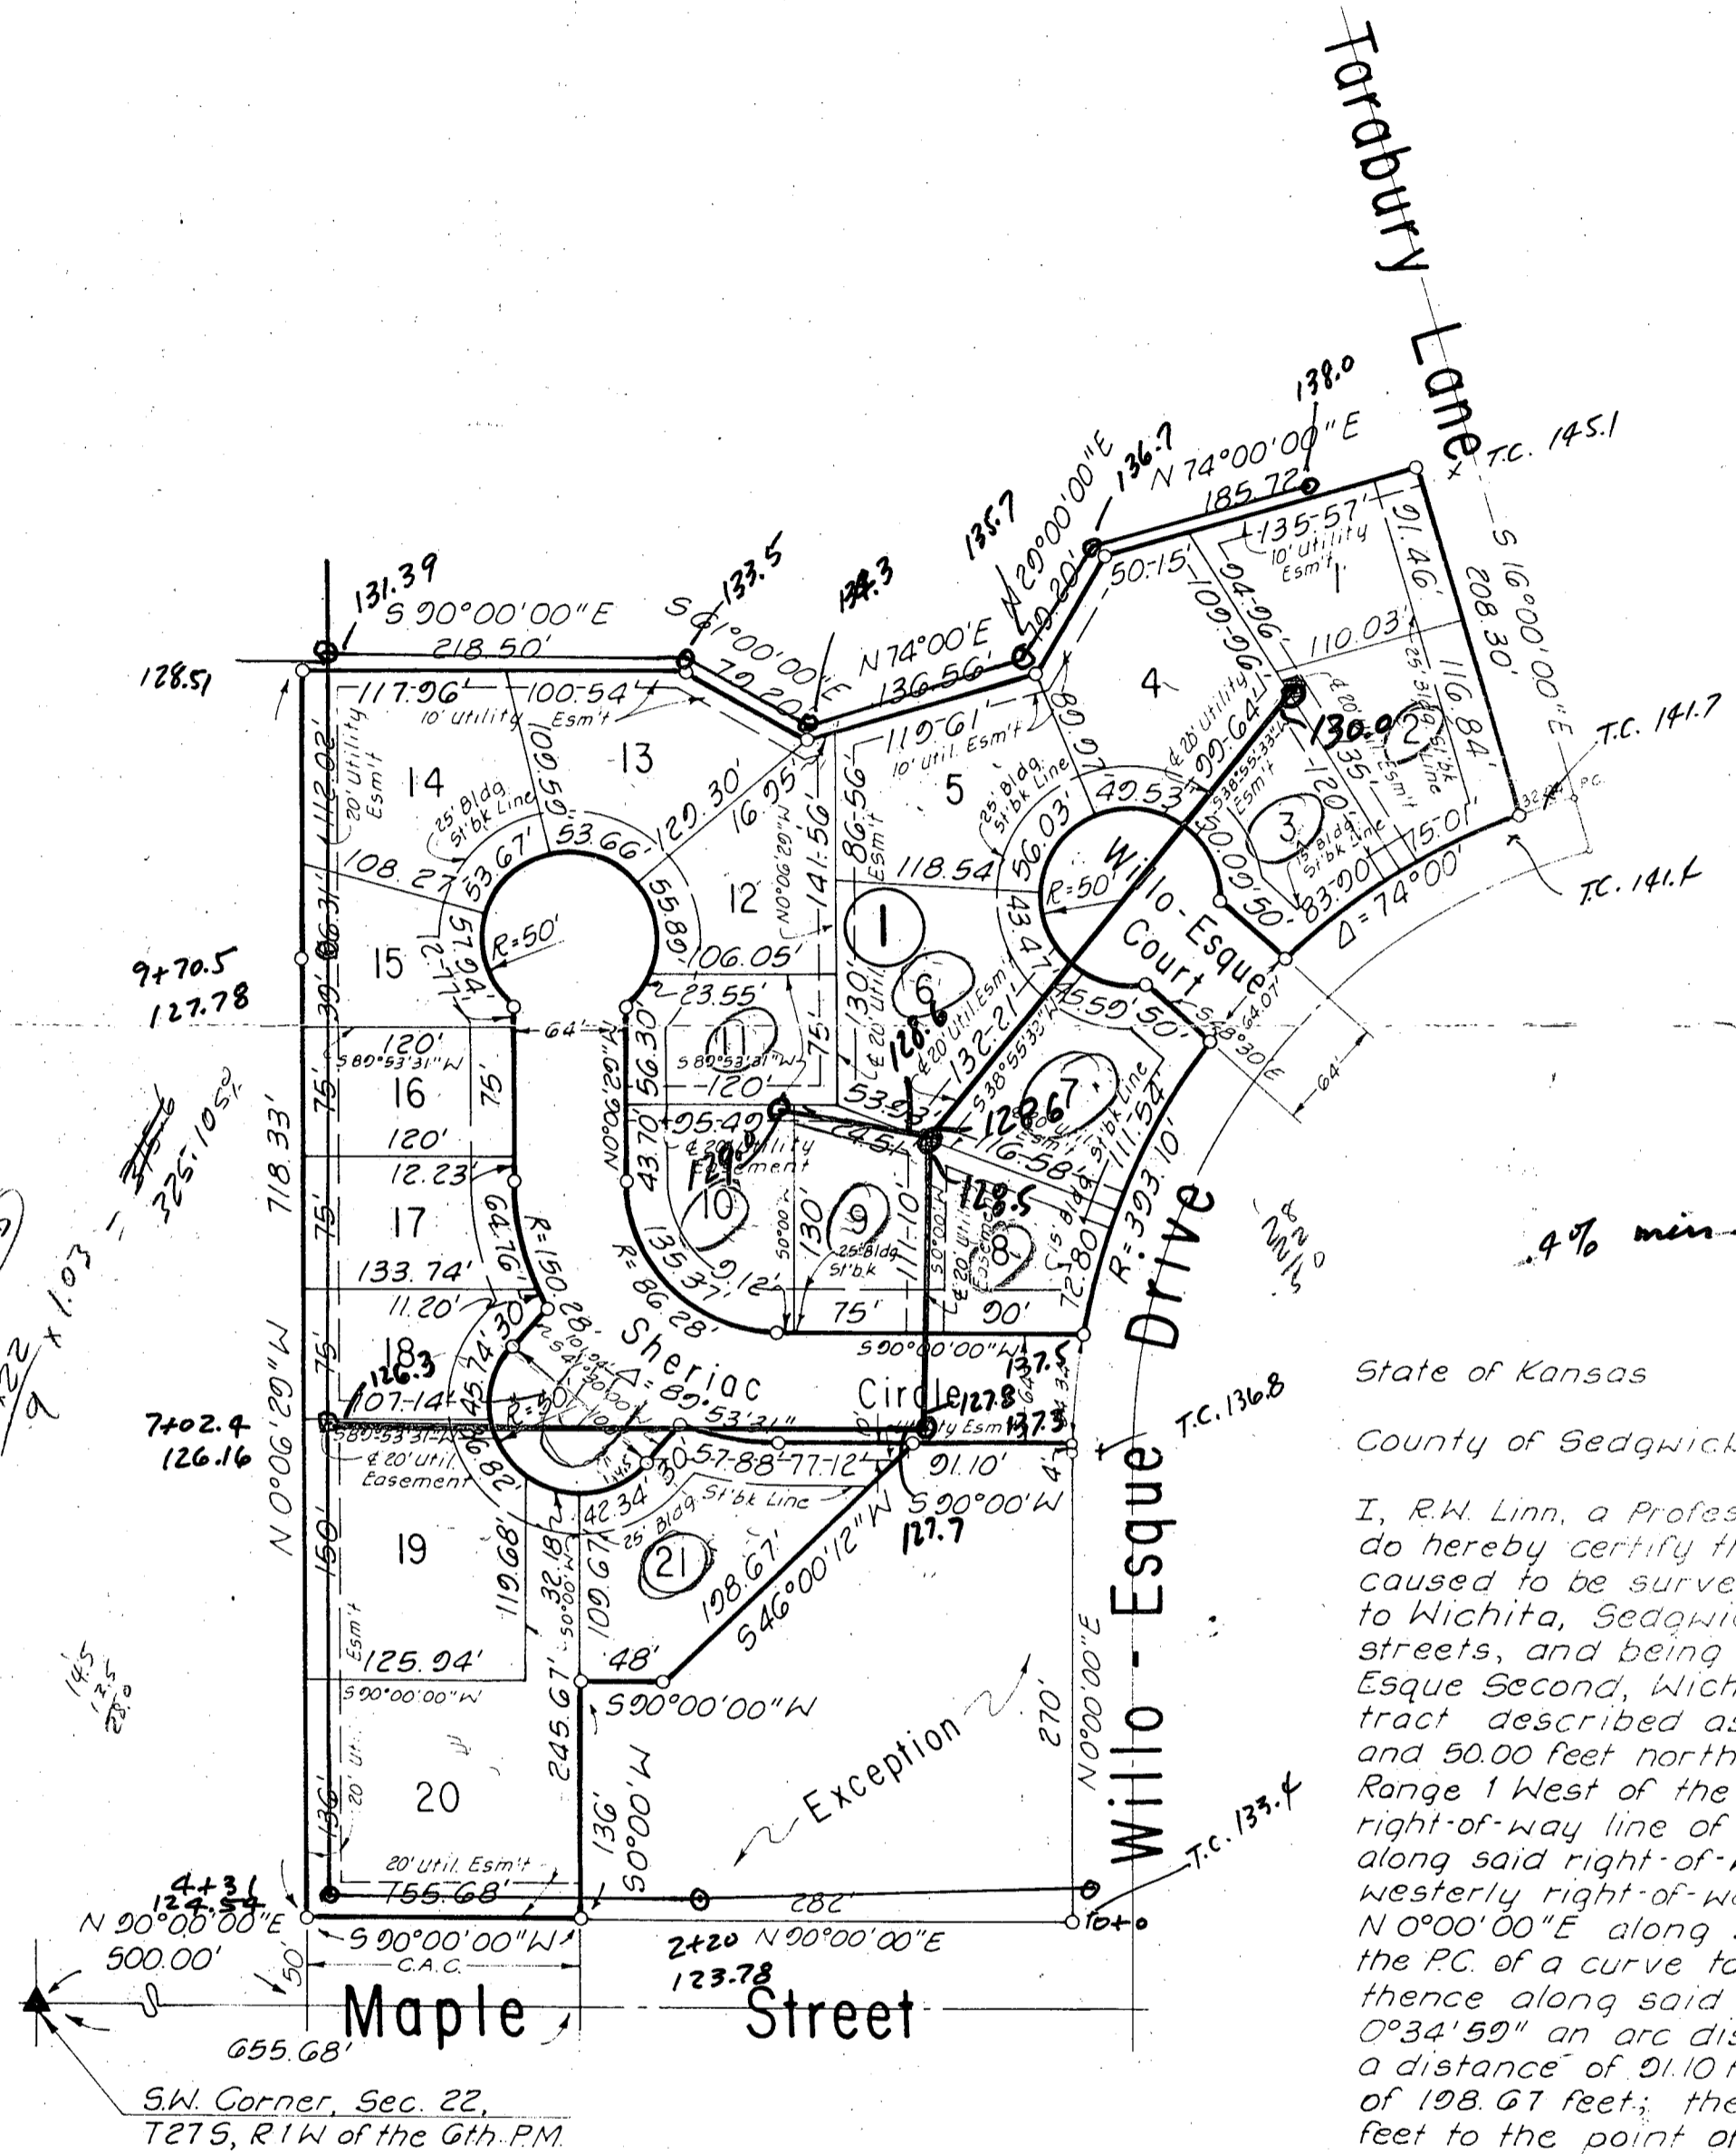

27
 27' B.B.
 $\frac{124 \times 22}{9} \times 1.03 = 325.105$
 145
 2.5
 28.5

4% min

State of Kansas
 County of Sedgwick



920'-8" 9 lots } ?
 4 MH 12 " } ?
 \$29,000