VICINITY MAP
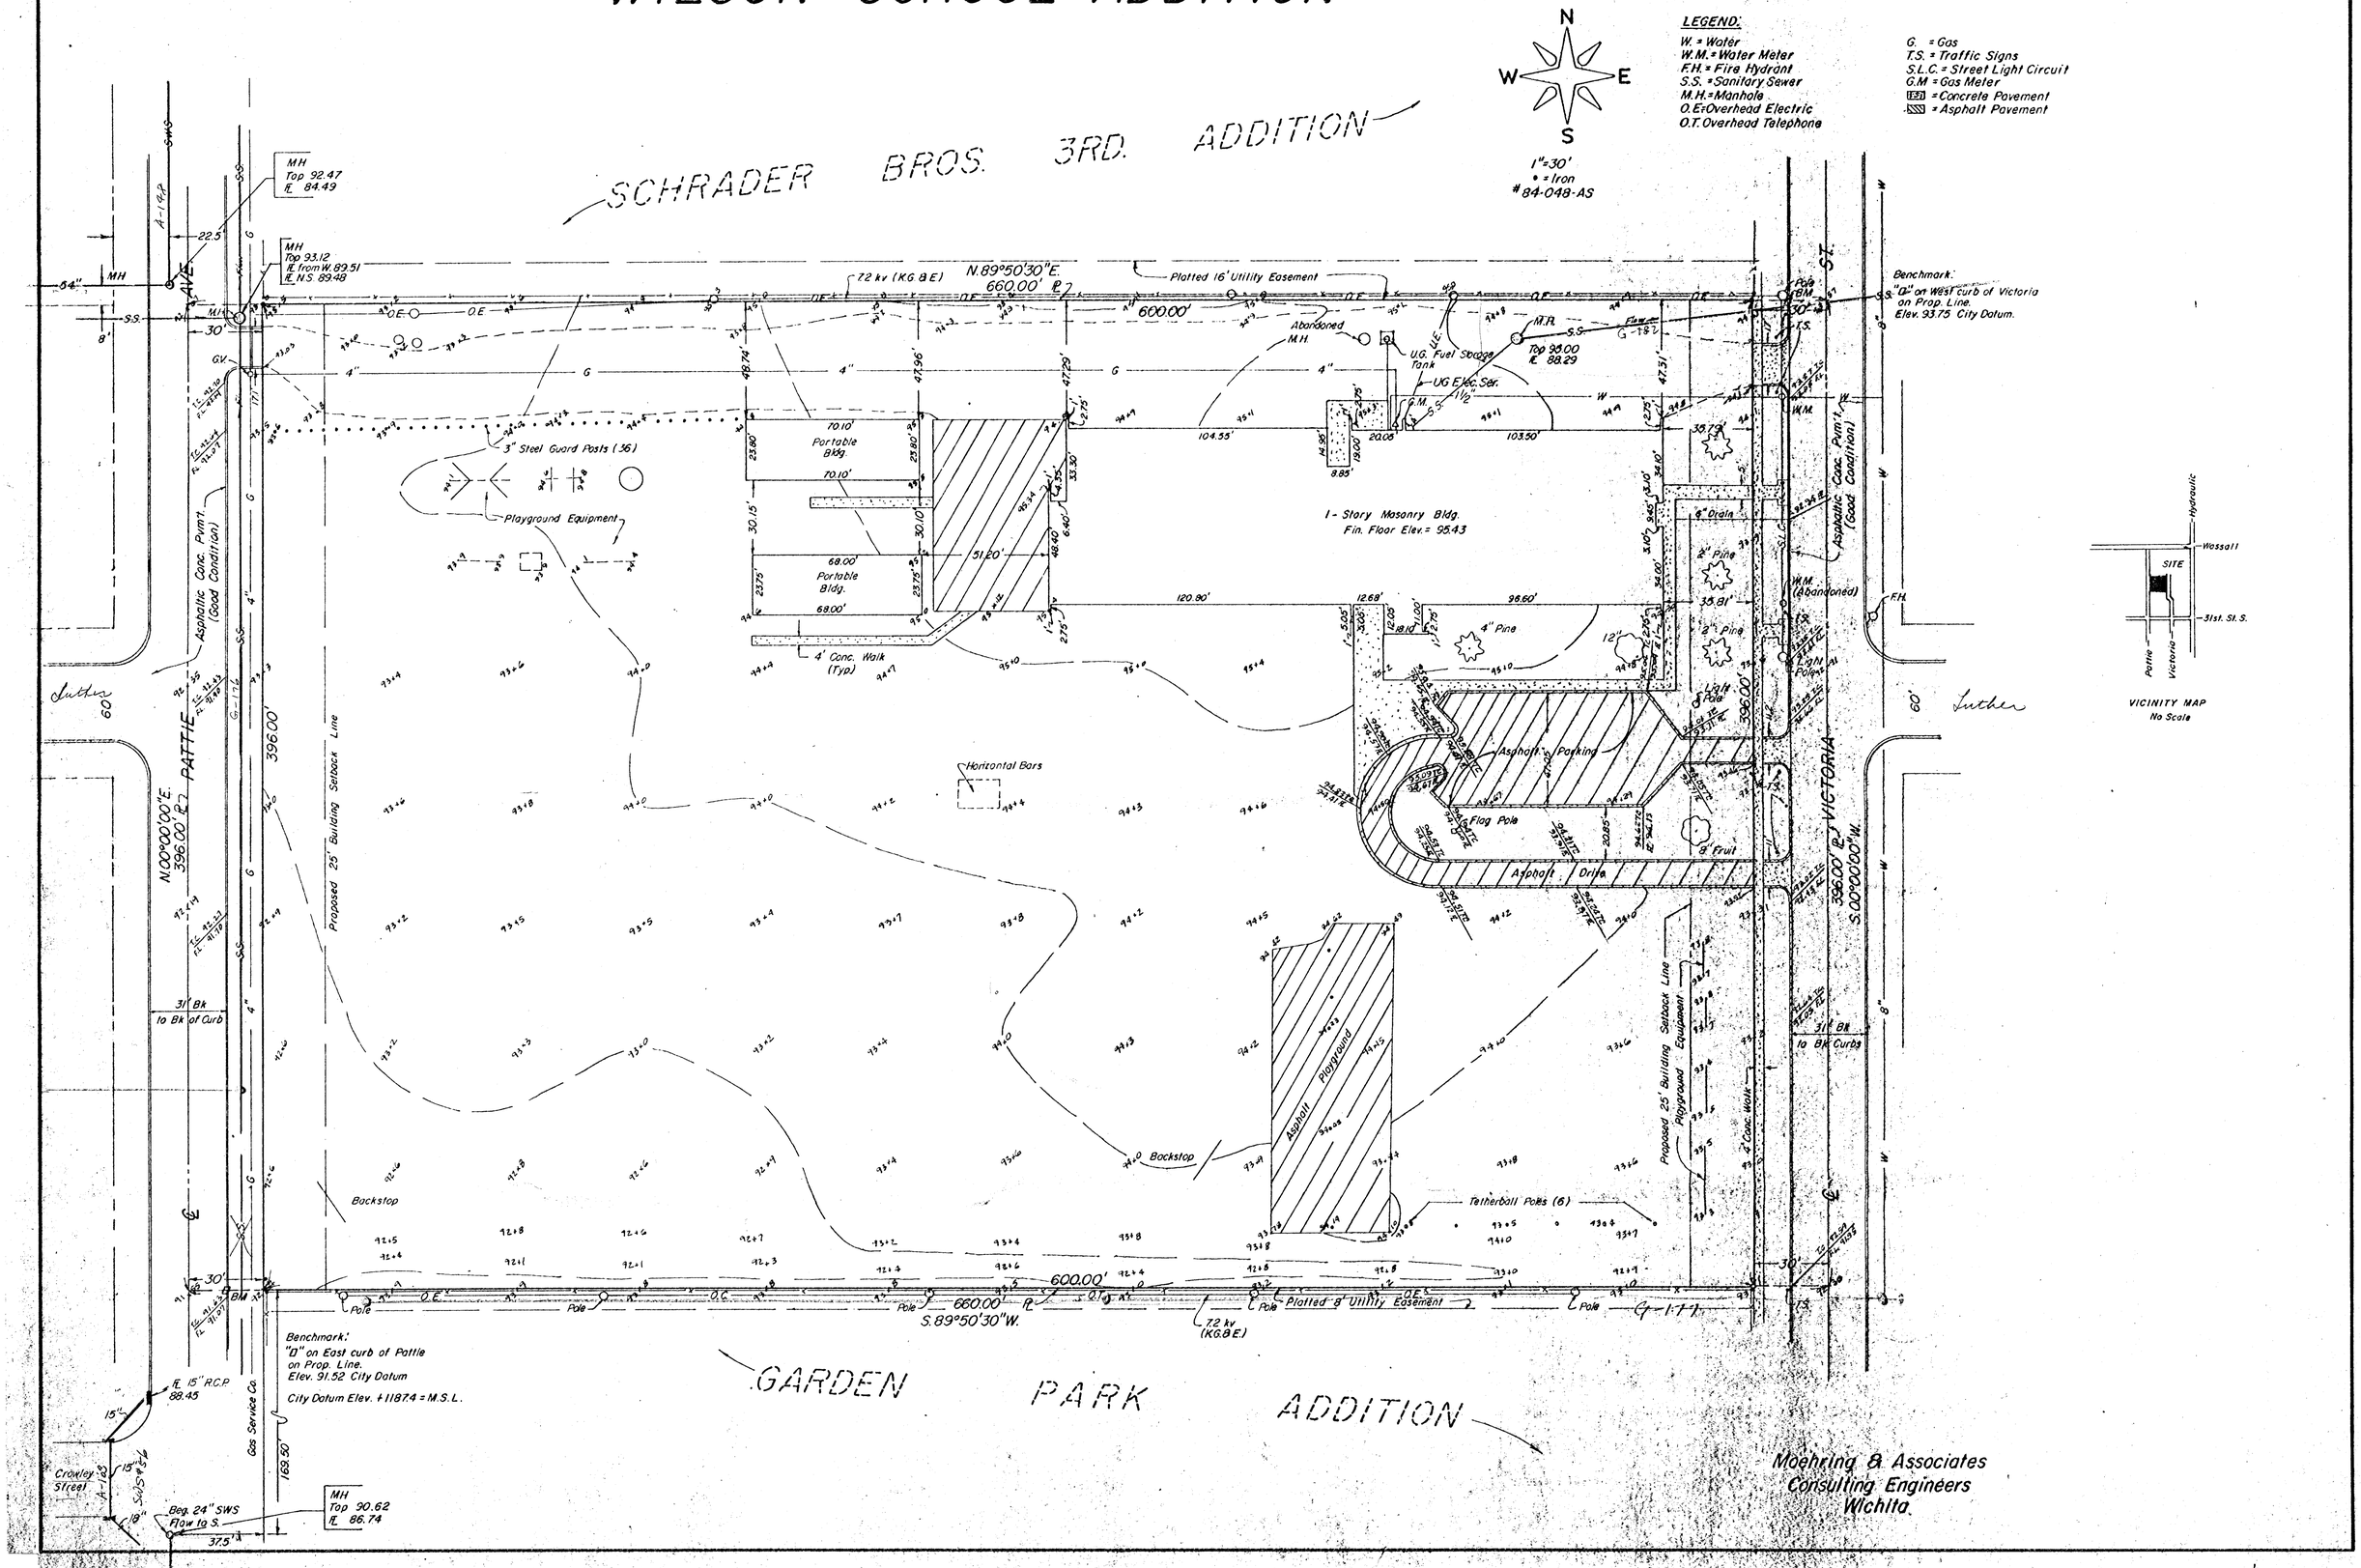
WILSON SCHOOL ADDITION