
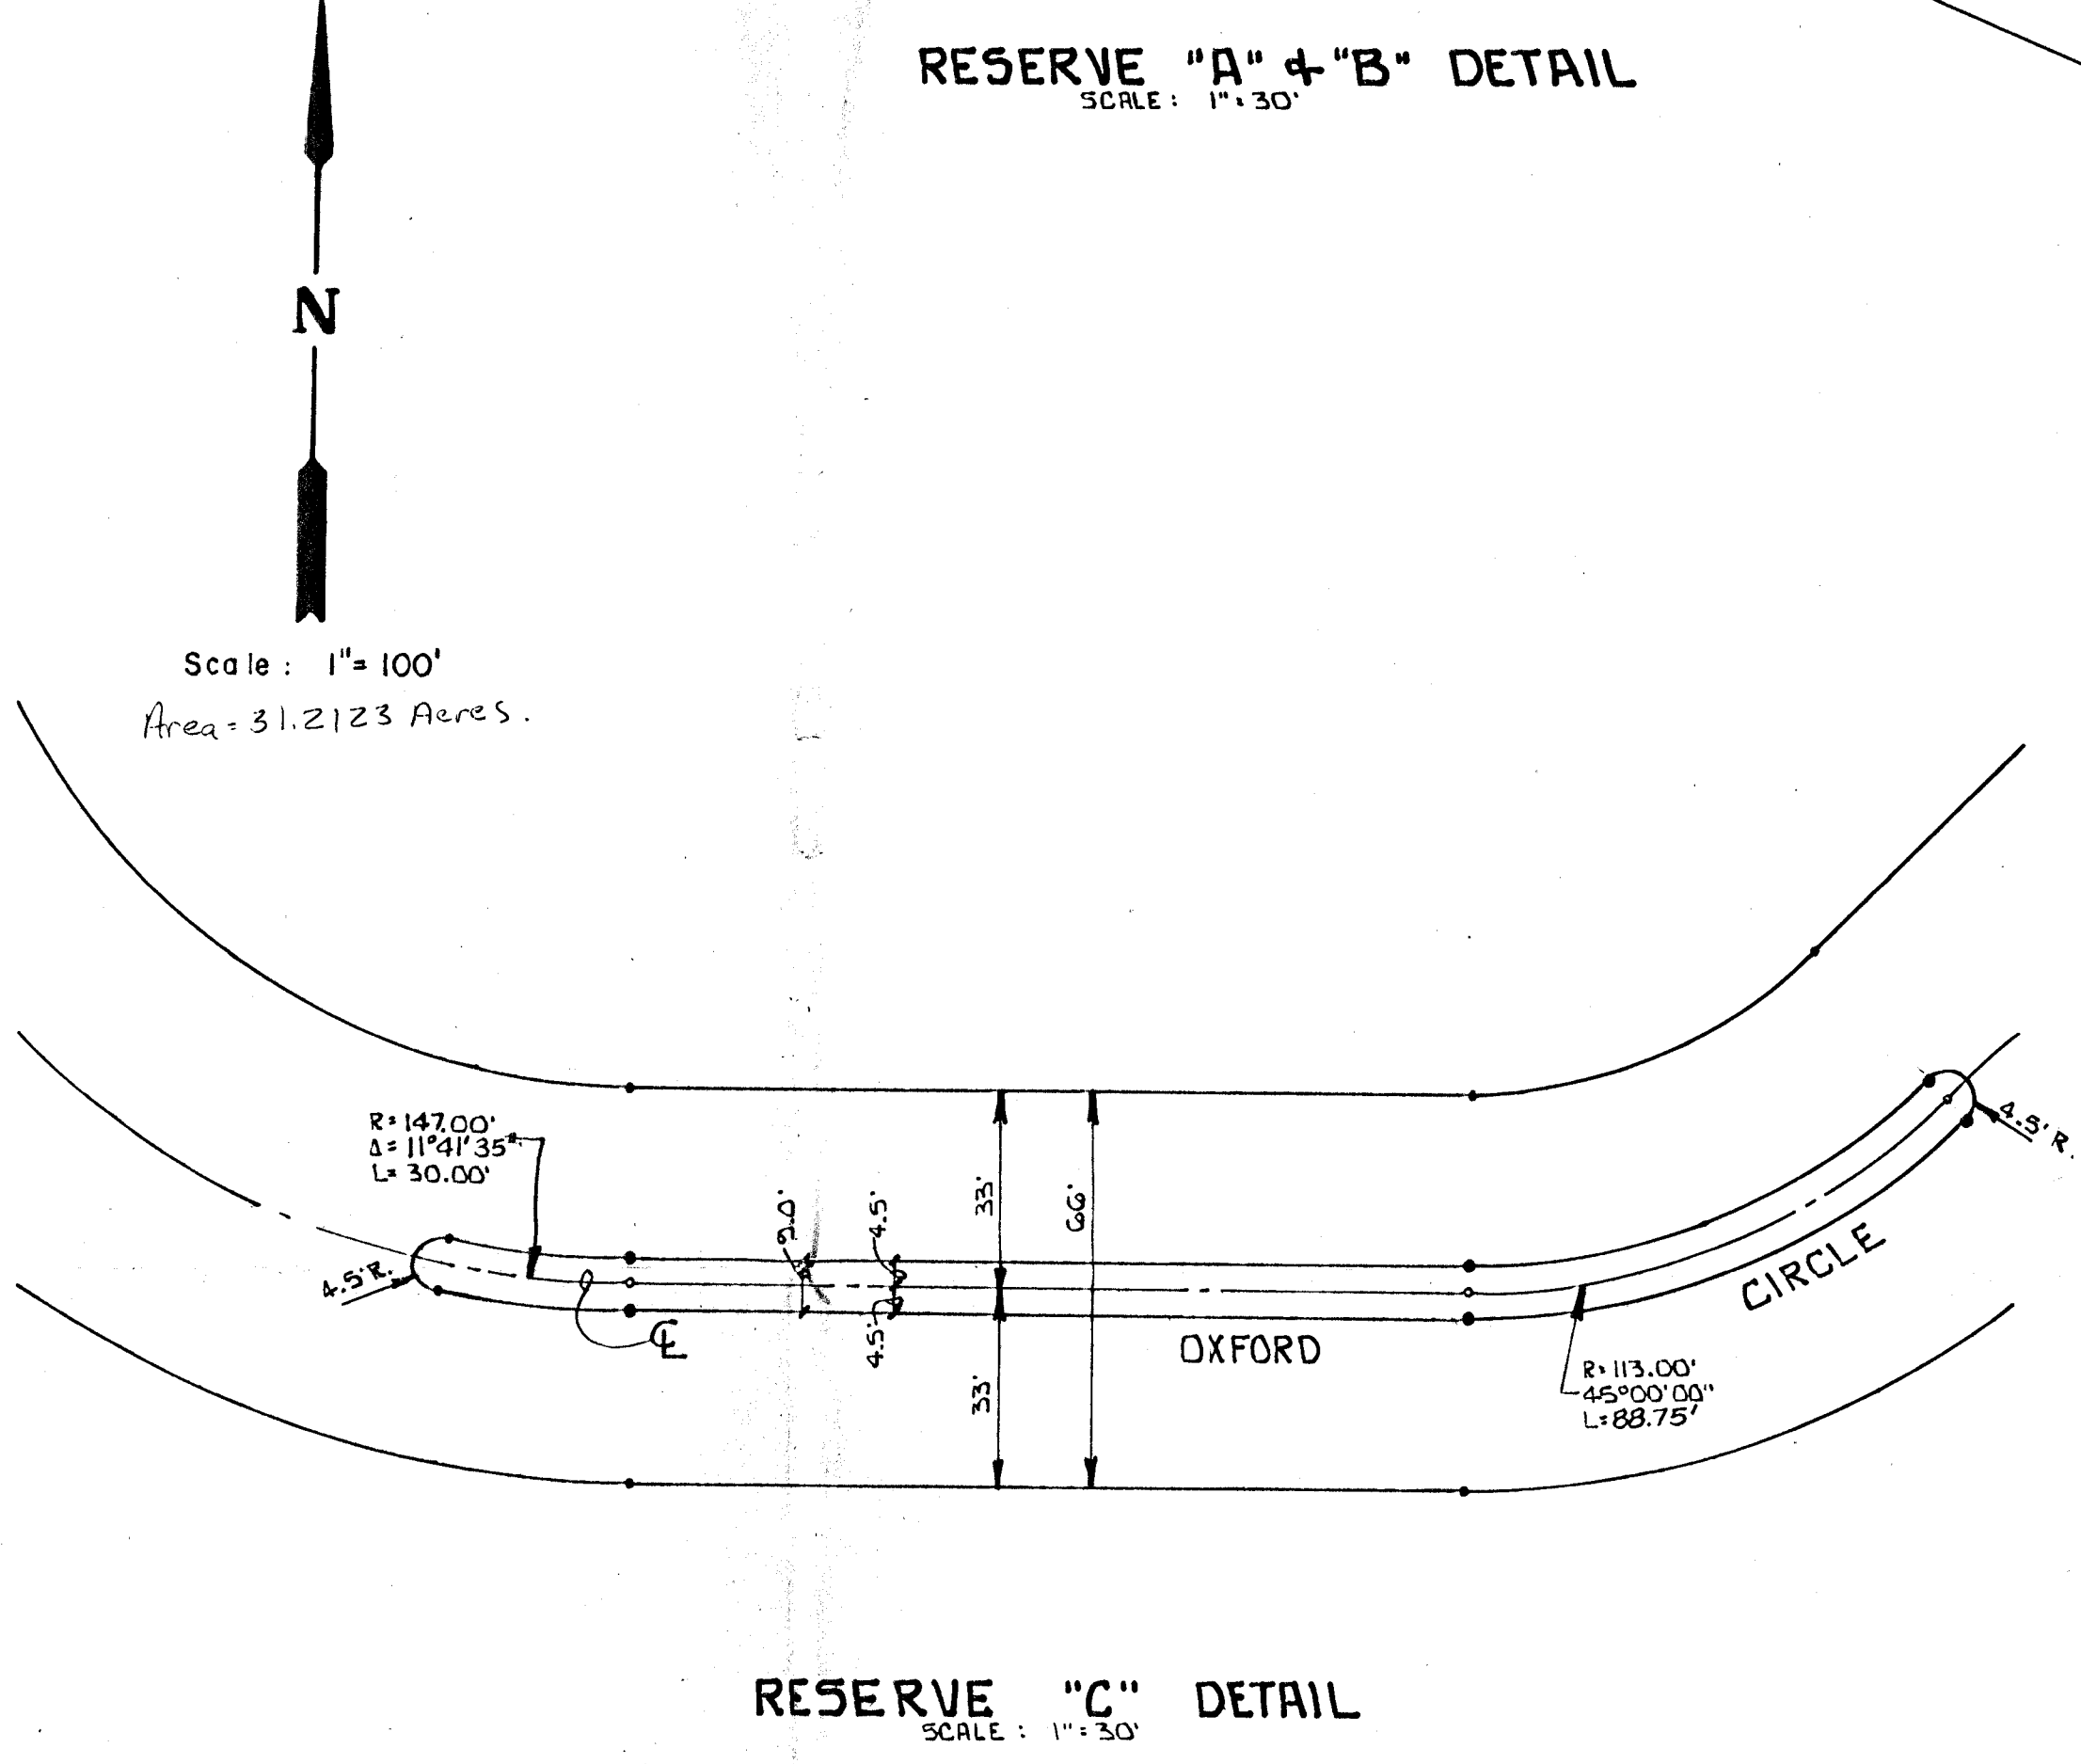
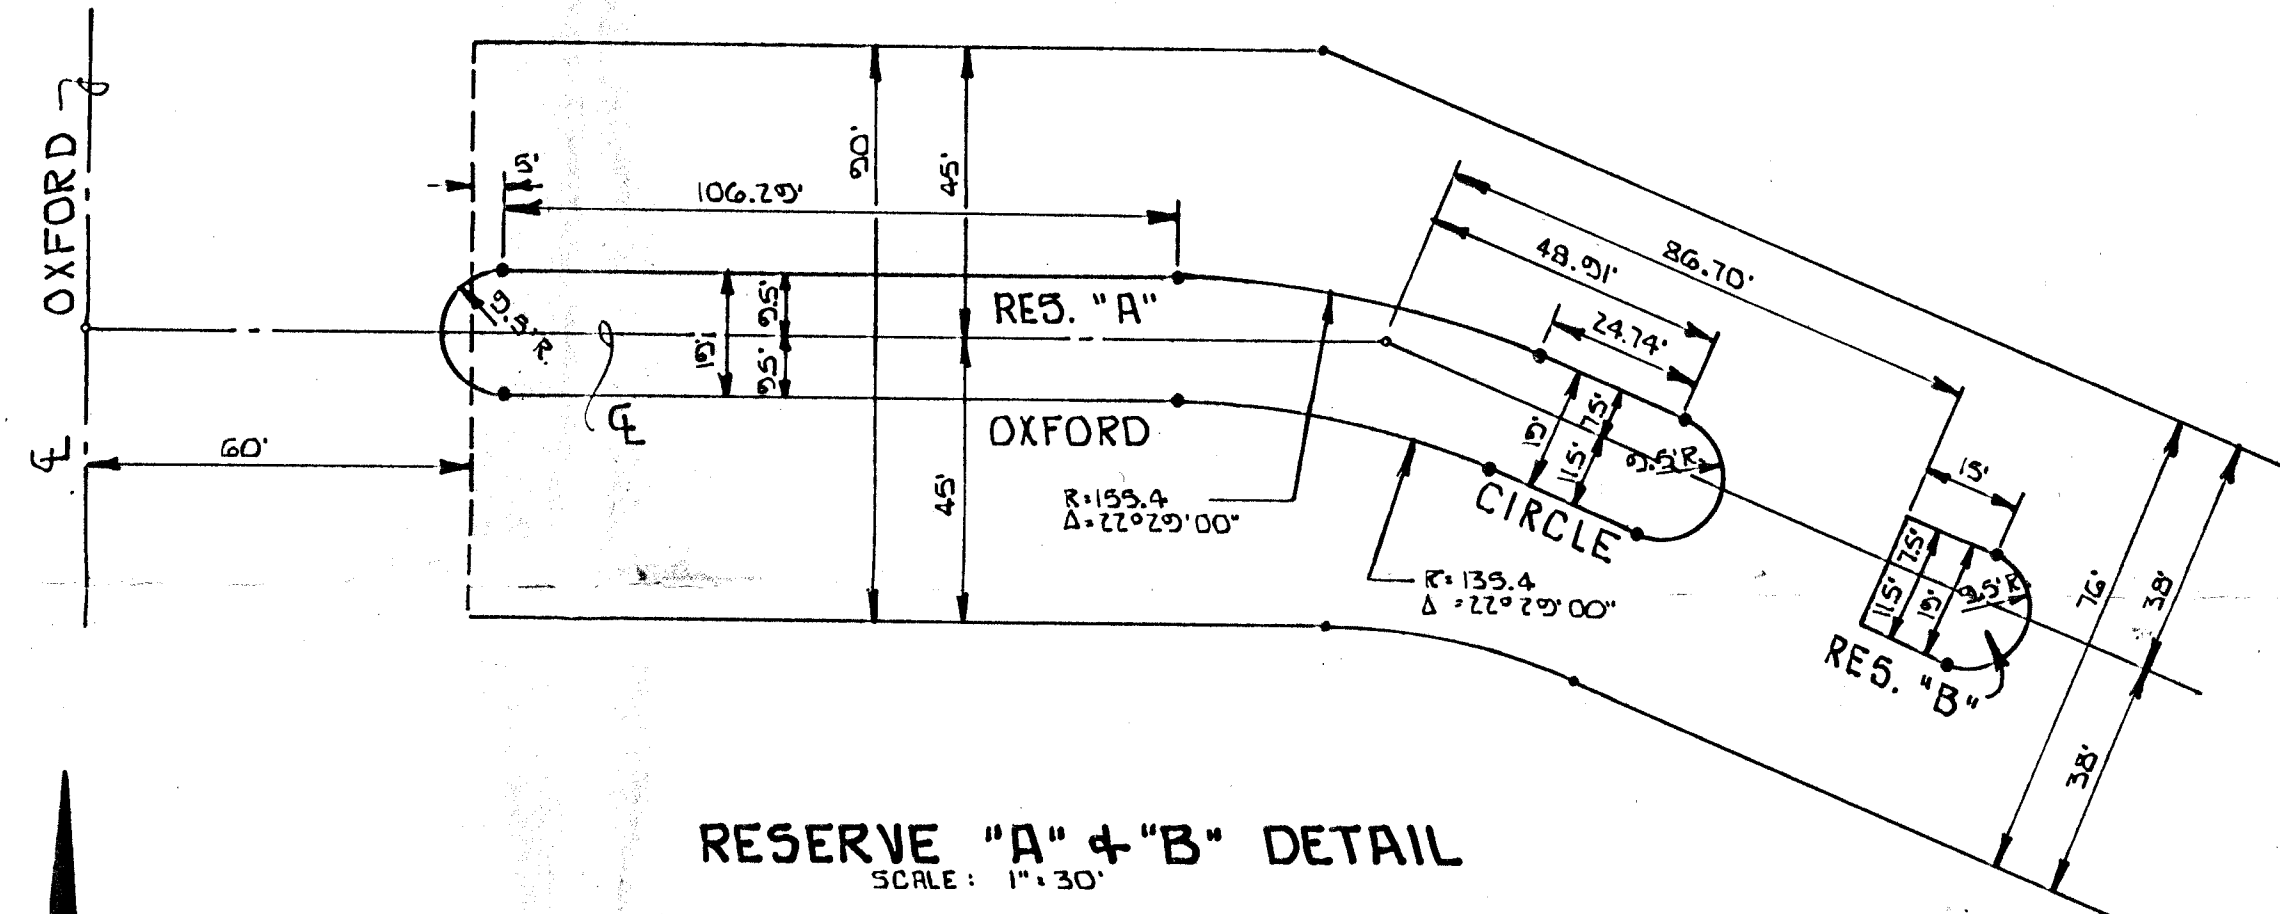


FINAL PLAT OF
WINDEMERE SECOND ADDITION
 AN ADDITION TO WICHITA, SEDGWICK COUNTY KANSAS

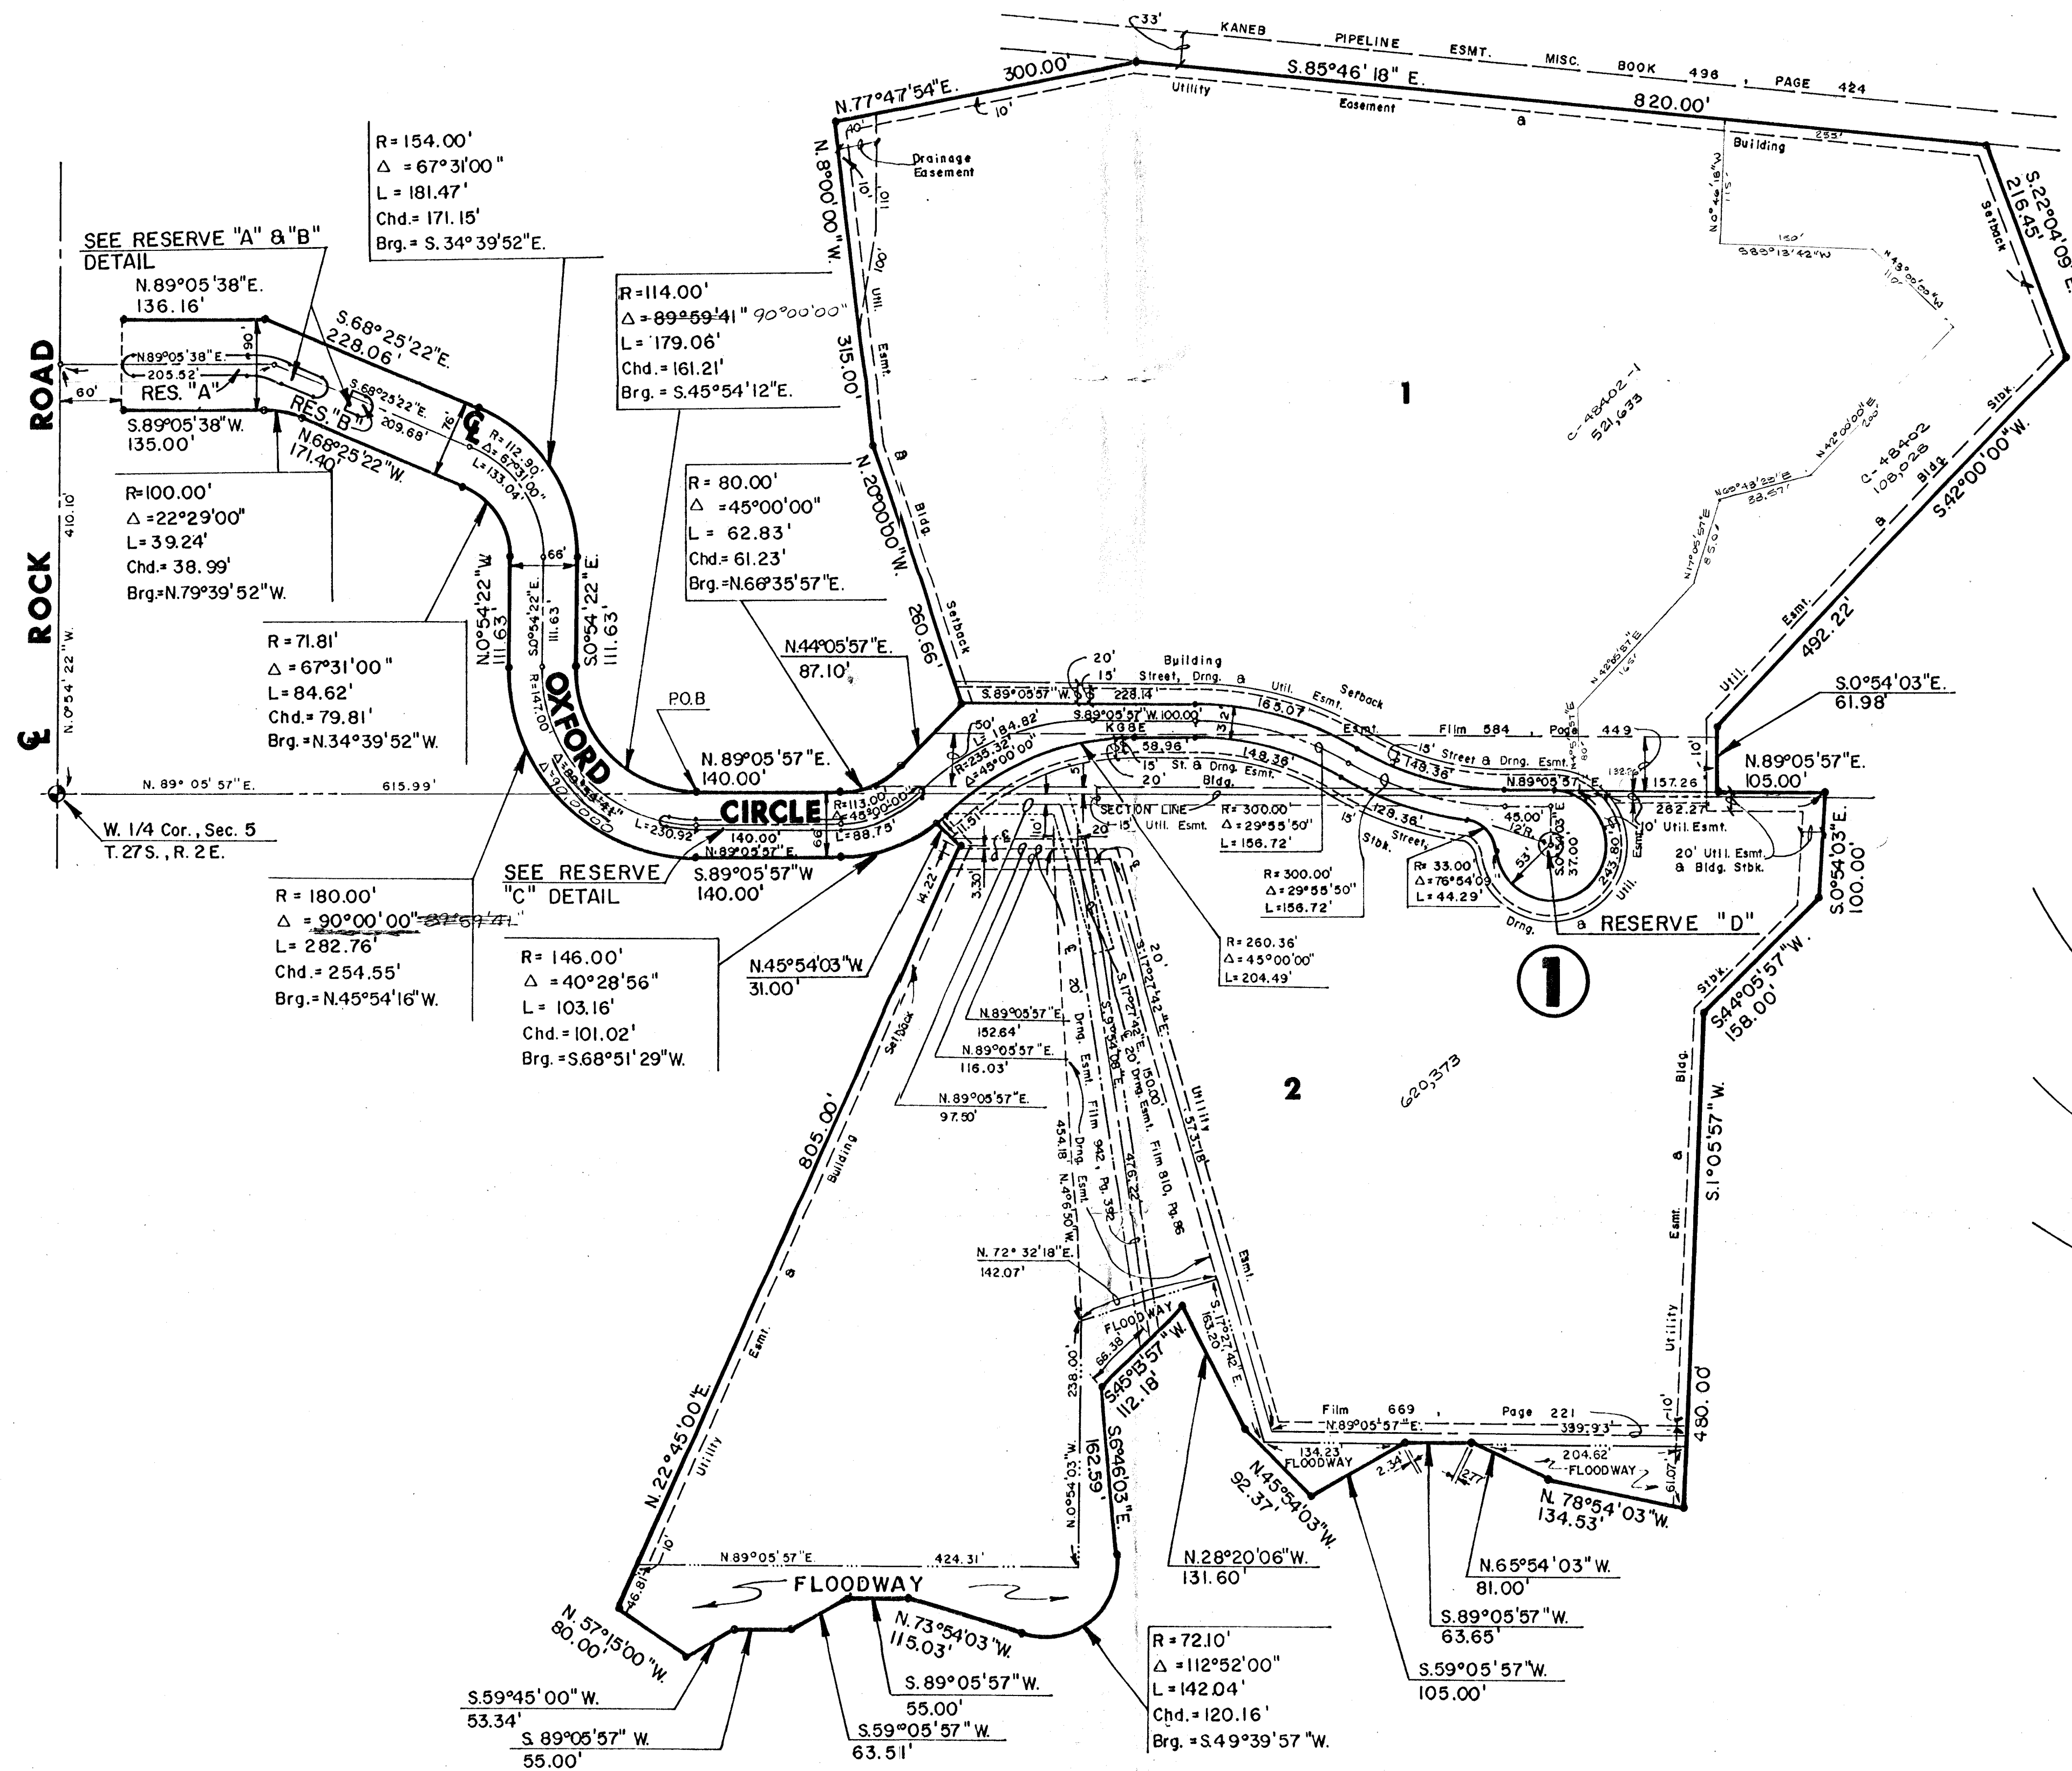

Scale: 1" = 100'
 Area: 31.2123 Acres.