

TALLGRASS COMMERCIAL  
 1ST ADDITION  
 (See also Easement  
 MAP at Tallgrass)


Table 1 & 2

Area	C	T	L	W	A	0100
2	0.85	15	3.06	8.05	6.0	13.3

- A. A cross drainage agreement needs to be submitted with the covenants.
- B. Drainage directed from this plat within an easement shall be a part of street right of way) to Twenty-first Street (to be taken underground at that point).
- C. Drainage to the north directed through Executive Park at Tallgrass will need appropriate easements if plat has not already been recorded.

DRAINAGE PLAN FOR  
 TALLGRASS COMMERCIAL  
 FIRST ADDITION

MID-KANSAS ENGINEERING CONSULTANTS PA  
 682-6561

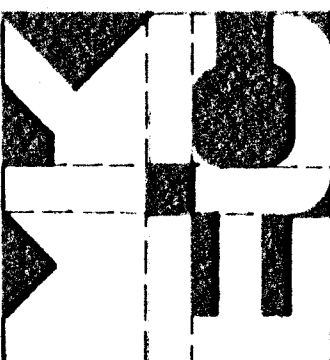

240 N. ROCK ROAD SUITE 103  
 WICHITA, KANSAS 67206