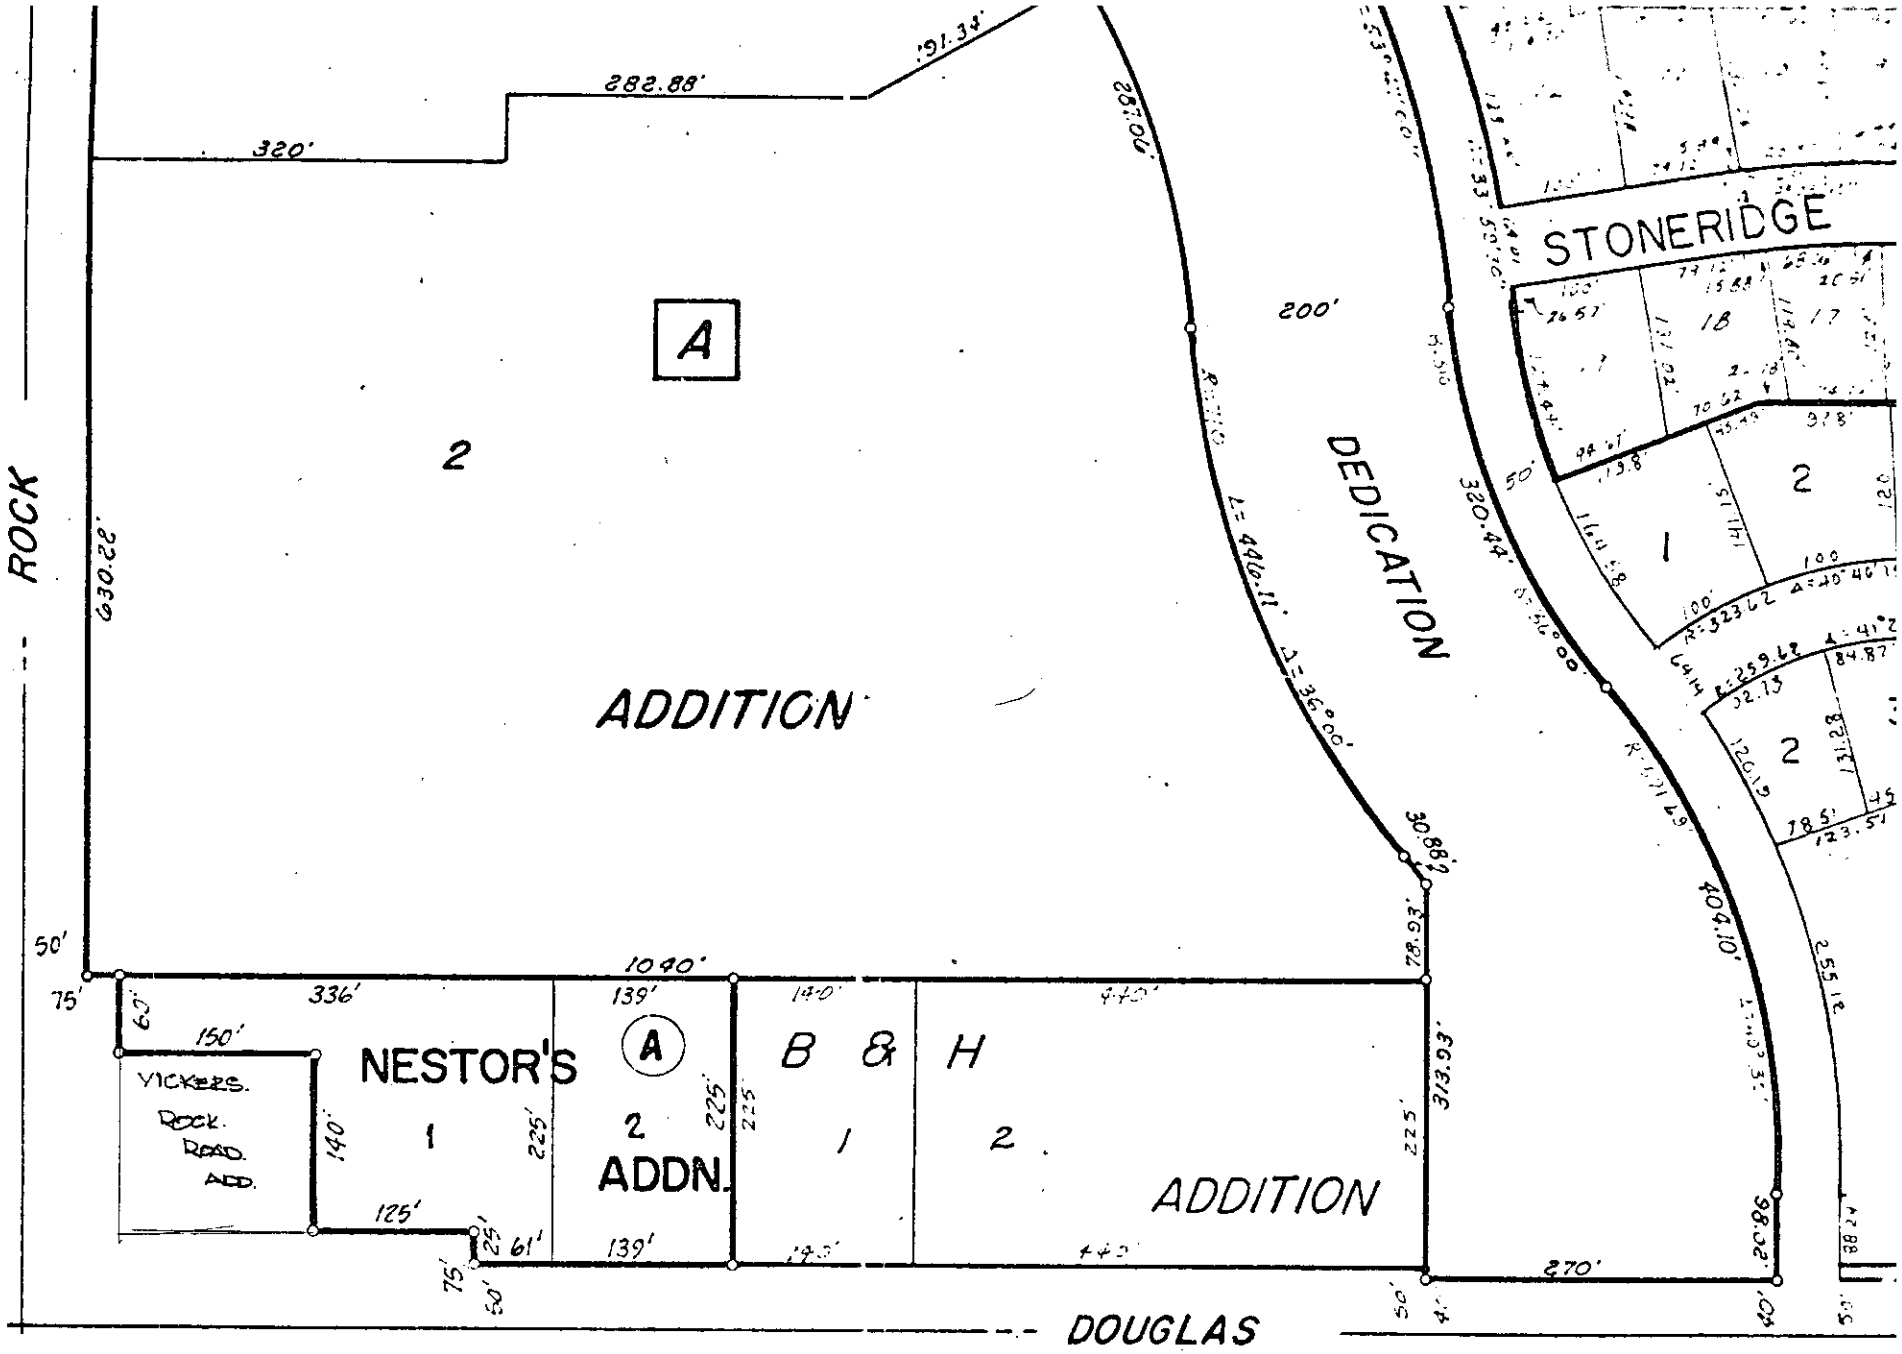
ROCK
DOUGLAS
ADDITION
A
2
DEDICATION
STONERIDGE
NESTOR'S
ADDN.
VICKERS ROCK ROAD ADD.
B & H
ADDITION
1040'
336'
139'
140'
225'
313.93'
404.10'
320'
282.88'
630.22'
200'
L = 446.11'
Δ = 36°00'
320.44'
270'
50'
75'
150'
125'
61'
25'
40'

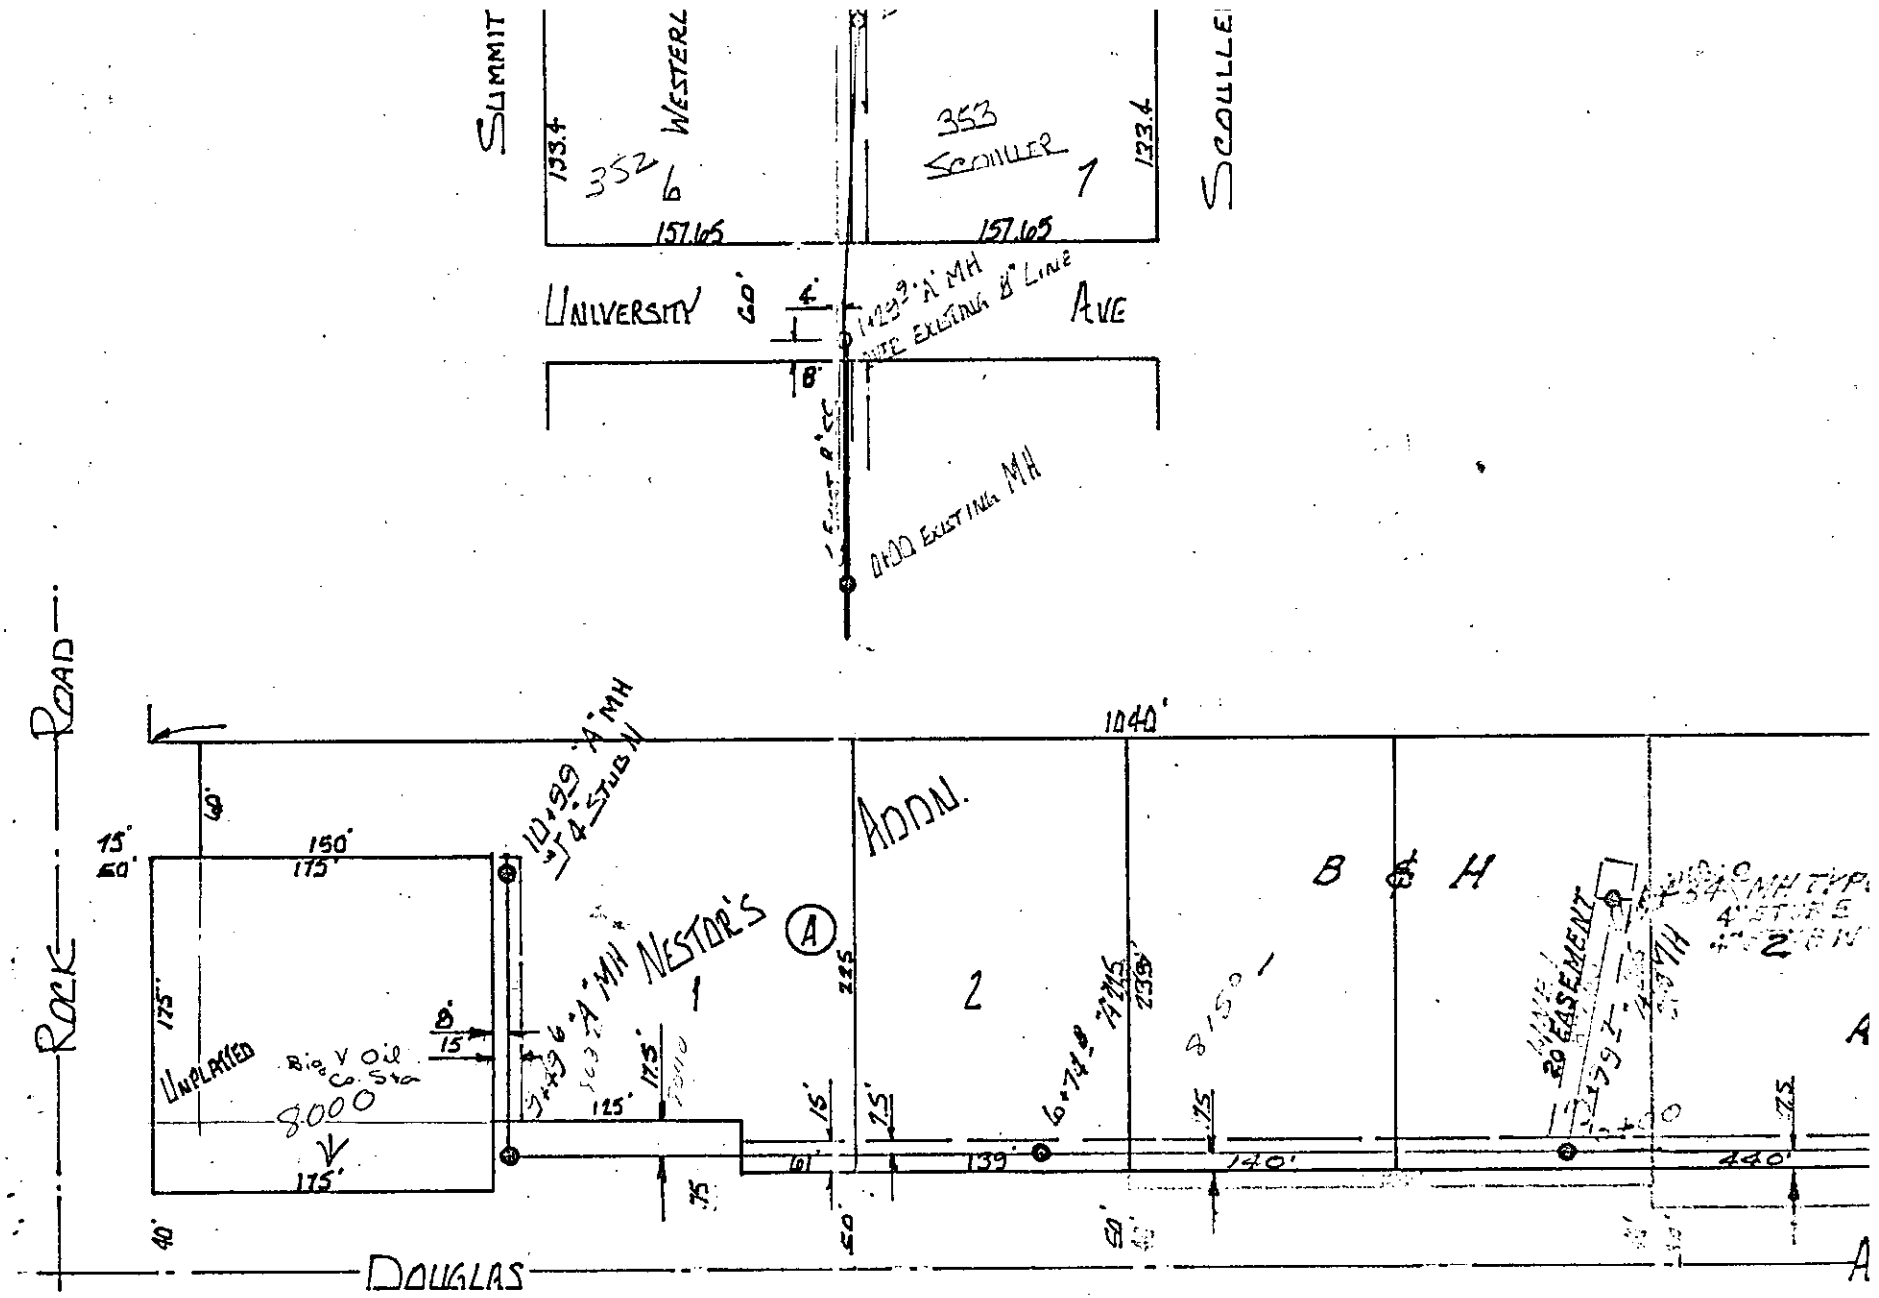

LAT 47, W.I.S.

BUILT BY: W.B. CARTER CONST. CO. INC
BOOKED 7 JUNE 72 FROM IH-78
PROJECT No DBKL569066
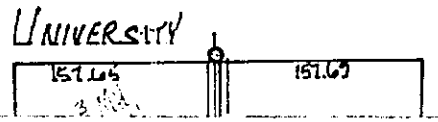
B&H ADDN.
BUILT BY:
PROJ. No 4
BOOKED 3-