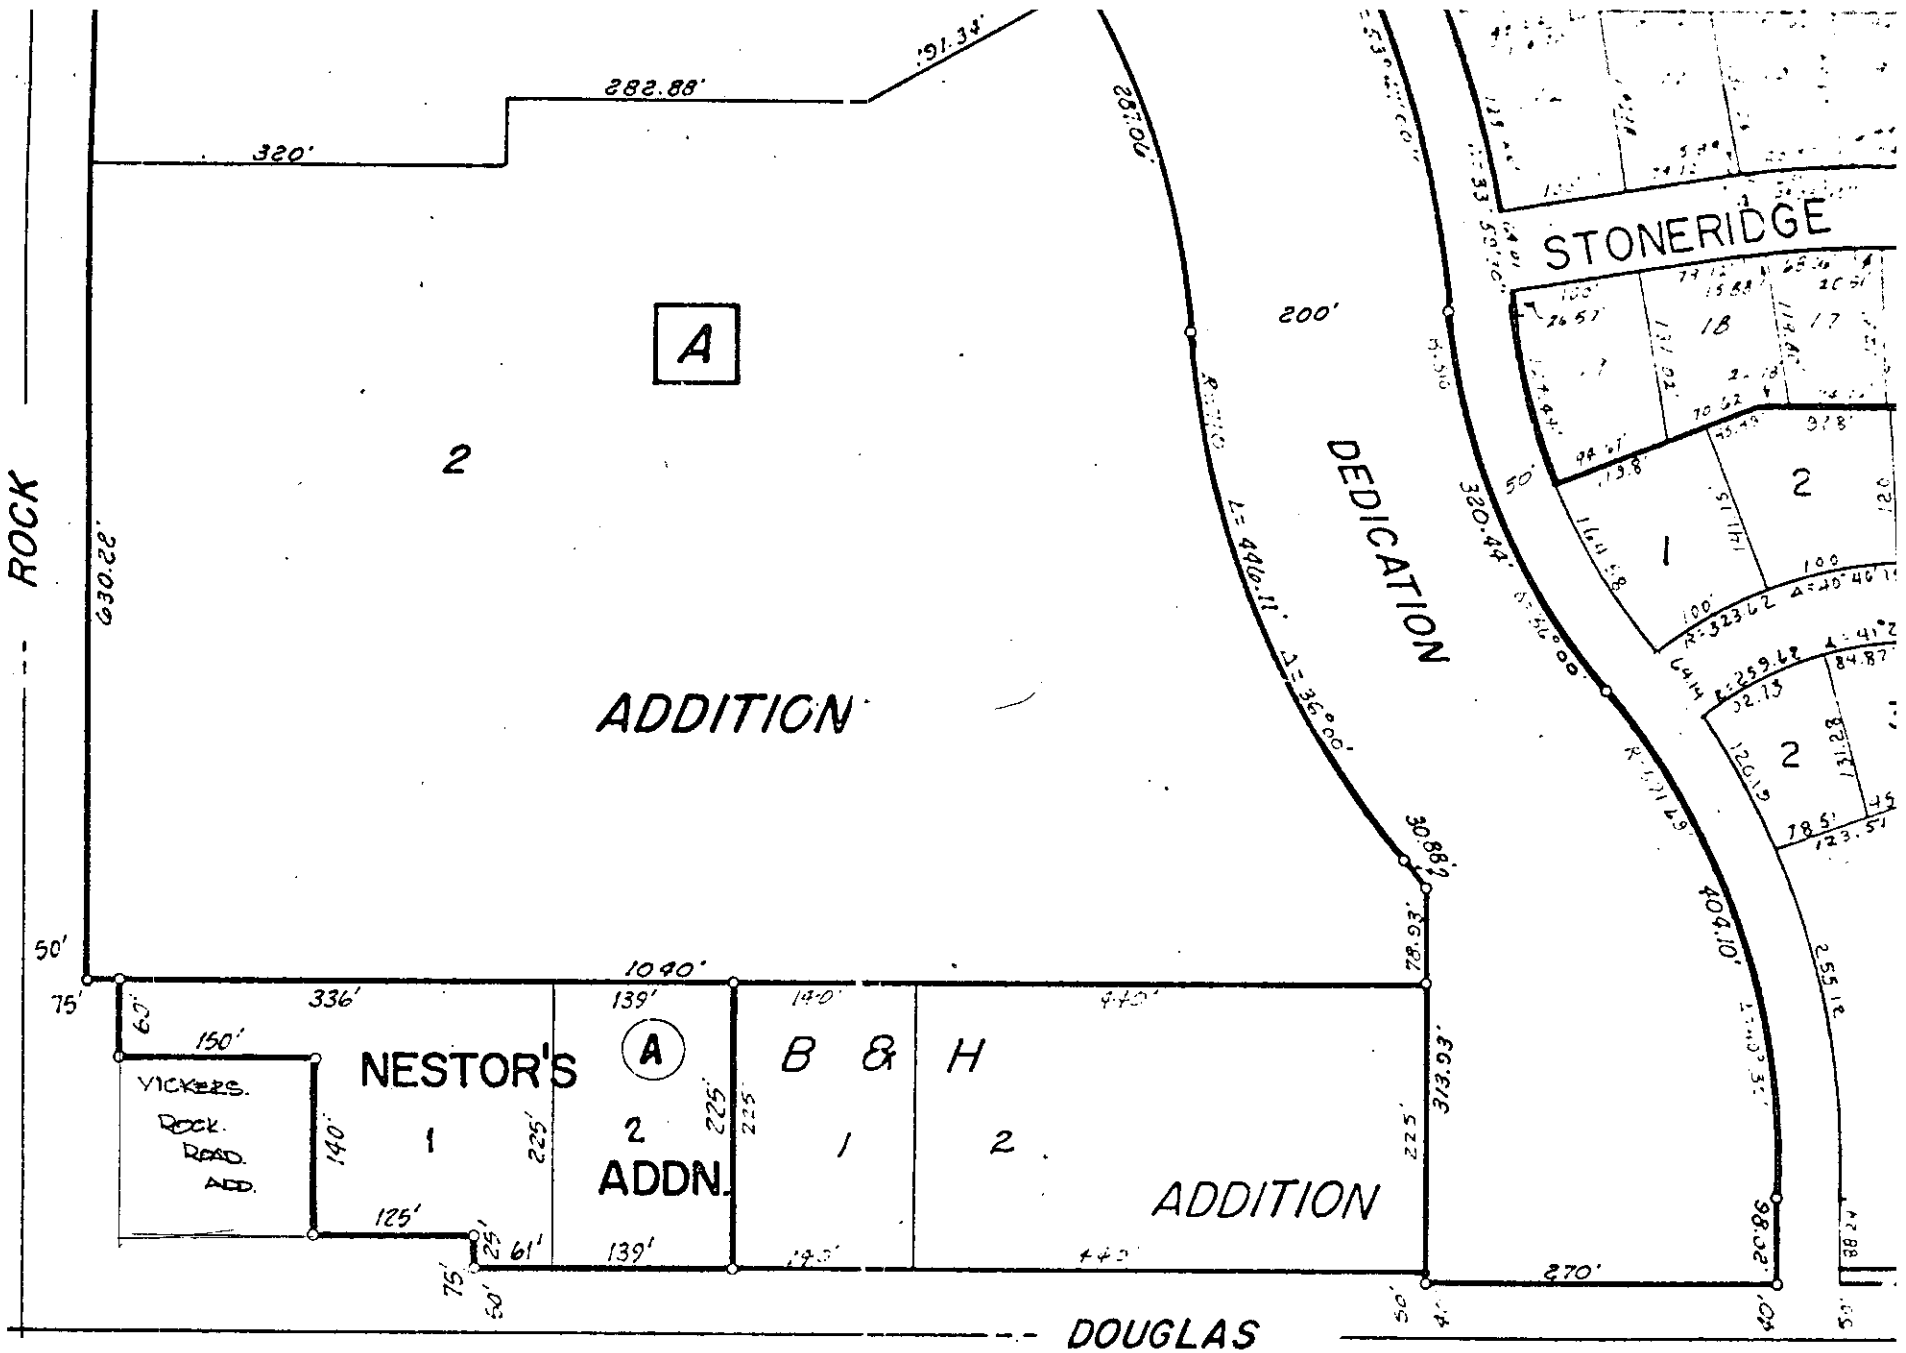
ROCK
DOUGLAS
DEDICATION
STONERIDGE
ADDITION
A
2
630.22'
320'
282.88'
191.34'
200'
L = 446.11'
Δ = 36°00'
320.44'
30.88'
78.93'
404.10'
313.93'
225'
1040'
336'
139'
140'
445'
75'
50'
67'
150'
140'
125'
25'
61'
270'
20.86'
NESTOR'S
ADDN.
1
2
B & H
VICKERS.
ROCK.
ROAD.
ADD.
18
17
1
2
R=323.62
R=259.62
84.87'
32.15'
131.28'
78.5'
123.57'
255.18'

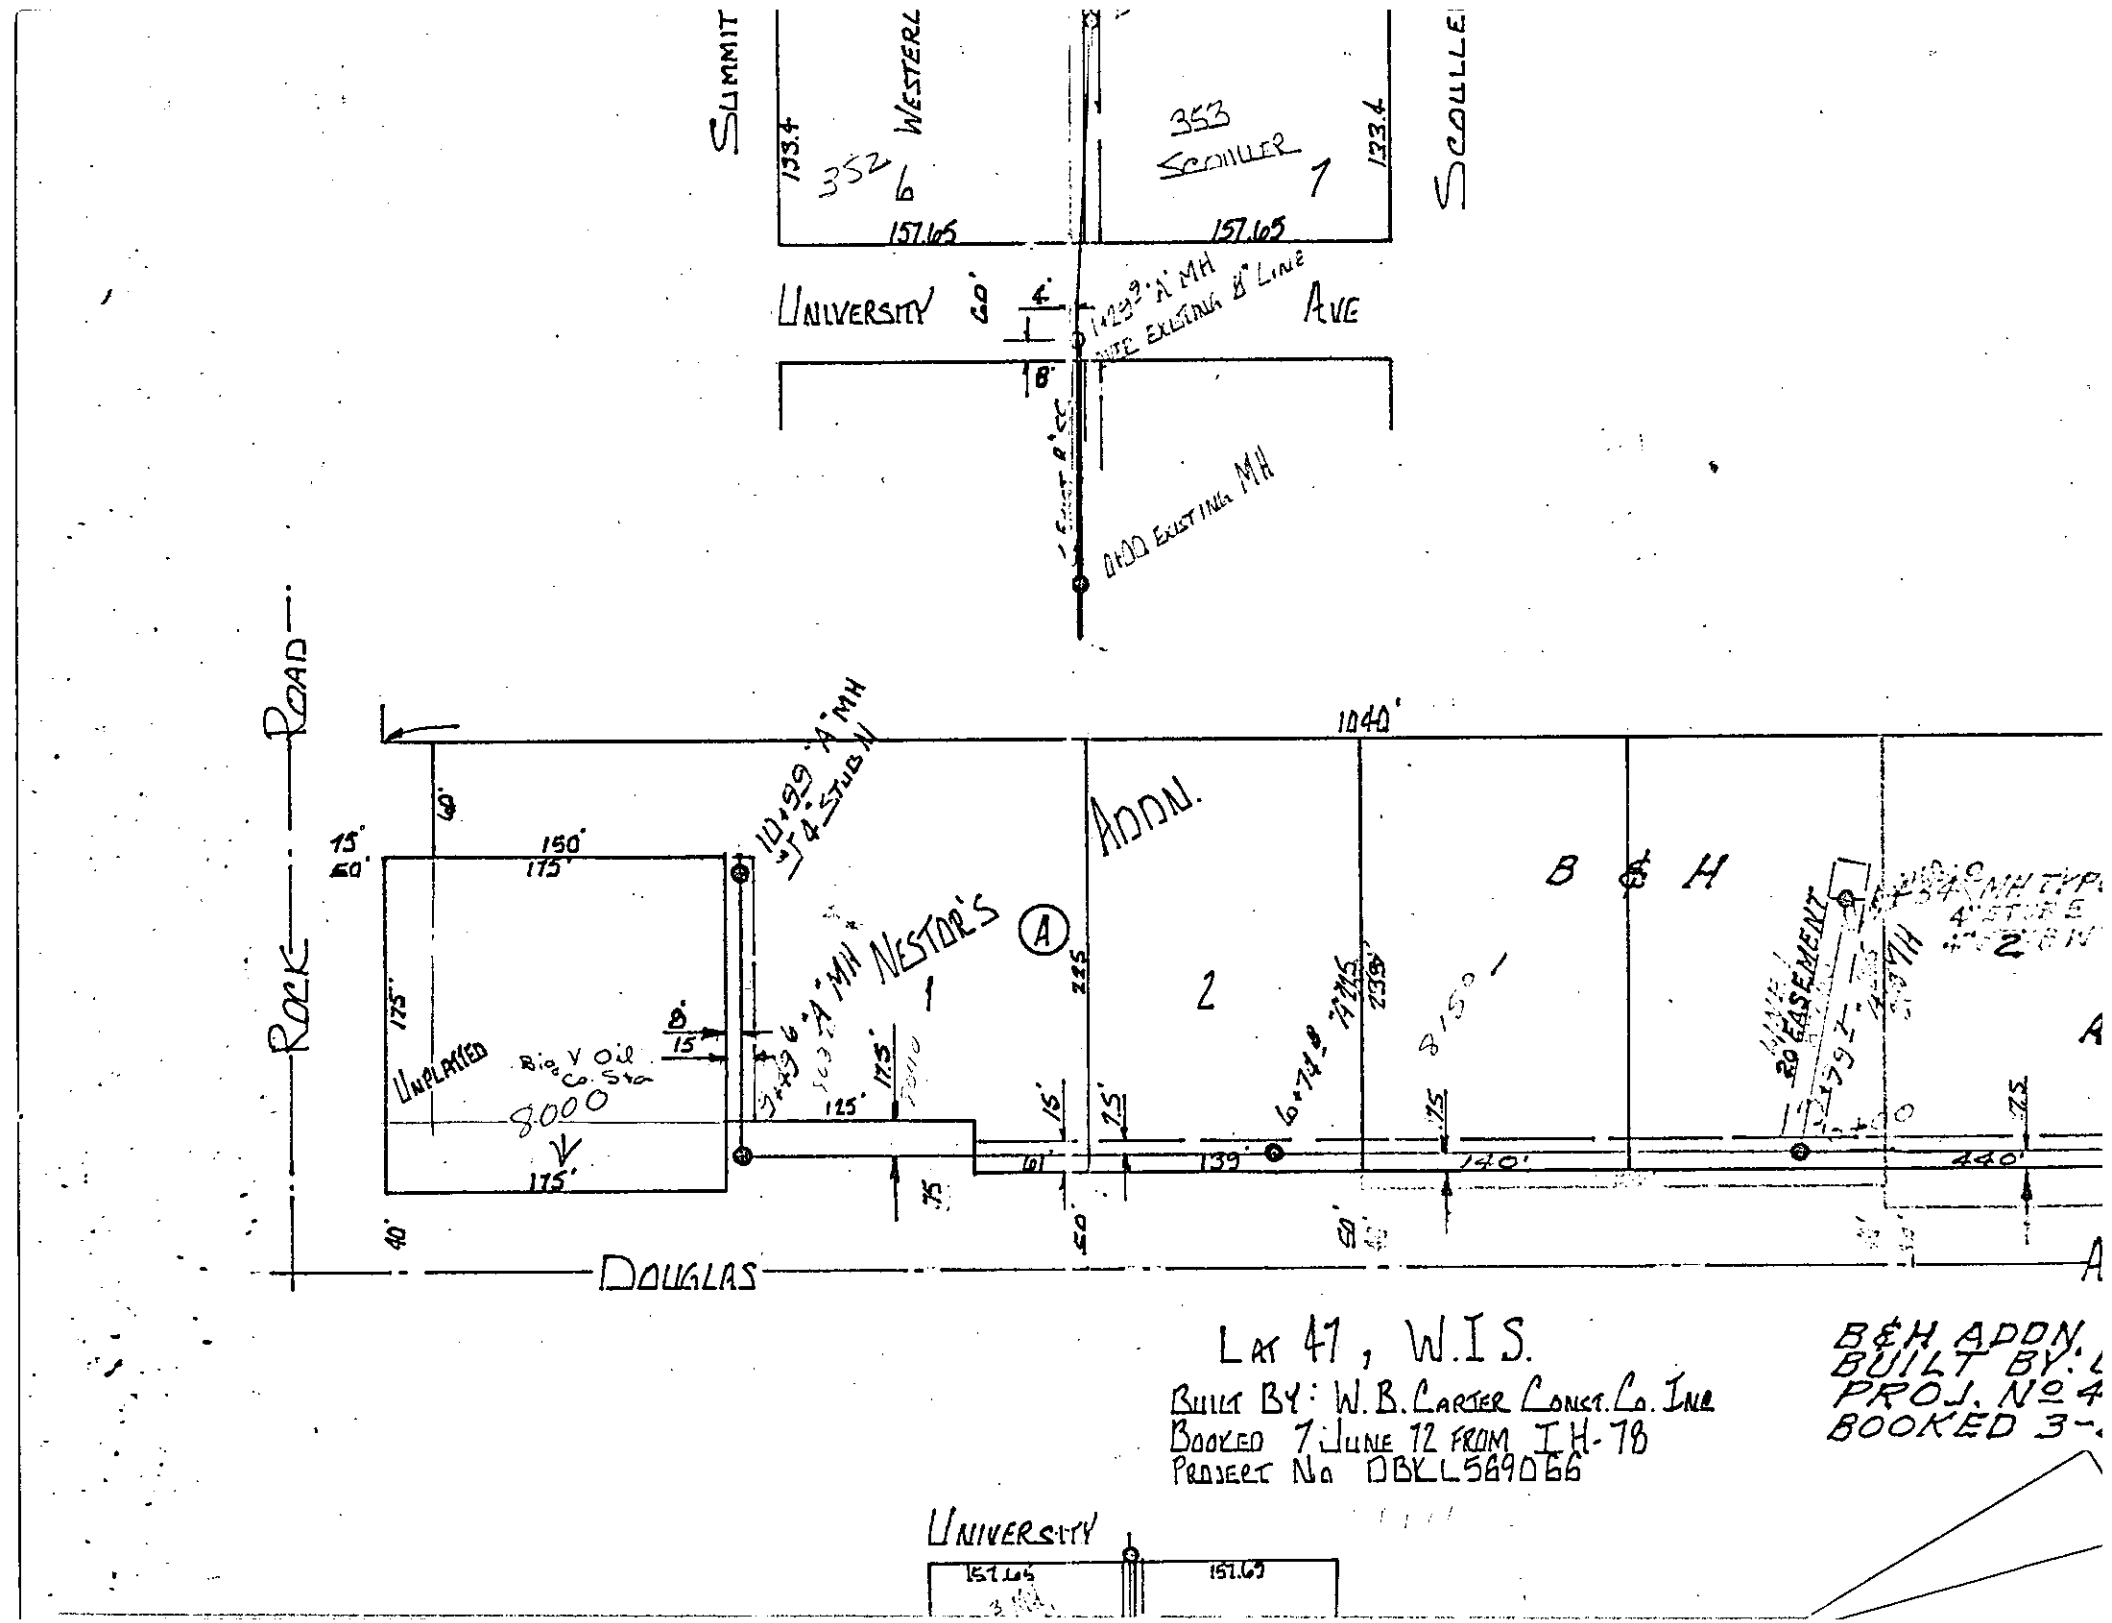
SUMMIT
WESTERL
352
6
133.4
157.165
353
SCHILLER
1
133.4
157.165
SCHILLER
UNIVERSITY
60'
4'
AVE
8"
1499' A' MH
NOTE EXISTING 8" LINE
1000 EXISTING MH
ROCK ROAD
1040'
15'
60'
150'
175'
175'
10'
15'
UNPLATTED
Bio V Oil Co. Sta
8.000
175'
40'
1099' A' MH
W/4" STUB N
3+39.6' A' MH
NESTOR'S
1
A
ADDN.
225
2
B & H
6°74.8'
139'
8150'
20' EASEMENT
125'
175'
15'
15'
61'
139'
140'
440'
50'
50'
DOUGLAS
LAT 47, W.I.S.
BUILT BY: W.B. CARTER CONST. CO. INC
BOOKED 7 JUNE 72 FROM I.H. 78
PROJECT No DBKL569066
B&H ADDN.
BUILT BY:
PROJ. No 4
BOOKED 3-
UNIVERSITY
157.165
157.165