

DATE DRAWN: 11/14/84
REVISIONS:
PRINTS ISSUED: 0-11-84

JEFFREHBIEL
ASSOCIATES
ARCHITECTS

MADISON MANOR
SENIOR ACTIVITY CENTER &
SENIOR RESIDENCES
21ST STREET NORTH, WICHITA, KANSAS

PROJECT NAME:
LOCATION:
MEET TIME:
SITE DEVELOPMENT:
FLOOR PLAN:


SHEET NUMBER:
1

DATE



*See main
? Corridor build -
porch's in these
at these locations*

21ST STREET NORTH

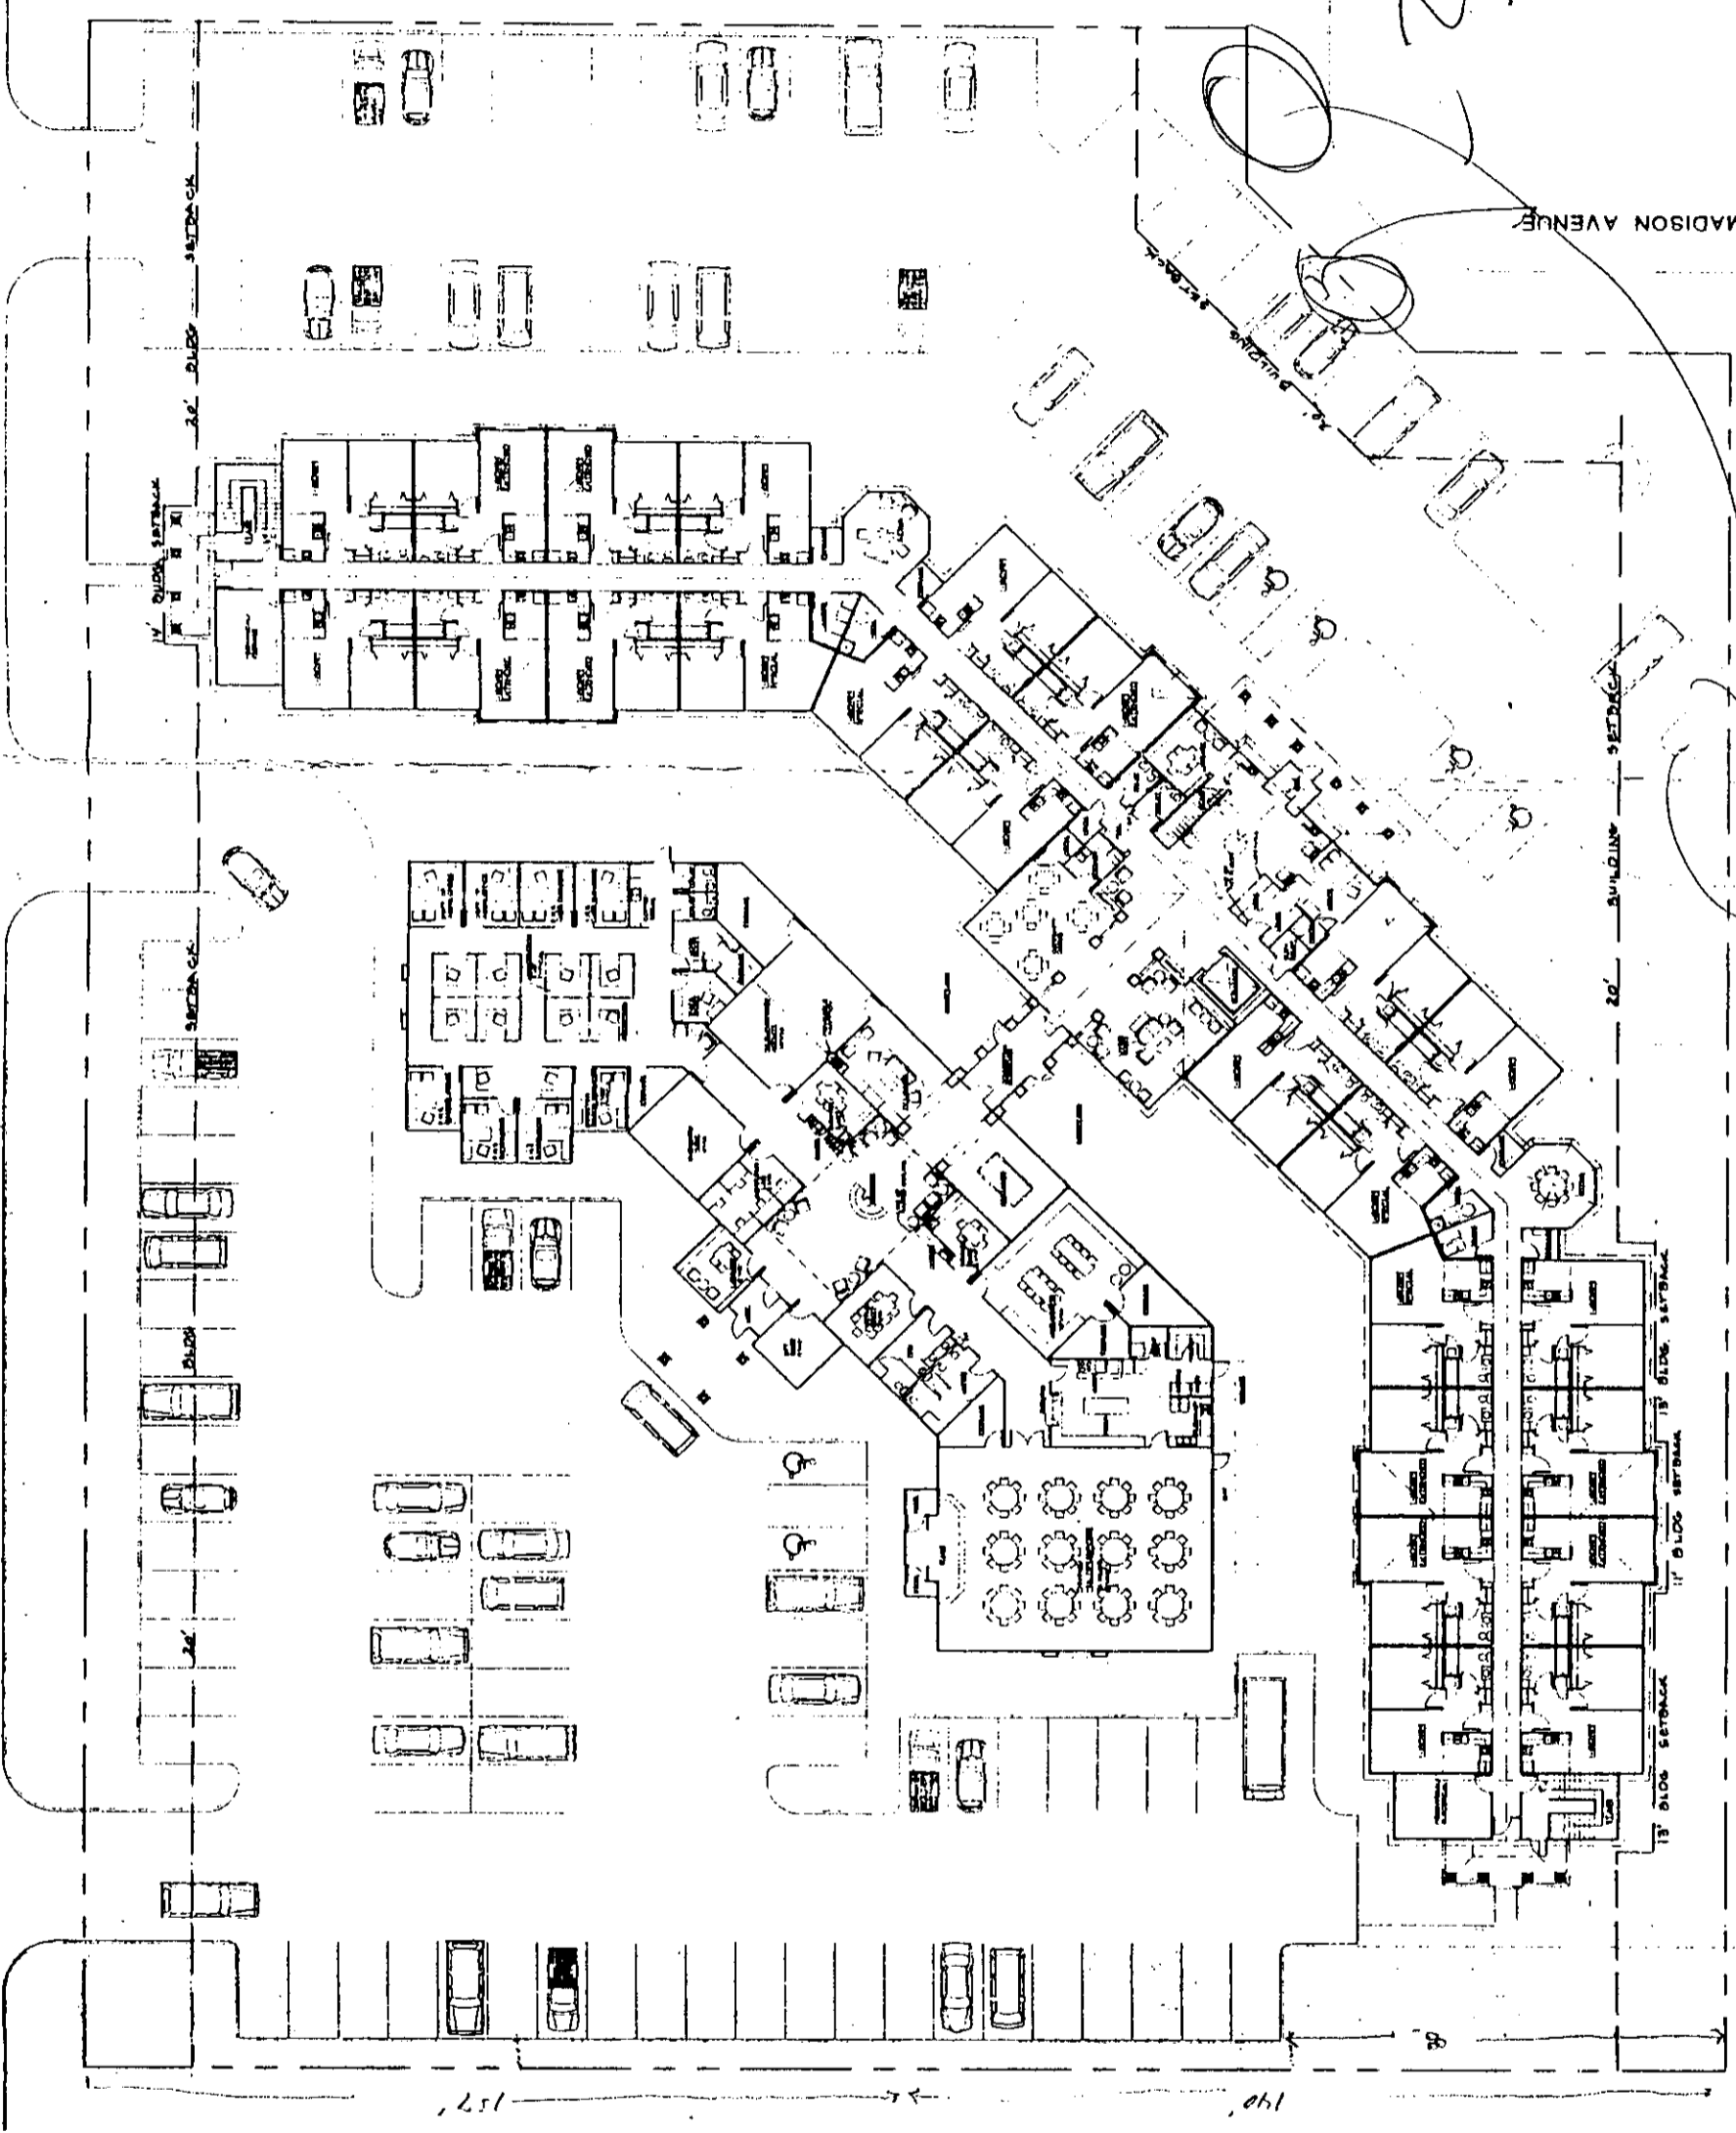

STADIUM DRIVE

FIRST FLOOR/SITE PLAN
SCALE: 1" = 16'-0"

