



MID-KANSAS ENGINEERING
CONSULTANTS, P.A.
3500 N. Rock Road, #800
Wichita, KS 67226

PROJECT: Sidewalks within Lakepoint

PROJECT #: _____ DATE: 04/17/87

TO: Mr. Michael E. Lindebak
Engineering Department
455 N. Main, 7th Floor
Wichita, KS 67202

Per our meeting of Friday, April 10, 1987 it is our understanding that sidewalks within the Lakepoint Development can be handled as shown on the enclosed exhibit.

We will work with Mr. Carl Gipson in amending the filed petitions to reflect the conclusions reached.

Your assistance in this matter is appreciated.

MID-KANSAS ENGINEERING CONSULTANTS, P.A.

Kenneth H. Bengtson


Kenneth H. Bengtson, P.E.

KHB/dh

cc: Jack Ritchie
Dave Ritchie
Jack Galbraith
Carl Gipson ✓

CHB



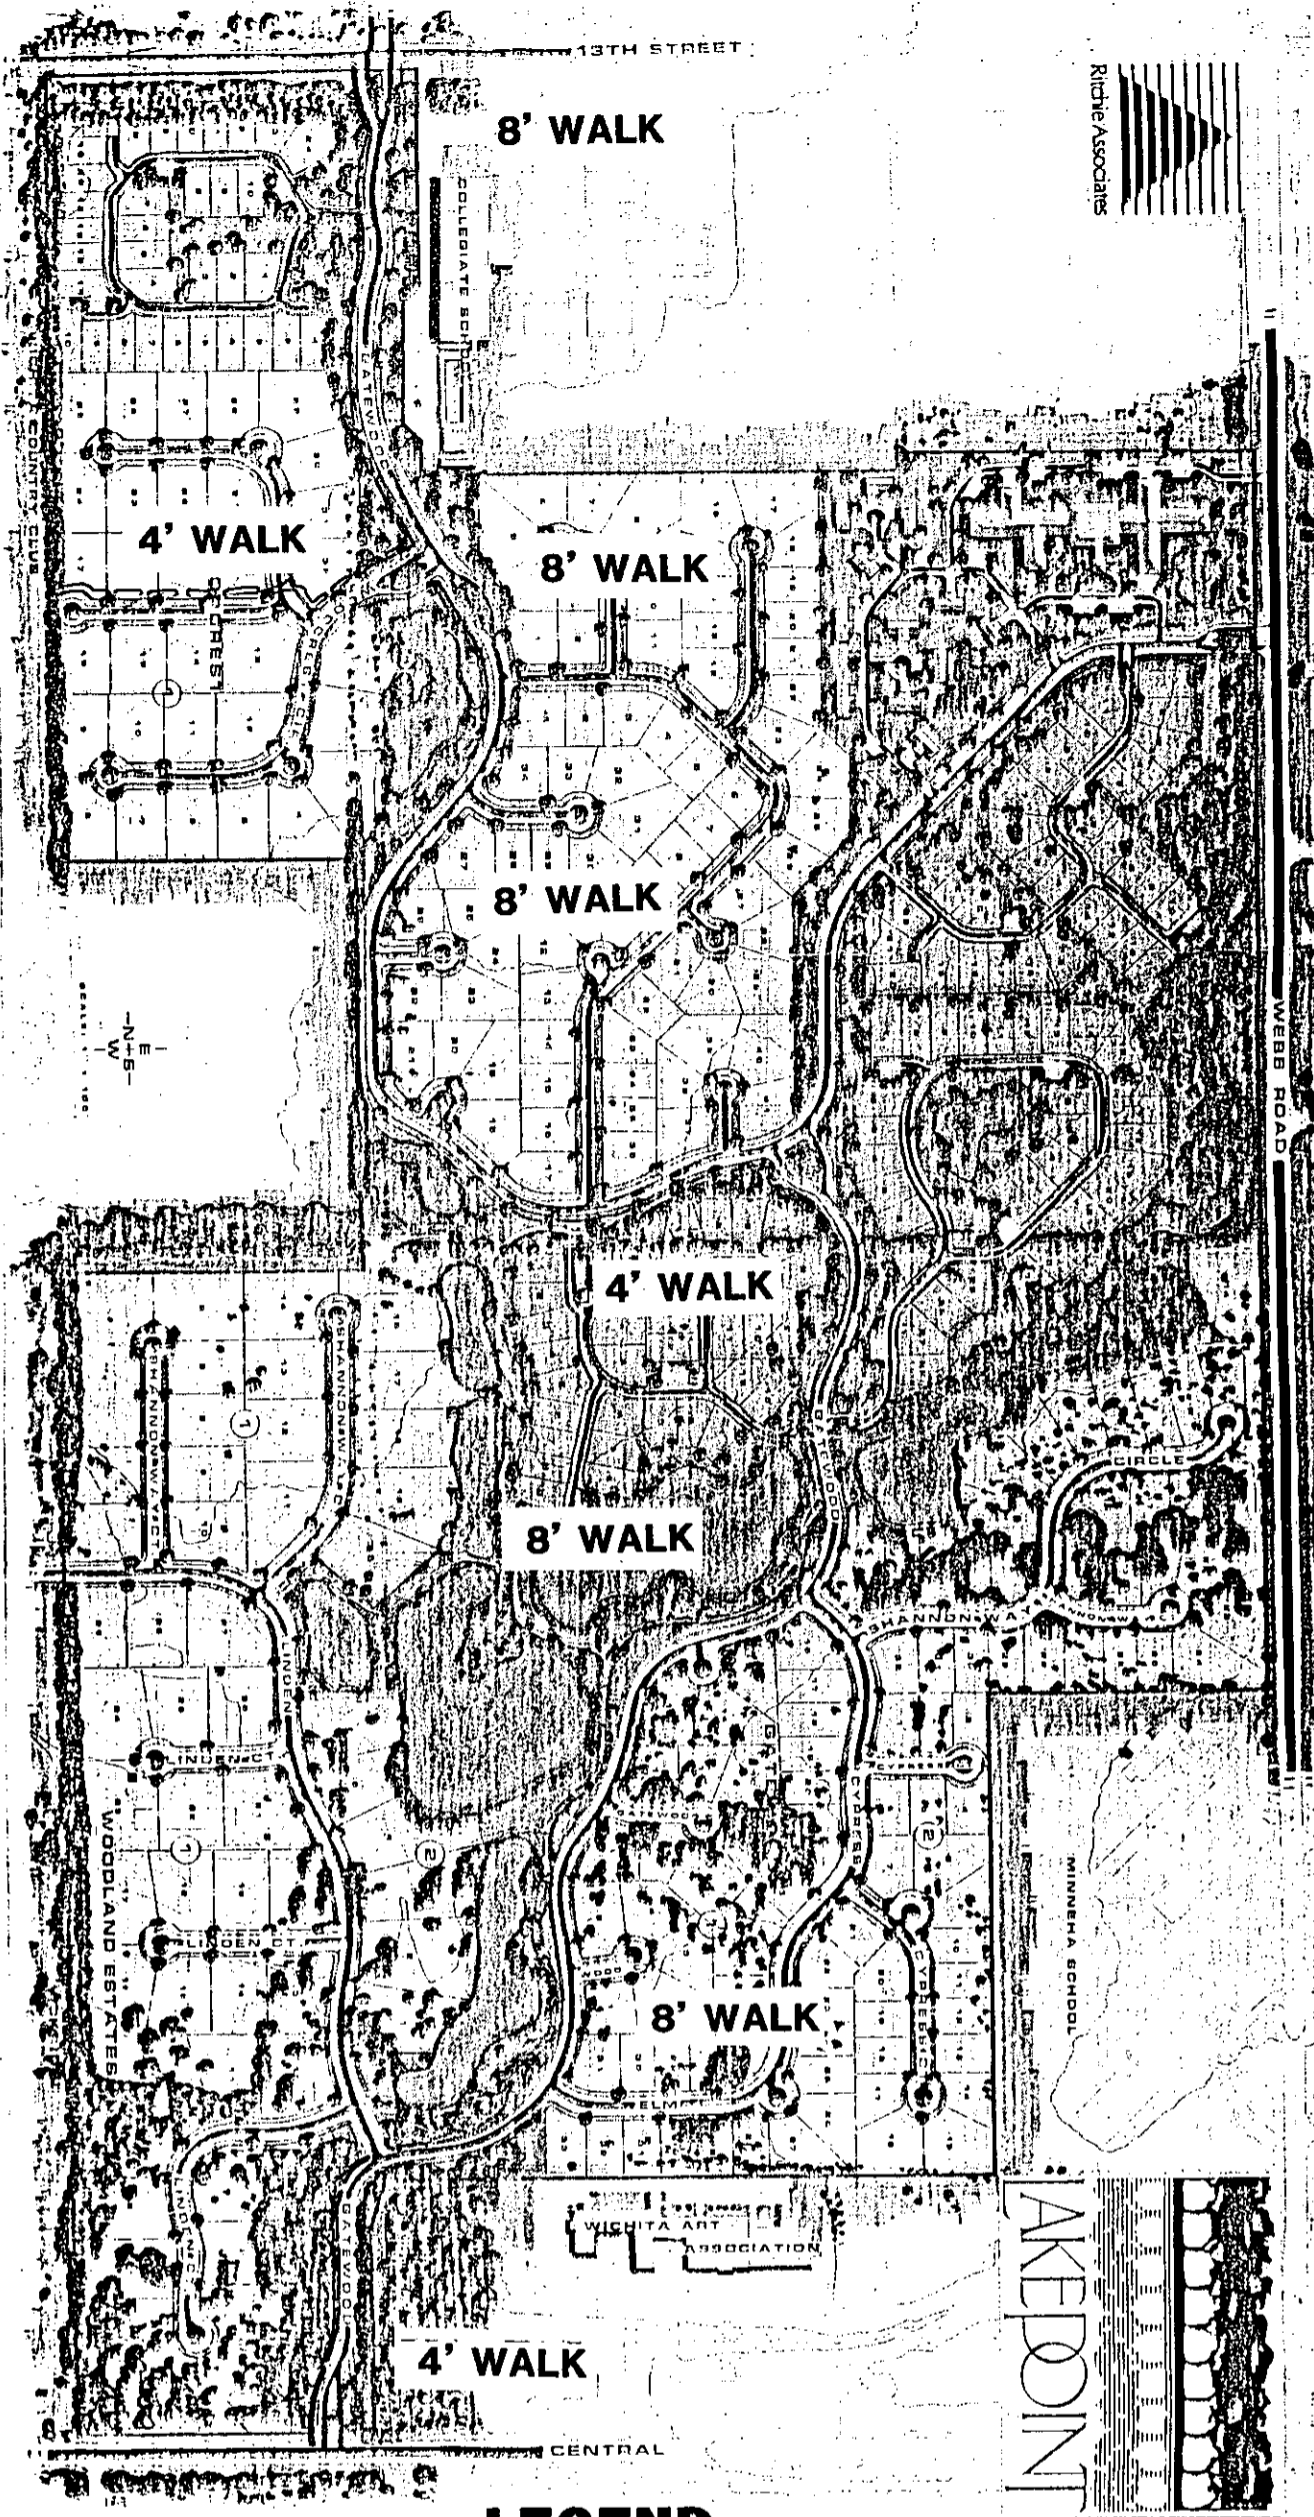

LEGEND

- WALK WITHIN WOODCREST
- WALK WITHIN AUTUMN CHASE
- WALK WITHIN GATEWOOD CONTRACT
- WALK WITHIN WOODLANDS ESTATES CONTRACT