


PRELIMINARY PLAT

CIVIC CENTER SOUTH 2nd ADDITION

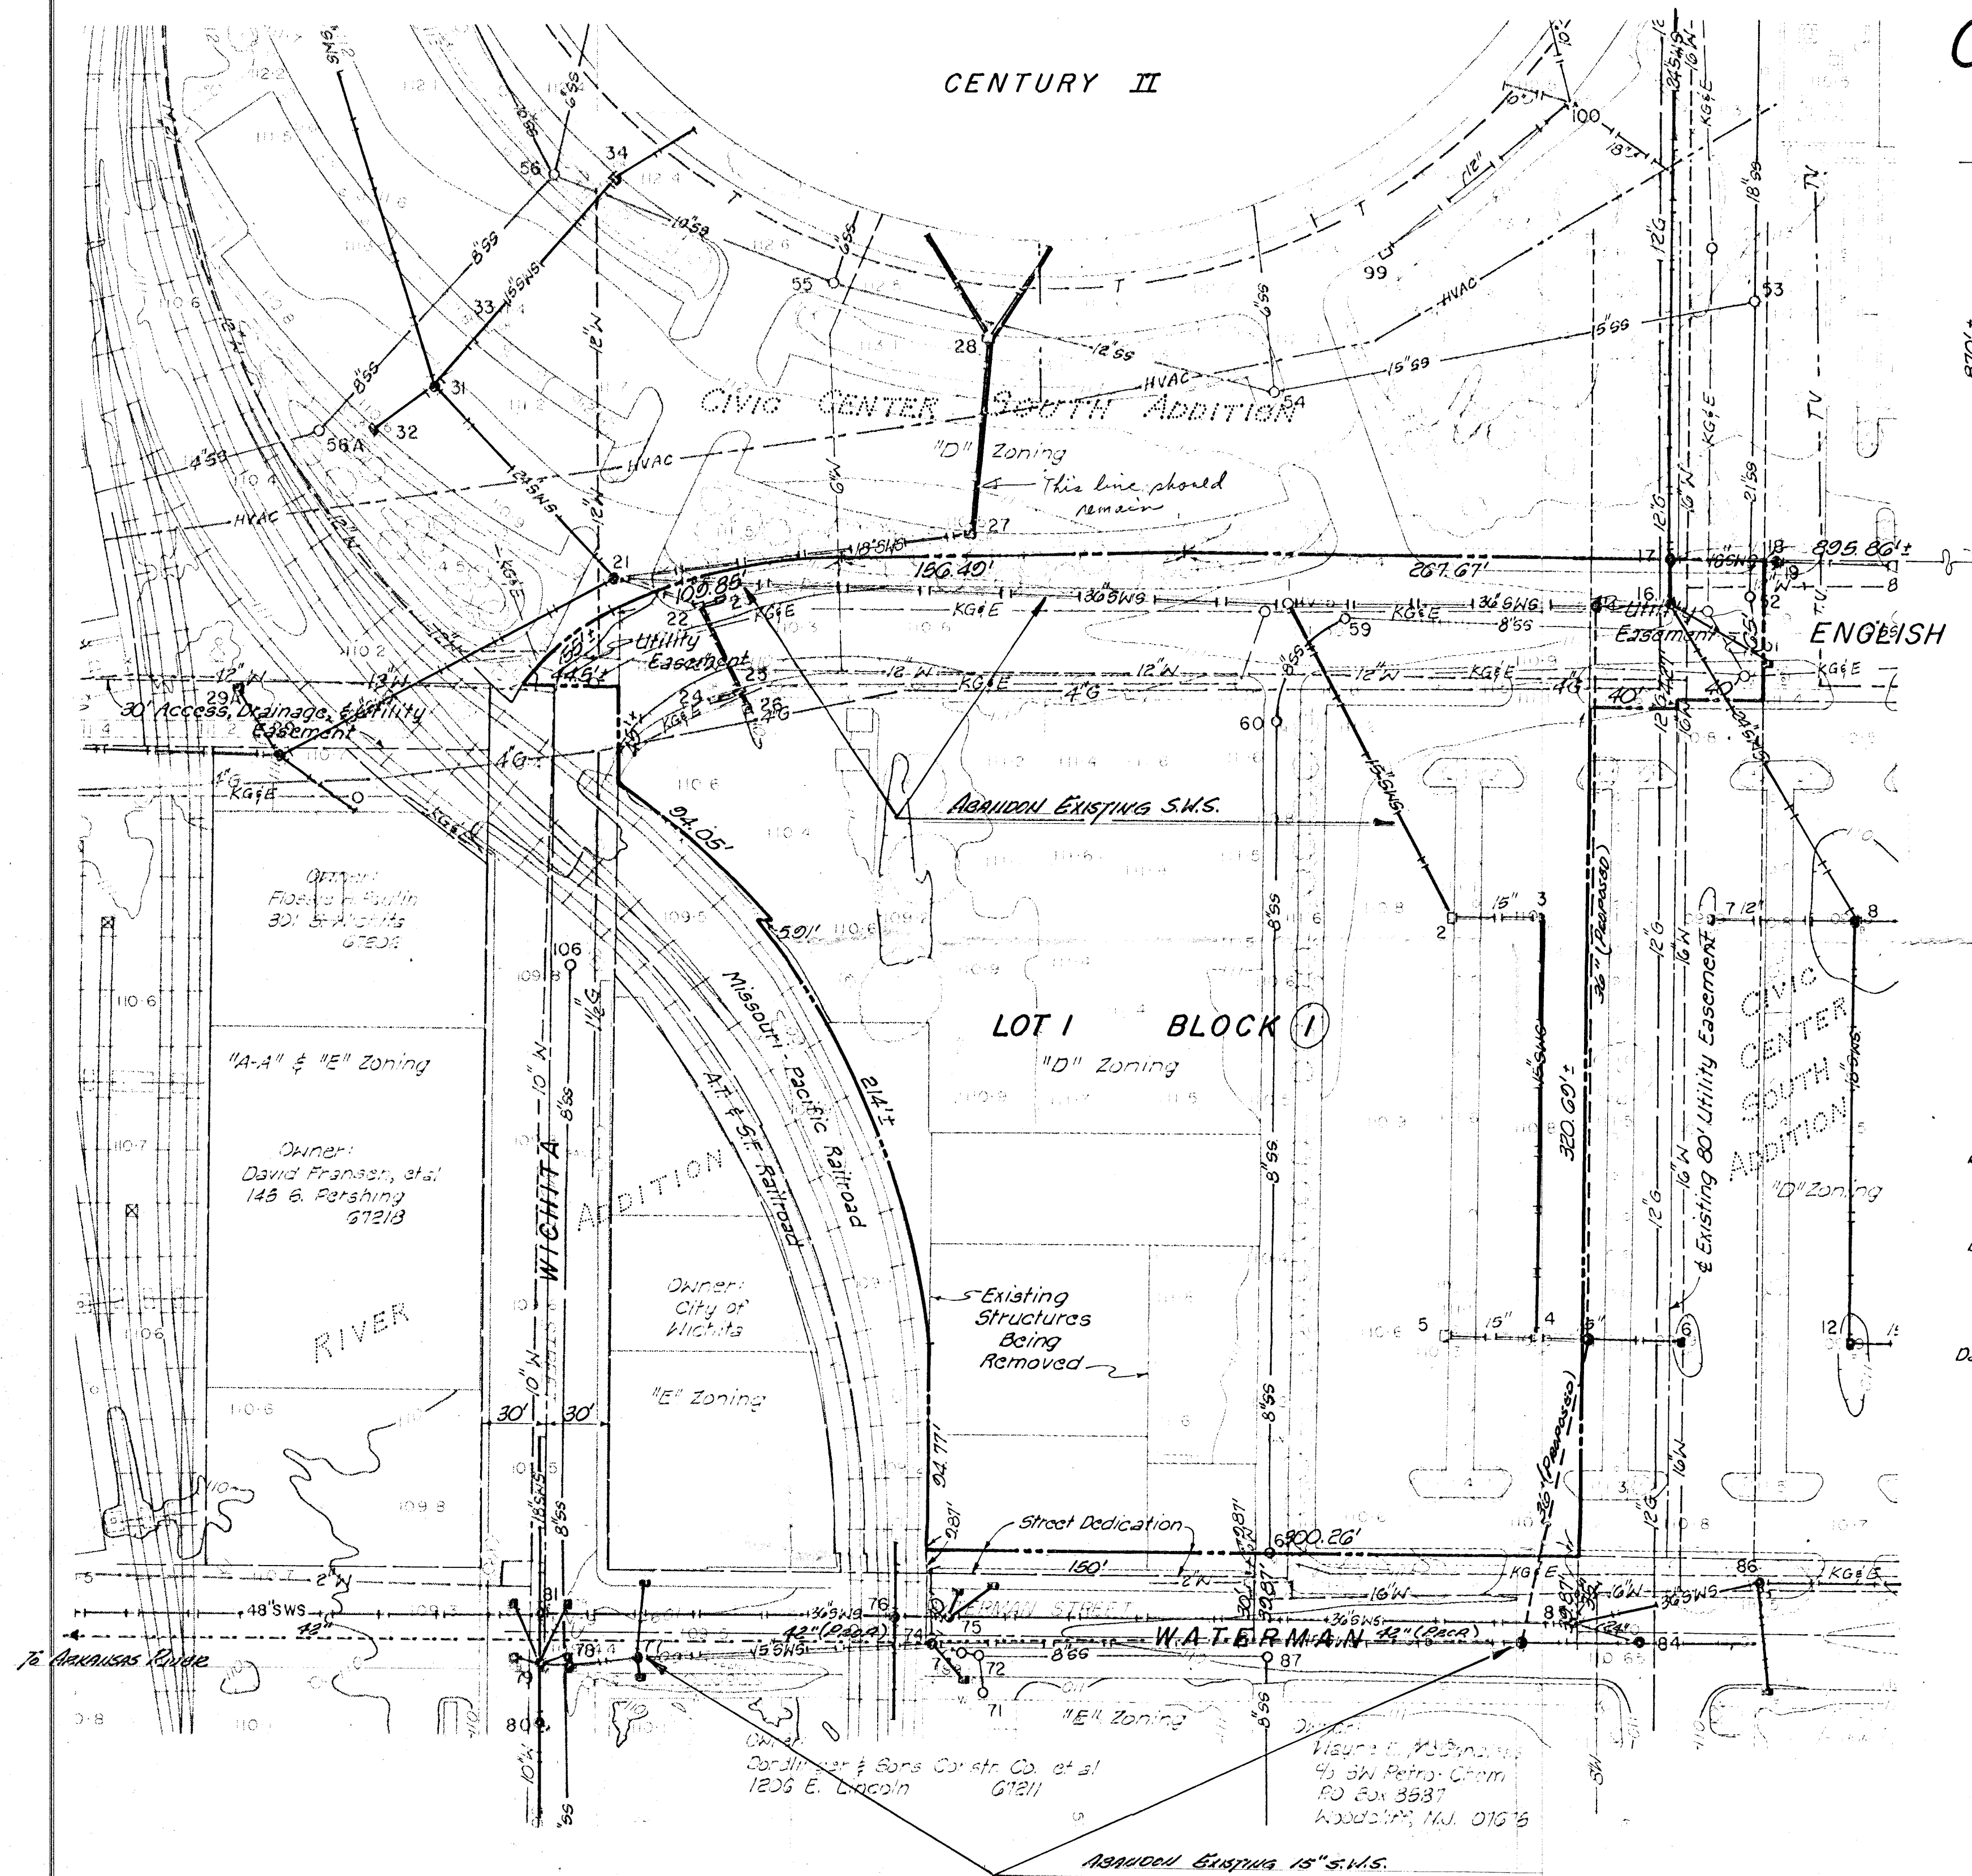

N.E. Cor. SE 1/4, Sec. 20,
T27S, R1E, G1h RM

Scale: 1"=50'
September 12, 1983

BM- Arkansas River & Douglas - U.S.G.S.
Gaging Sta. Disc, southeast corner
bridge. Elev. 115.89 City Datum

BM- Arkansas River & Lewis - City of
Wichita Bench Mark Disc, sidewalk
northeast corner bridge.
Elev. 112.68 City Datum

Date of Topography- February, 1983

Owner: City of Wichita
% James Clancy
Director of Community Facilities
Century II - 255 W. Douglas 67202
Board of Park Commissioners
% Tom Allen
Director of Parks
455 N. Main
Wichita, Ks. 67202

Engineer: Professional Engineering Consultants, P.A.
1440 E. English
Wichita, Kansas 67211

DRAINAGE CONCEPT

- EXISTING S.W.S. TO REMAIN
- EXISTING S.W.S. TO BE ABANDONED
- PROPOSED S.W.S.

THE LOT SHALL BE GRADED TO DRAIN TO THE STREETS,
GUTTERS, OR EXISTING AND/OR PROPOSED STORM
WATER SEWERS, VIA DROPS, FLUMES, STEAM WATER
SEWERS AND/OR ANY OTHER APPROVED DRAINAGE FACILITIES.

