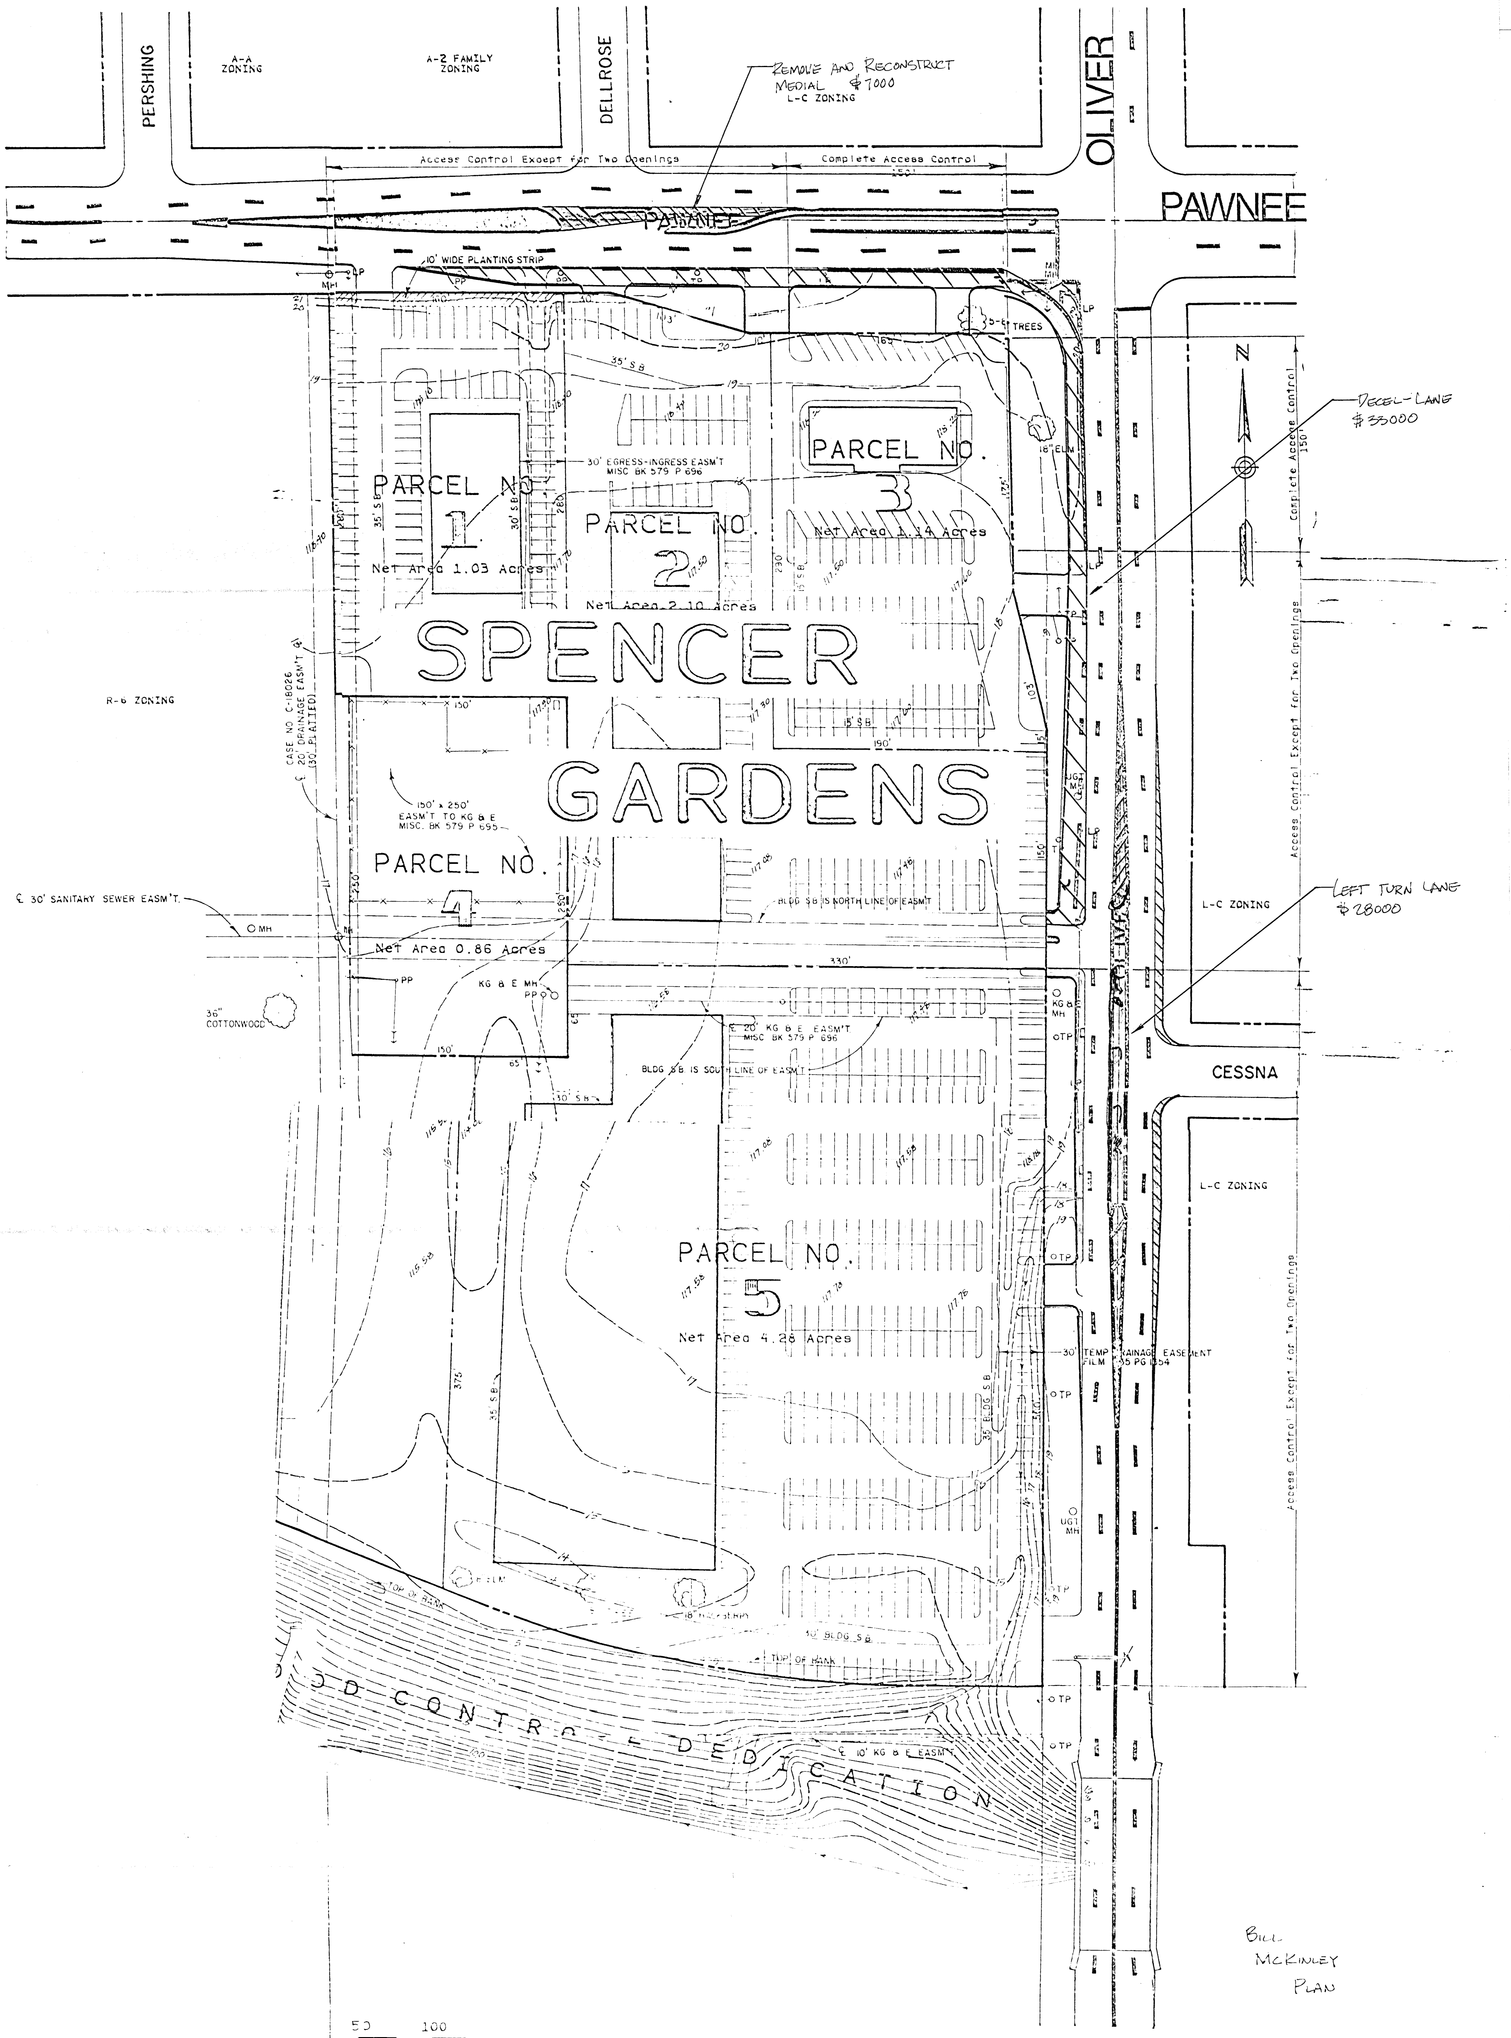

COMMUNITY UNIT PLAI
2ND

ISAS, INC.
ERS