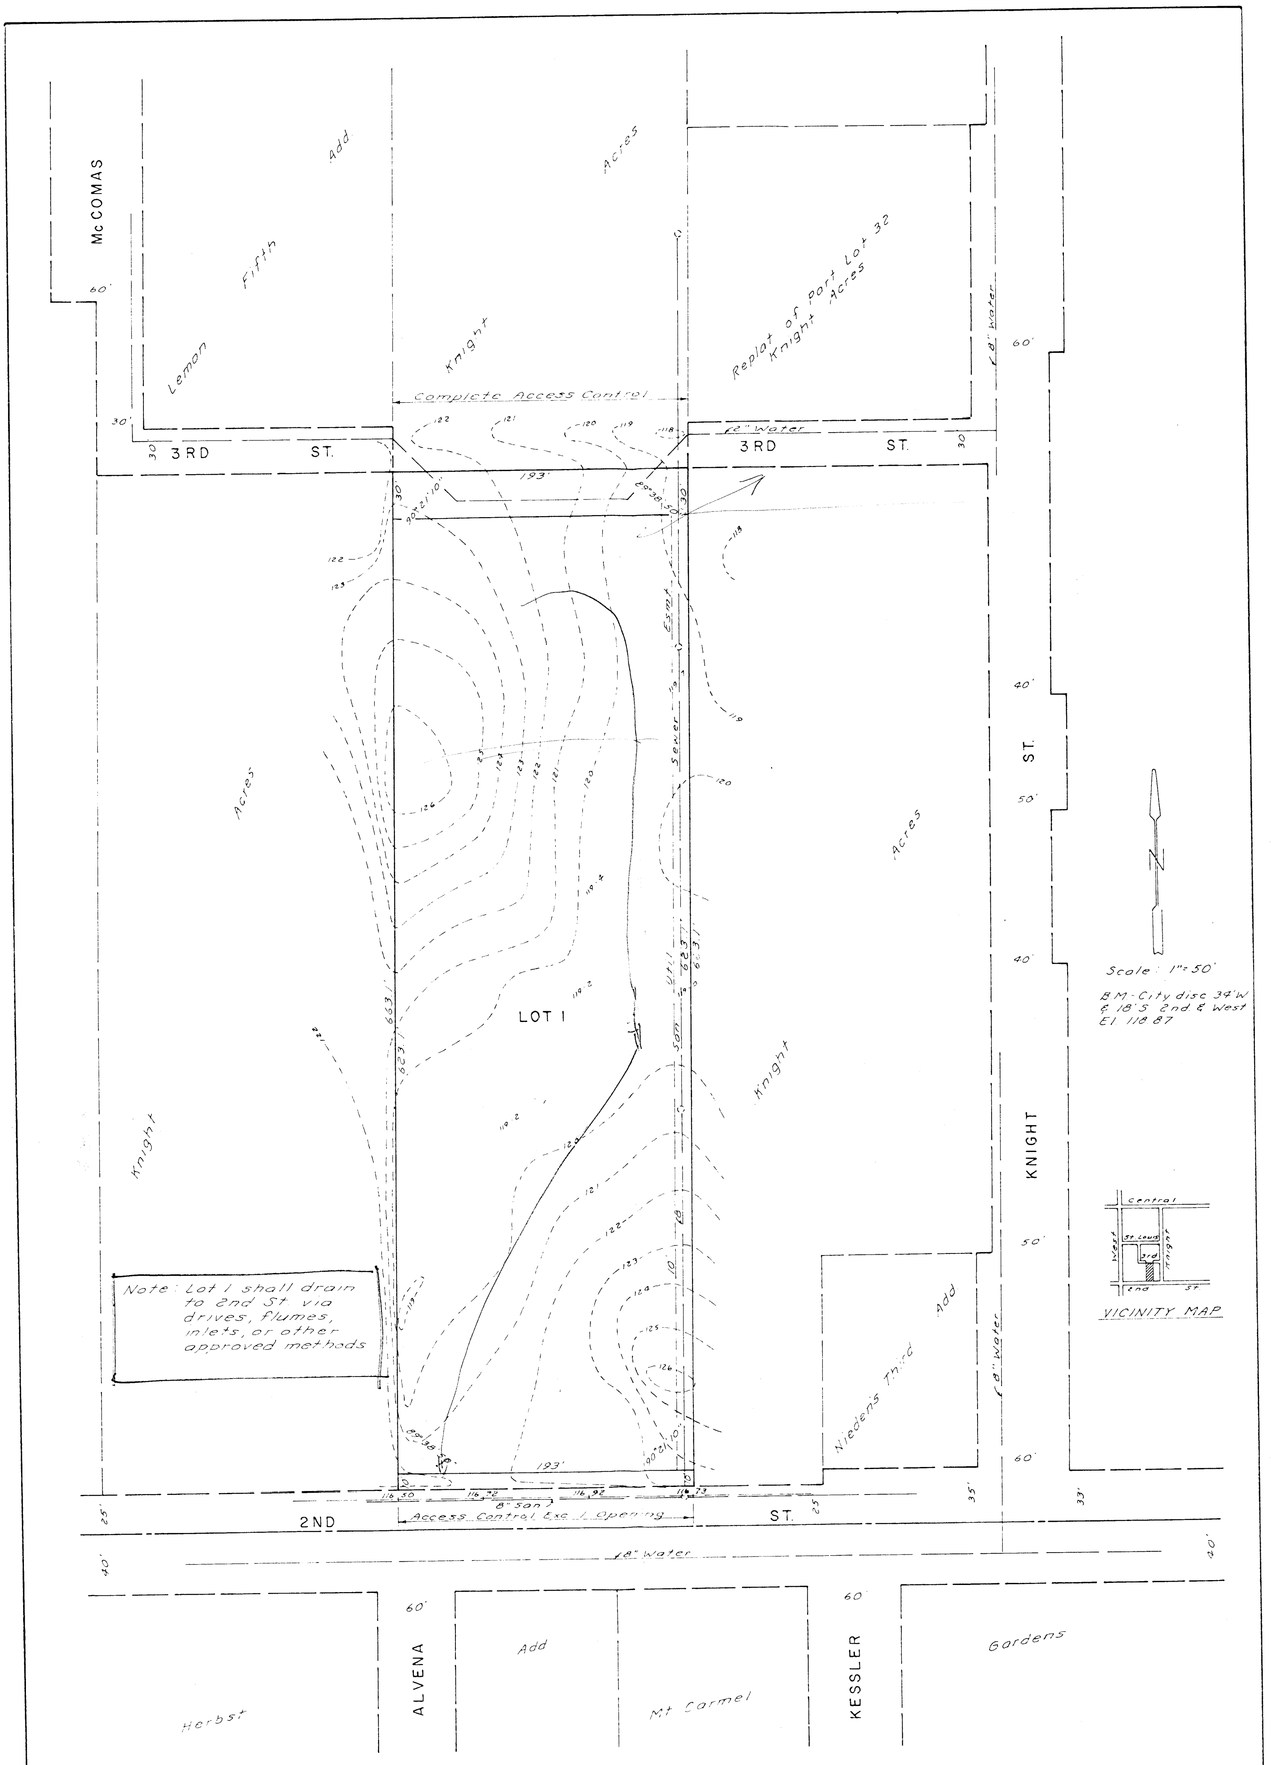

SKETCH PLAT

TWIN OAKS ADDITION

A REPLAT OF LOT 43, KNIGHT ACRES

BAUGHMAN COMPANY, P.A.
SURVEYING & ENGINEERING
316/262-7271 • 330 LAURA • WICHITA, KANSAS 67211