



DONDLINGER & SONS CONSTRUCTION CO., INC.

General Contractors

RAY DONDLINGER
JOE DONDLINGER
LEO DONDLINGER

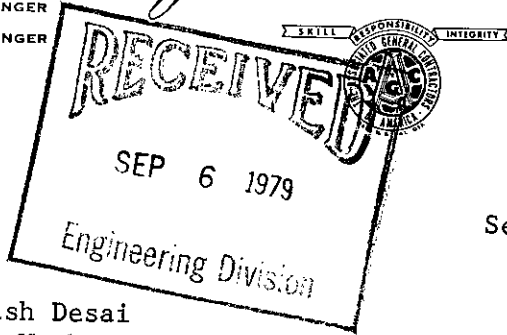

*Ty Cen Addition
Copy in SWS 162 Folder*

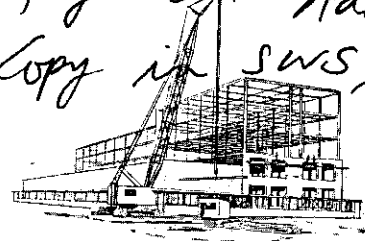

P. O. BOX 398 WICHITA, KANSAS 67201
TEL. 265-3101

September 4, 1979

Mr. Yash Desai
Public Works
City of Wichita
455 North Main
Wichita, Kansas 67201

Re: Inlet Revision - Wichita Federal
Savings & Loan - Branch Facility
5525 West Central, Wichita, Ks.

Dear Yash:

Please find enclosed Inlet Revision for your files.

If you have any questions, please call me.

Yours very truly,

DONDLINGER & SONS CONST. CO., INC.

BY *Tom Dondlinger*
Tom Dondlinger, Vice-President

TD:pr


Enclosure

cc: Greg Wilhite - Jeff Krehbiel Assoc.
cc: Job

STORR DRAINAGE
WICHITA FEDERAL SAVINGS AND LOAN

CENTRAL AVENUE Revised Inlet 9.4.79

WICHITA FEDERAL SAVINGS & LOAN
TOP GROUND 46.3

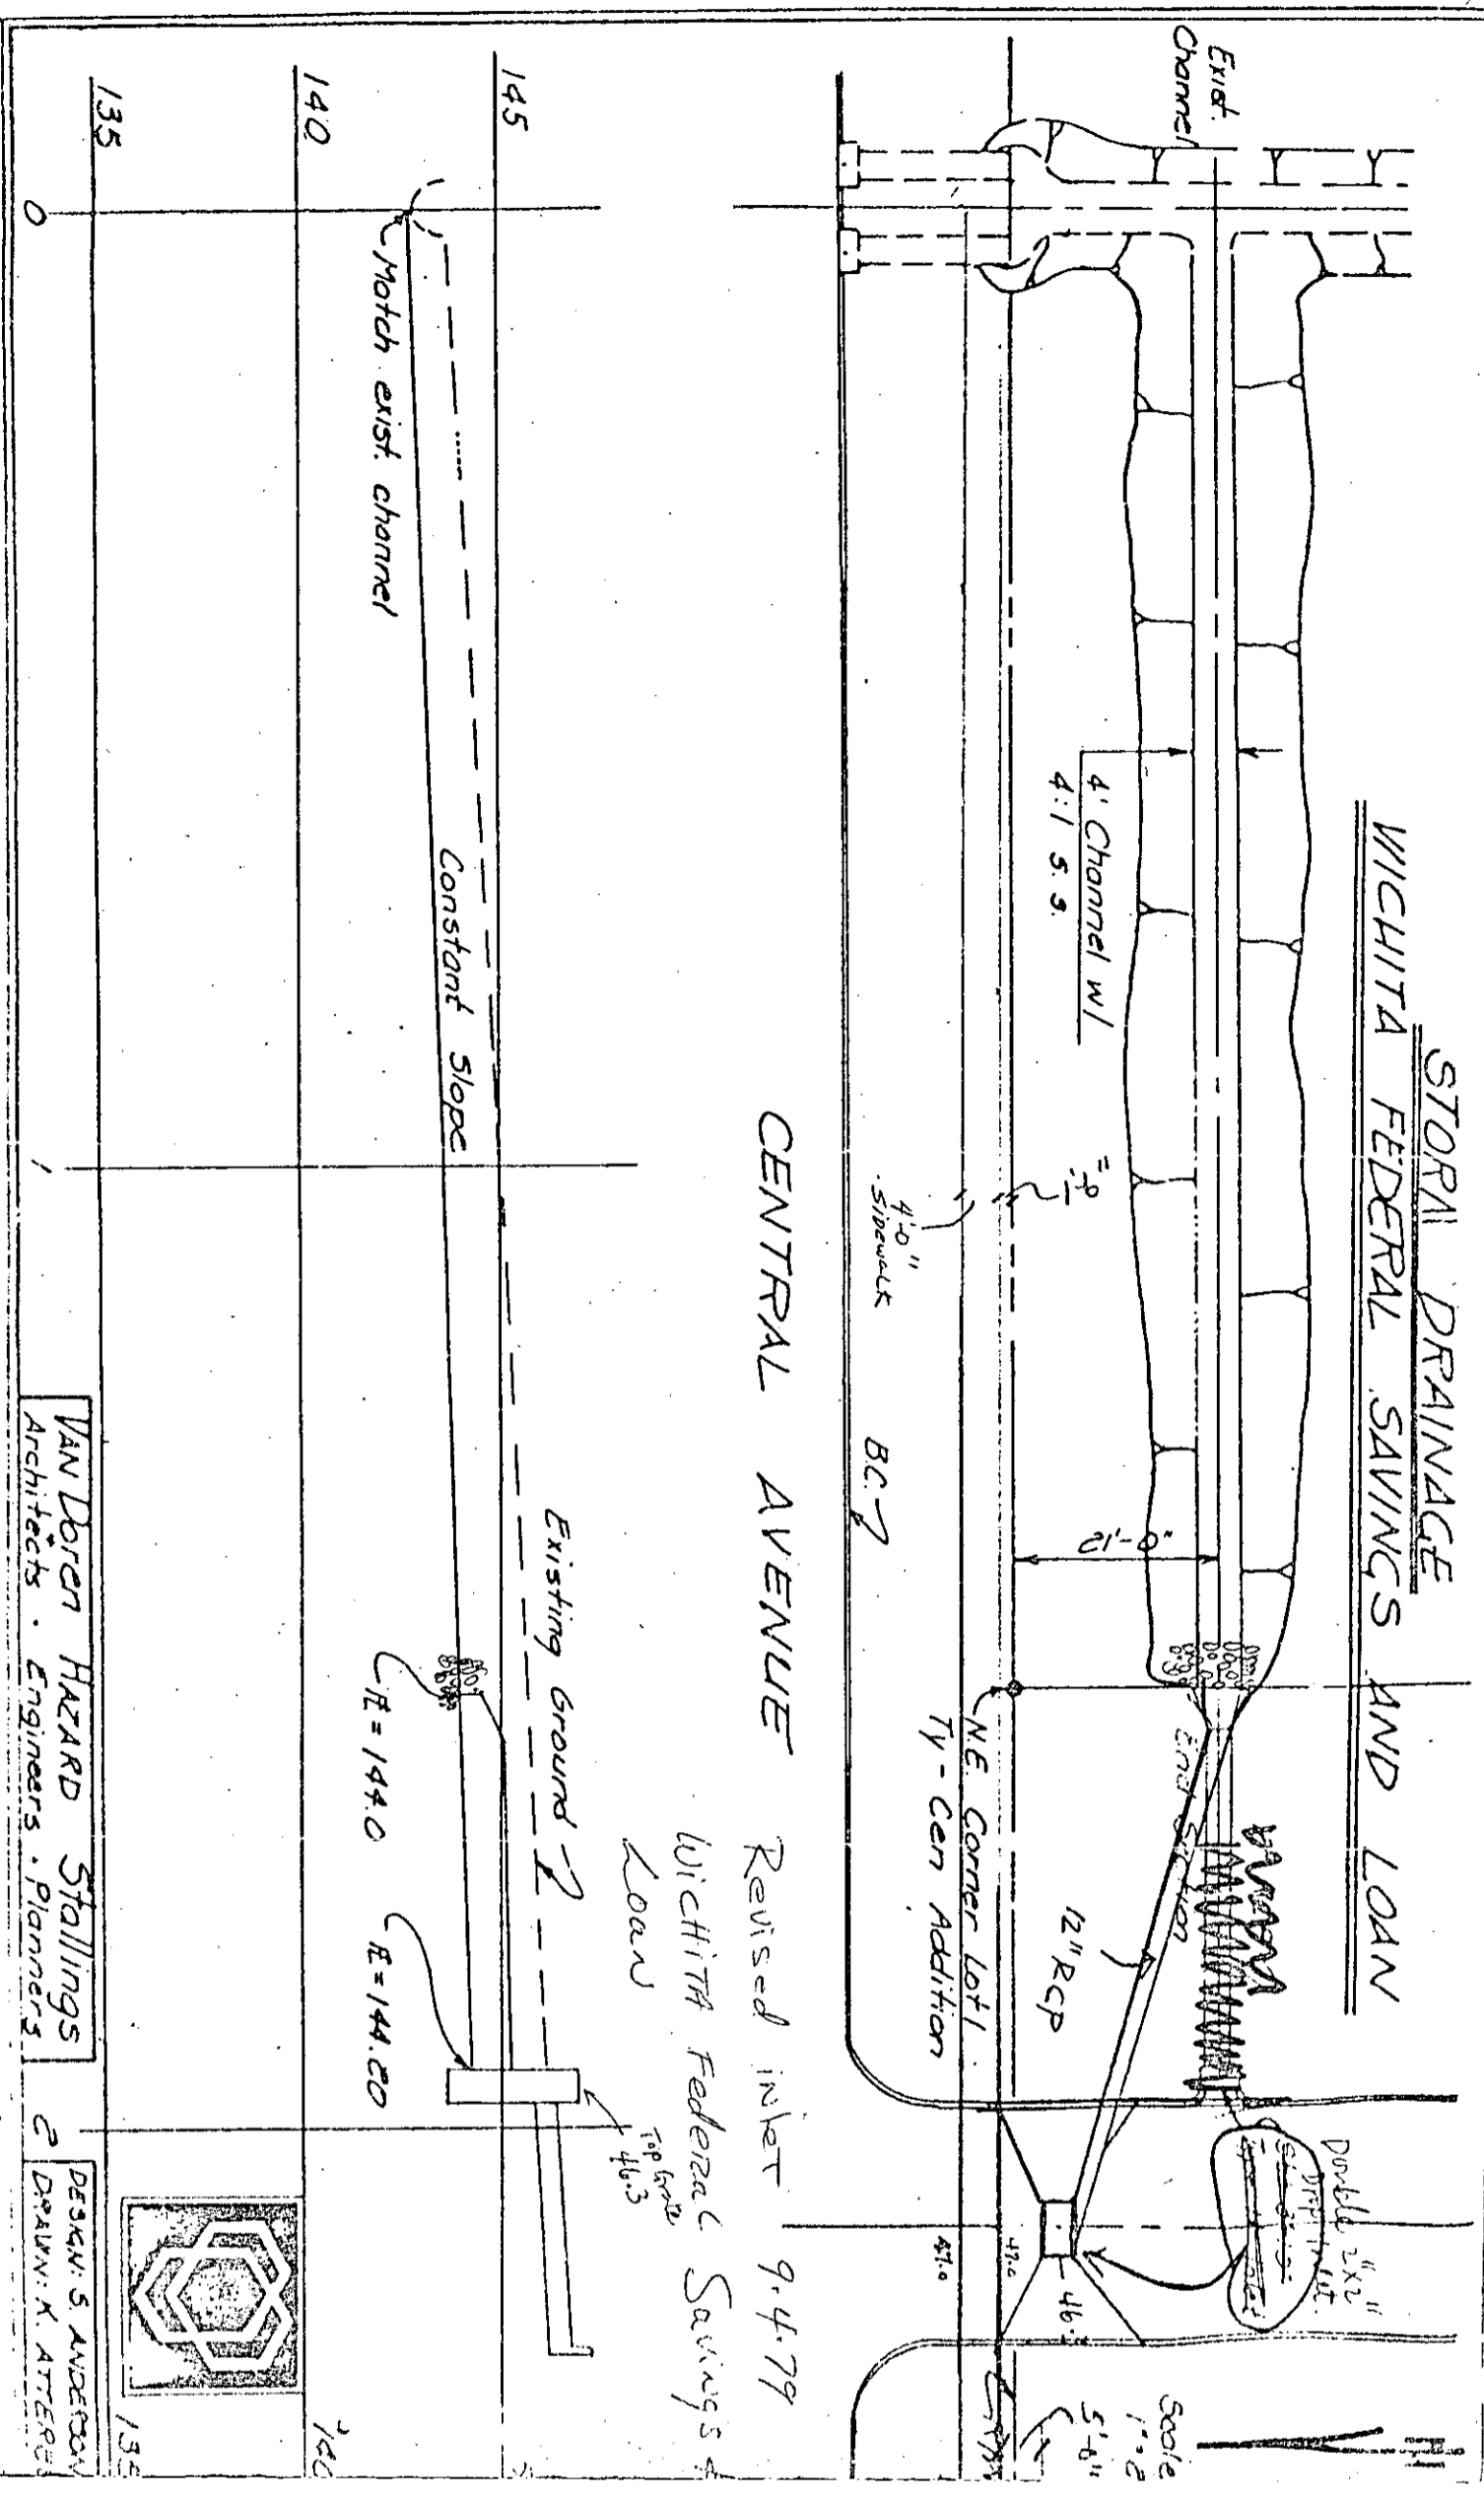

Match exist. channel

Constant Slope

Existing Ground

E = 144.0

E = 144.00

135


140

145

0

Architects - Engineers - Planners

DESIGN: S. ANDERSON
DRAWN: K. ATTER

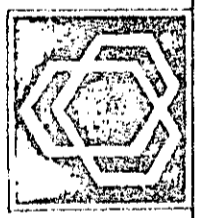

135

140

Scale 1" = 2'
5'-0"