


- GENERAL NOTES:**
1. All elevations City of Wichita Datum.
 2. All construction to comply with City of Wichita specifications and standards except for compaction requirements. For compaction requirements refer to Soils Investigation Report and addendum prepared by Allied Laboratories, Oct. 1979. Any borrow material used on the site shall be tested.
 3. Storm Sewer lines to be inspected by the Department of Public Works Inspection.
 4. All inlets to be City of Wichita Standard Drop Inlets, (size as shown on Plan).
 5. Deleted.
 6. Sanitary Sewer lines to be inspected by the Dept. of Public Works Inspection.
 7. Sand backfill and flush all sanitary sewer and storm drain excavations.
 8. All sanitary sewer manholes to be Standard City of Wichita 4' dia. Type A or C as noted.
 9. Water lines to be inspected by the Wichita Water Department.
 10. All waterline construction and materials to comply with Wichita Water Department Standards and Specifications.
 11. All excavation, trust blocks, and backfill at tapping locations by Contractor.
 12. See pipeline profile sheets for Storm Drains, Sanitary Sewers, and Waterlines.

See "Detail" Sheet for Typical Section, Parking and Returns and Entrance Detail.

LOT 2,3,4 BLK B.
 LOT 4 BLK C
 TY - CEN ADD.

B.M. 146.98 "x" cut in S.E. corner conc. slab on N.L. Central and approx. Central & Sta. 36+27

for site grading only
 Approved subject to: (a) Contractor shall construct pit channel along North line, then East line and to South line of the development to ensure flow of flood waters south of Central ave. Contact Hazard Stallings at 686-7303 (Ken Asplund) for info.

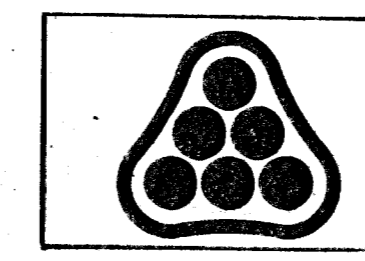

PROFESSIONAL ENGINEERING CONSULTANTS, P.A.		
ENGINEERS WICHITA, KANSAS		
Designed by MDS	Job No. 70-7335	Sht. of
Drawn by RFI, DJM, GDR	Date Nov. 1979	

11