


Scale 1"=50'

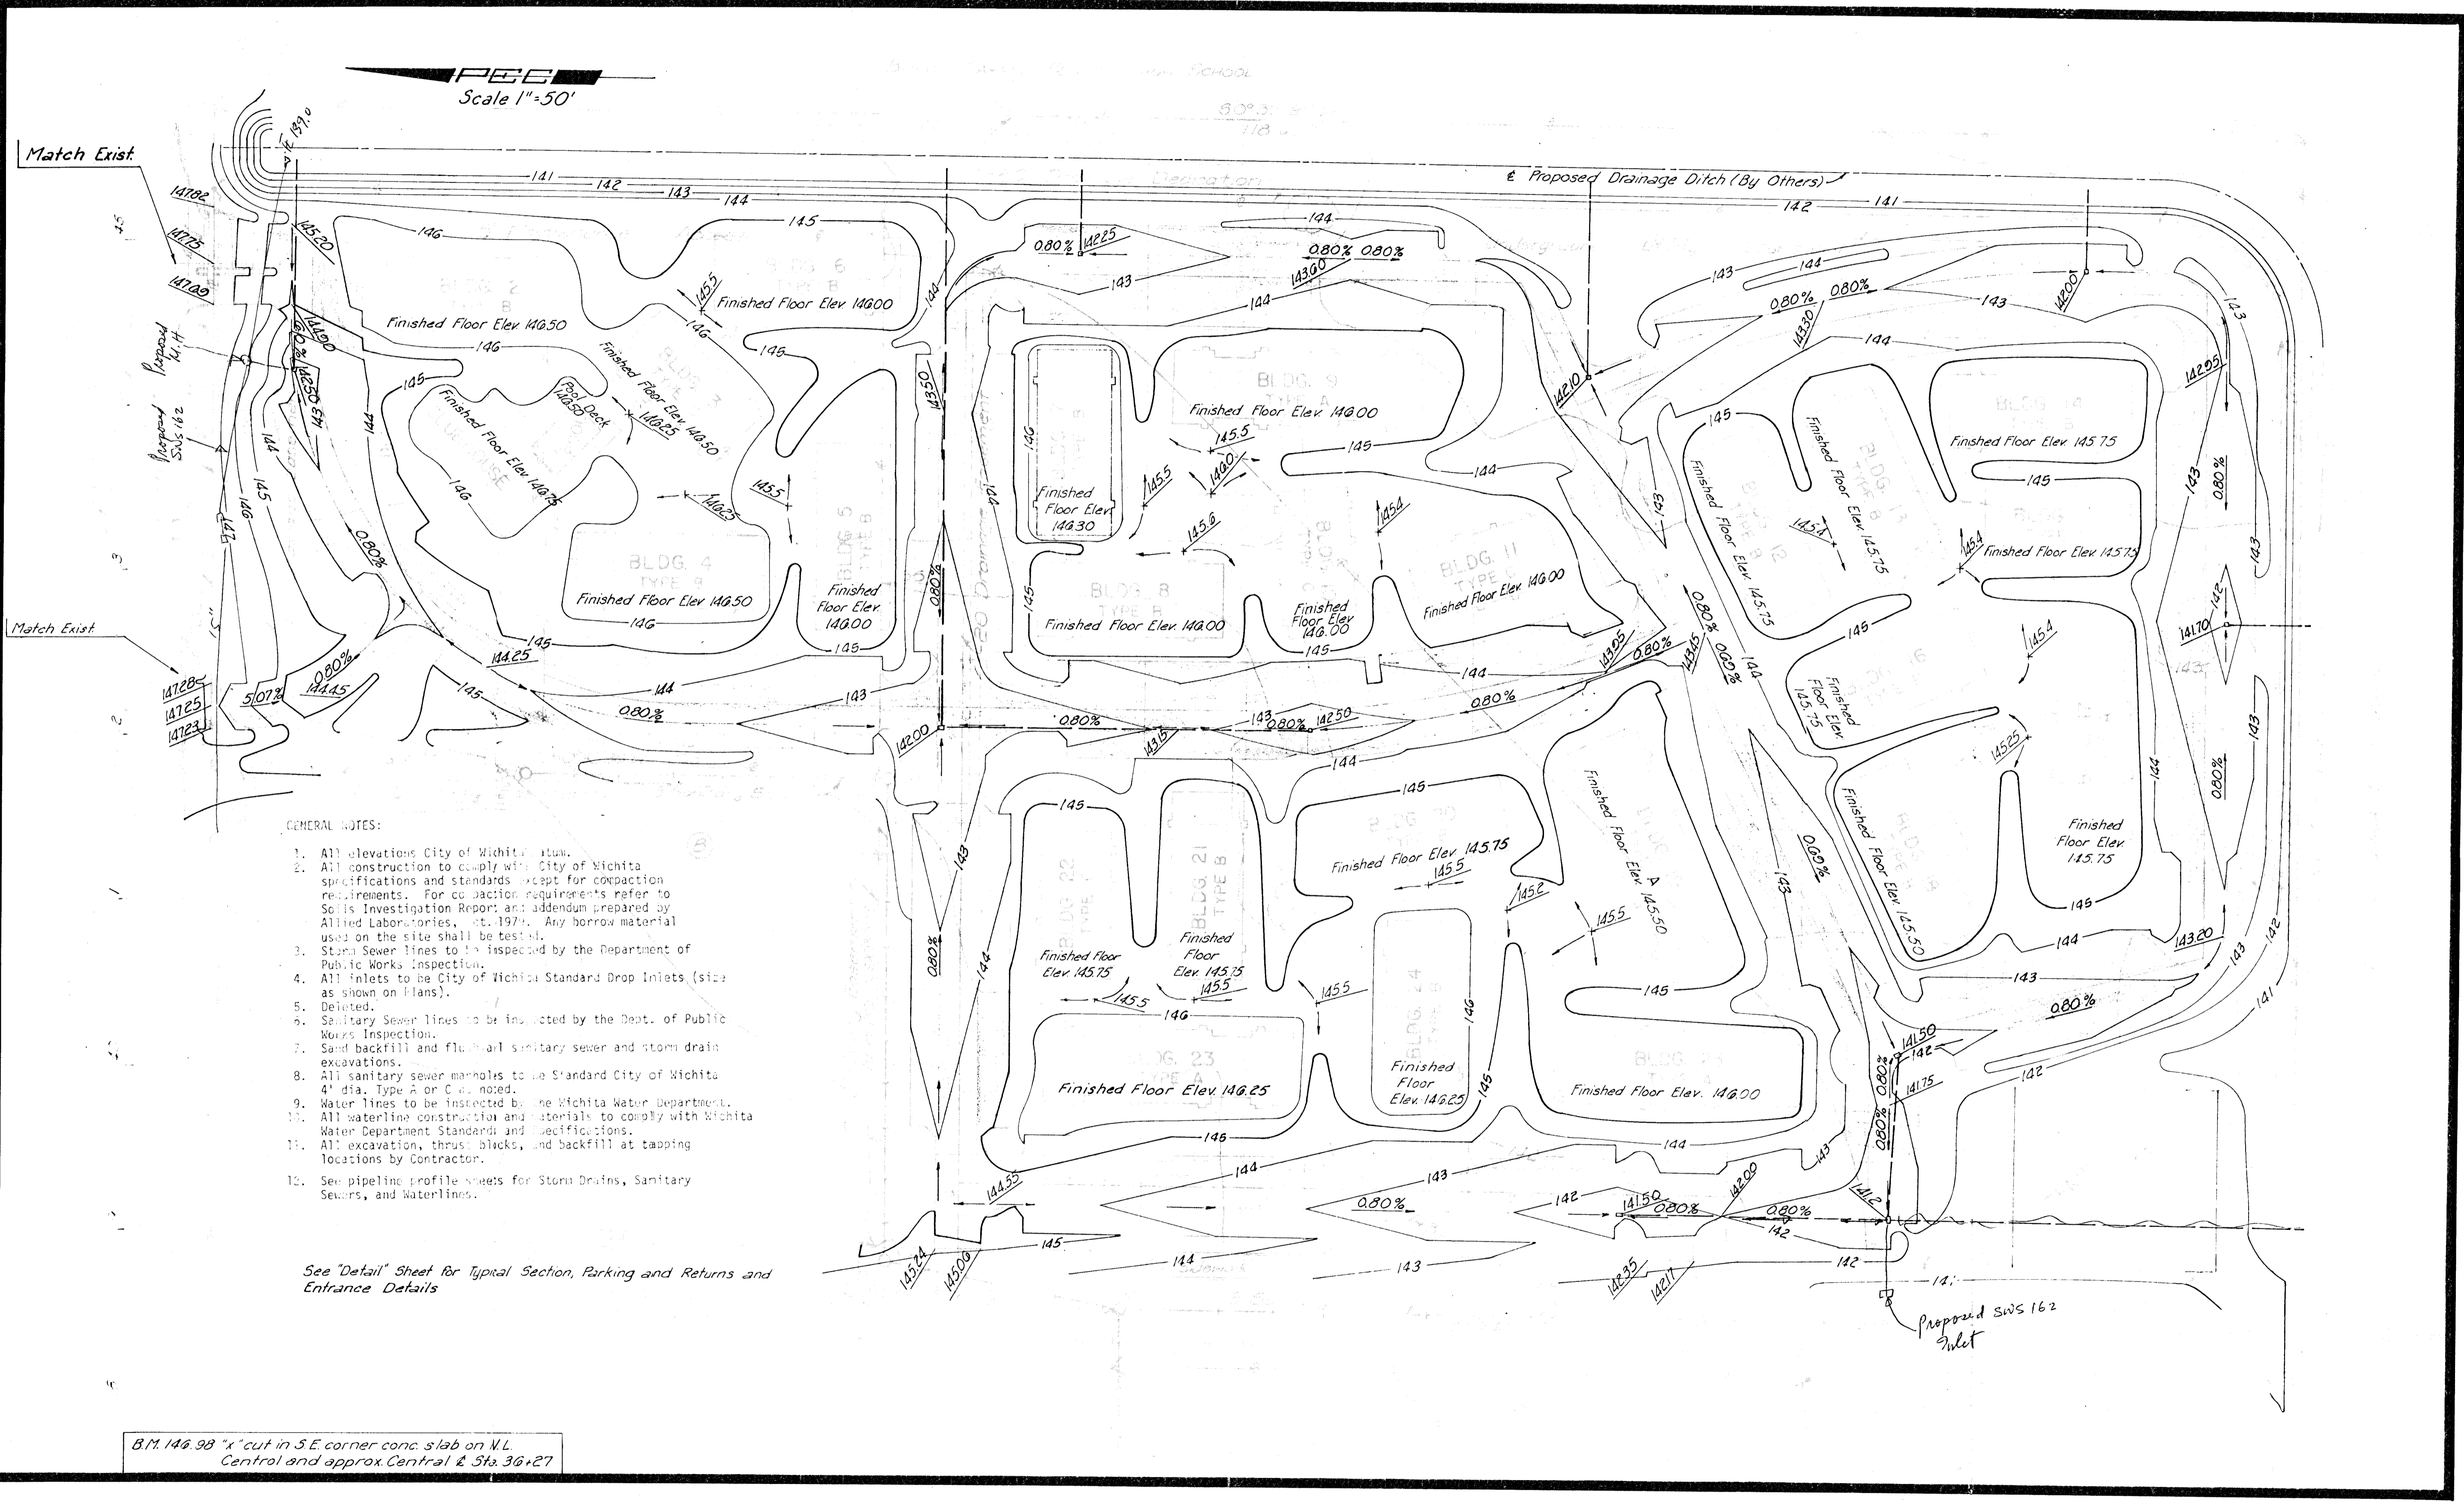

GENERAL NOTES:

1. All elevations City of Wichita datum.
2. All construction to comply with City of Wichita specifications and standards except for connection requirements. For connection requirements refer to Soils Investigation Report and addendum prepared by Allied Laboratories, et. 1979. Any borrow material used on the site shall be tested.
3. Storm Sewer lines to be inspected by the Department of Public Works Inspection.
4. All inlets to be City of Wichita Standard Drop Inlets (size as shown on Plans).
5. Deeded.
6. Sanitary Sewer lines to be inspected by the Dept. of Public Works Inspection.
7. Sand backfill and flush all sanitary sewer and storm drain excavations.
8. All sanitary sewer manholes to be Standard City of Wichita 4' dia. Type A or C as noted.
9. Water lines to be inspected by the Wichita Water Department.
10. All waterline construction and materials to comply with Wichita Water Department Standards and Specifications.
11. All excavation, thrusts, blocks, and backfill at tapping locations by Contractor.
12. See pipeline profile sheets for Storm Drains, Sanitary Sewers, and Waterlines.

See "Detail" Sheet for Typical Section, Parking and Returns and Entrance Details

B.M. 146.98 "x" cut in S.E. corner conc. slab on N.L. Central and approx. Central & Sta. 36+27

	<b>PROFESSIONAL ENGINEERING CONSULTANTS, P.A.</b>		
	ENGINEERS WICHITA, KANSAS		
	Designed by MDS	Job No. 30-10355	Sht. of
Drawn by R.F.J., D.J.M. & G.D.R.	Date Nov. 1979		