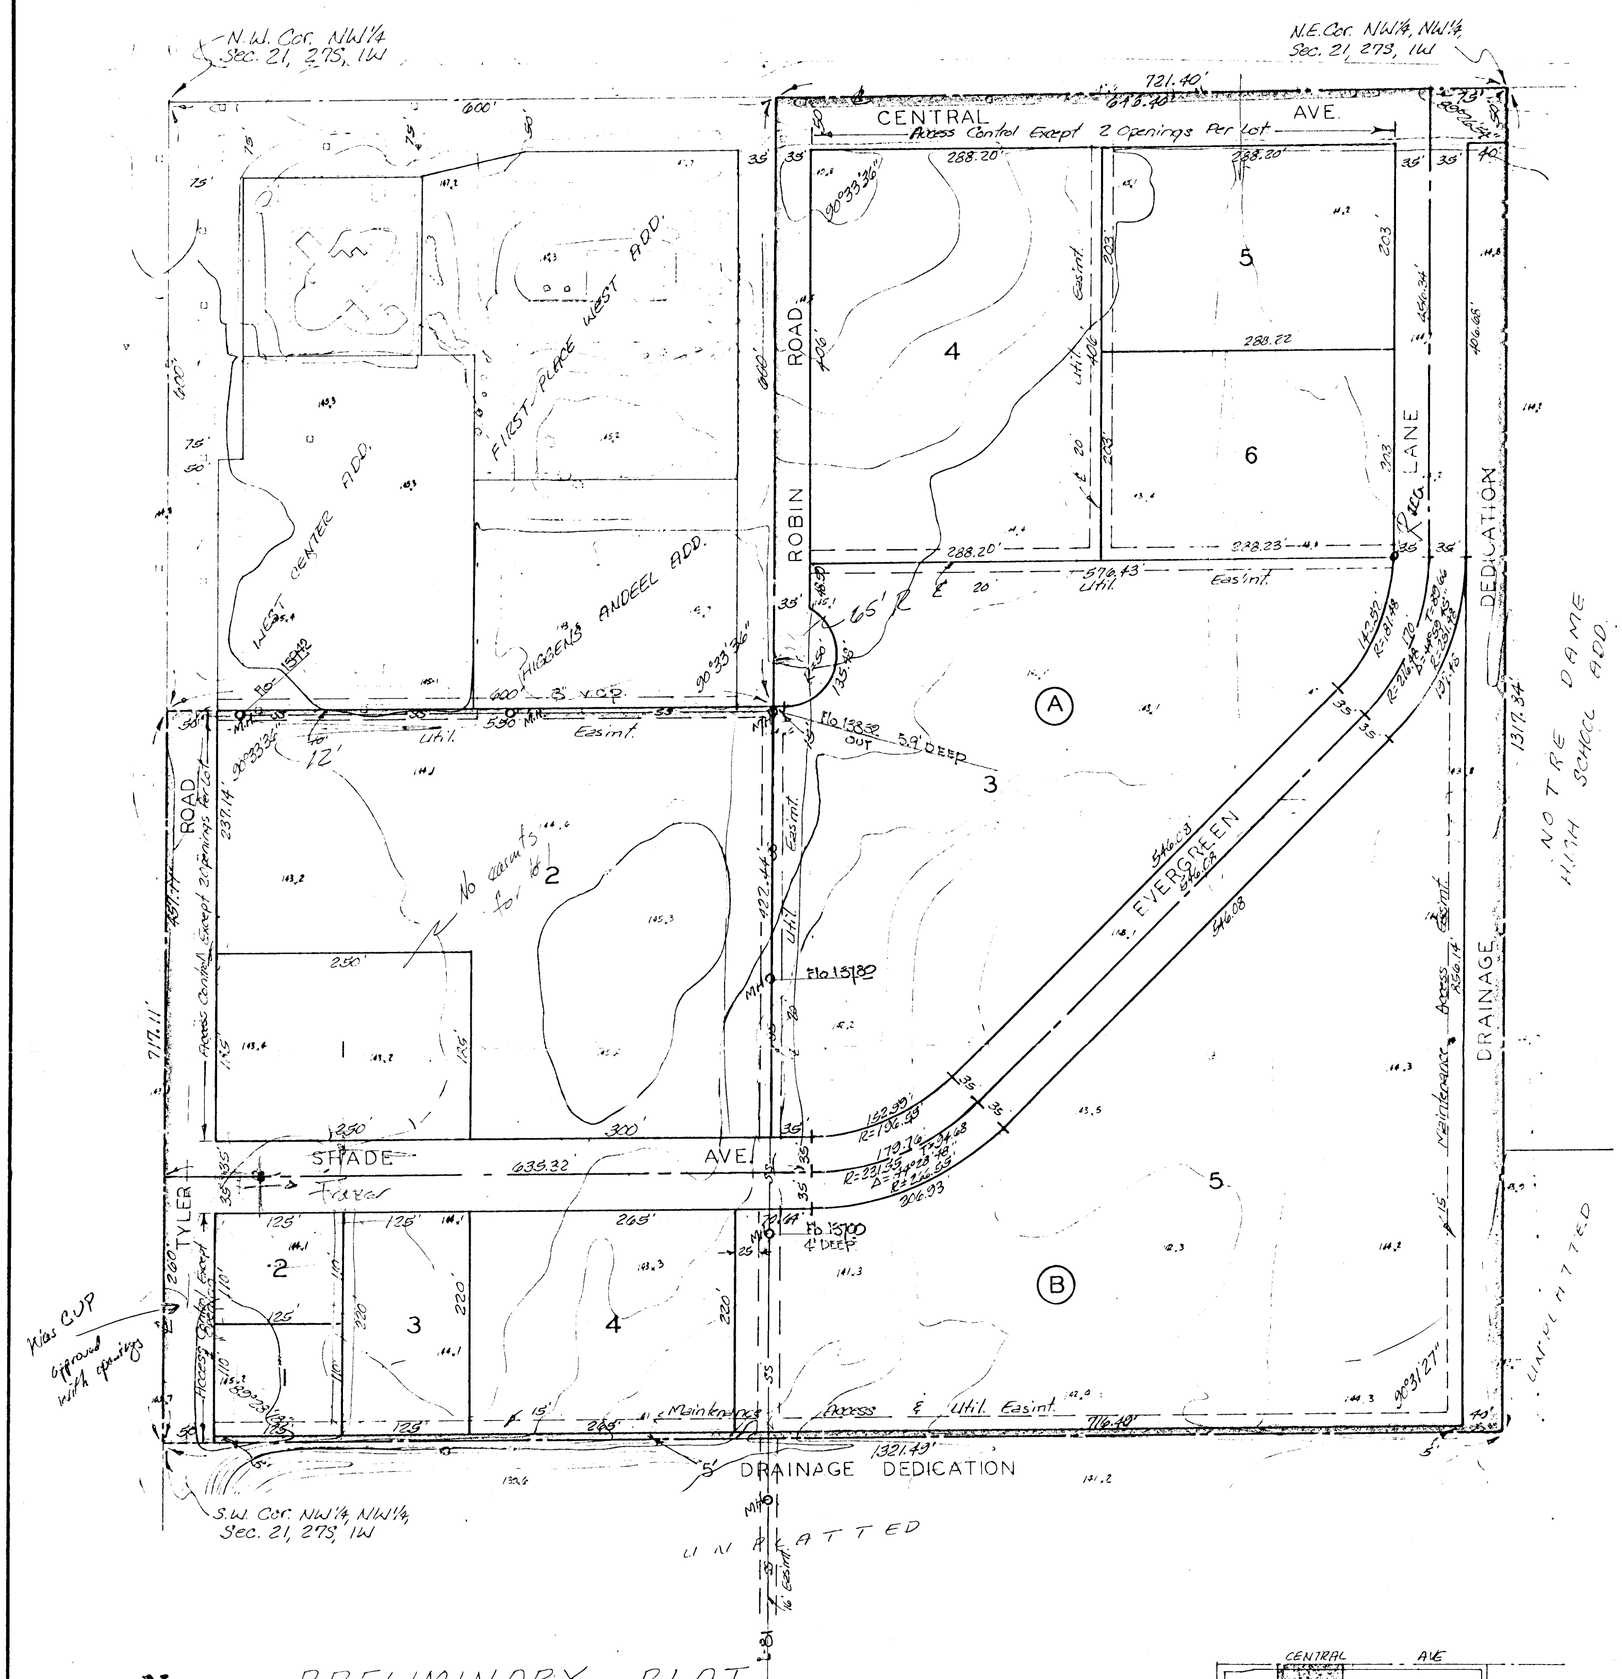

N

1" = 100'
Elev. = City Datum

PRELIMINARY PLAT

TY-CEN ADDITION

THE NW¼ OF THE NW¼ OF SEC. 21, TWP. 27-S, R-1-W, SEDGWICK COUNTY, KANSAS, EXCEPT THE NORTH 600 FEET OF THE WEST 600 FEET THEREOF.

B.F.P., INC. JERRY FELDMAN

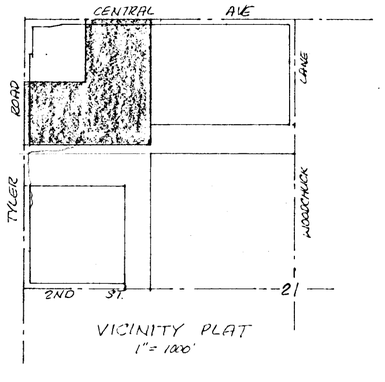

VICINITY PLAT
1" = 1000'

NOTE:
Building set-back lines are per approved TY-CEN ADDITION C.U.P.

BALIGHMAN COMPANY, P.A. 6 FEB 79