


N. E. 1/4 SEC. 11, TWP. 28S, R. 1-E.

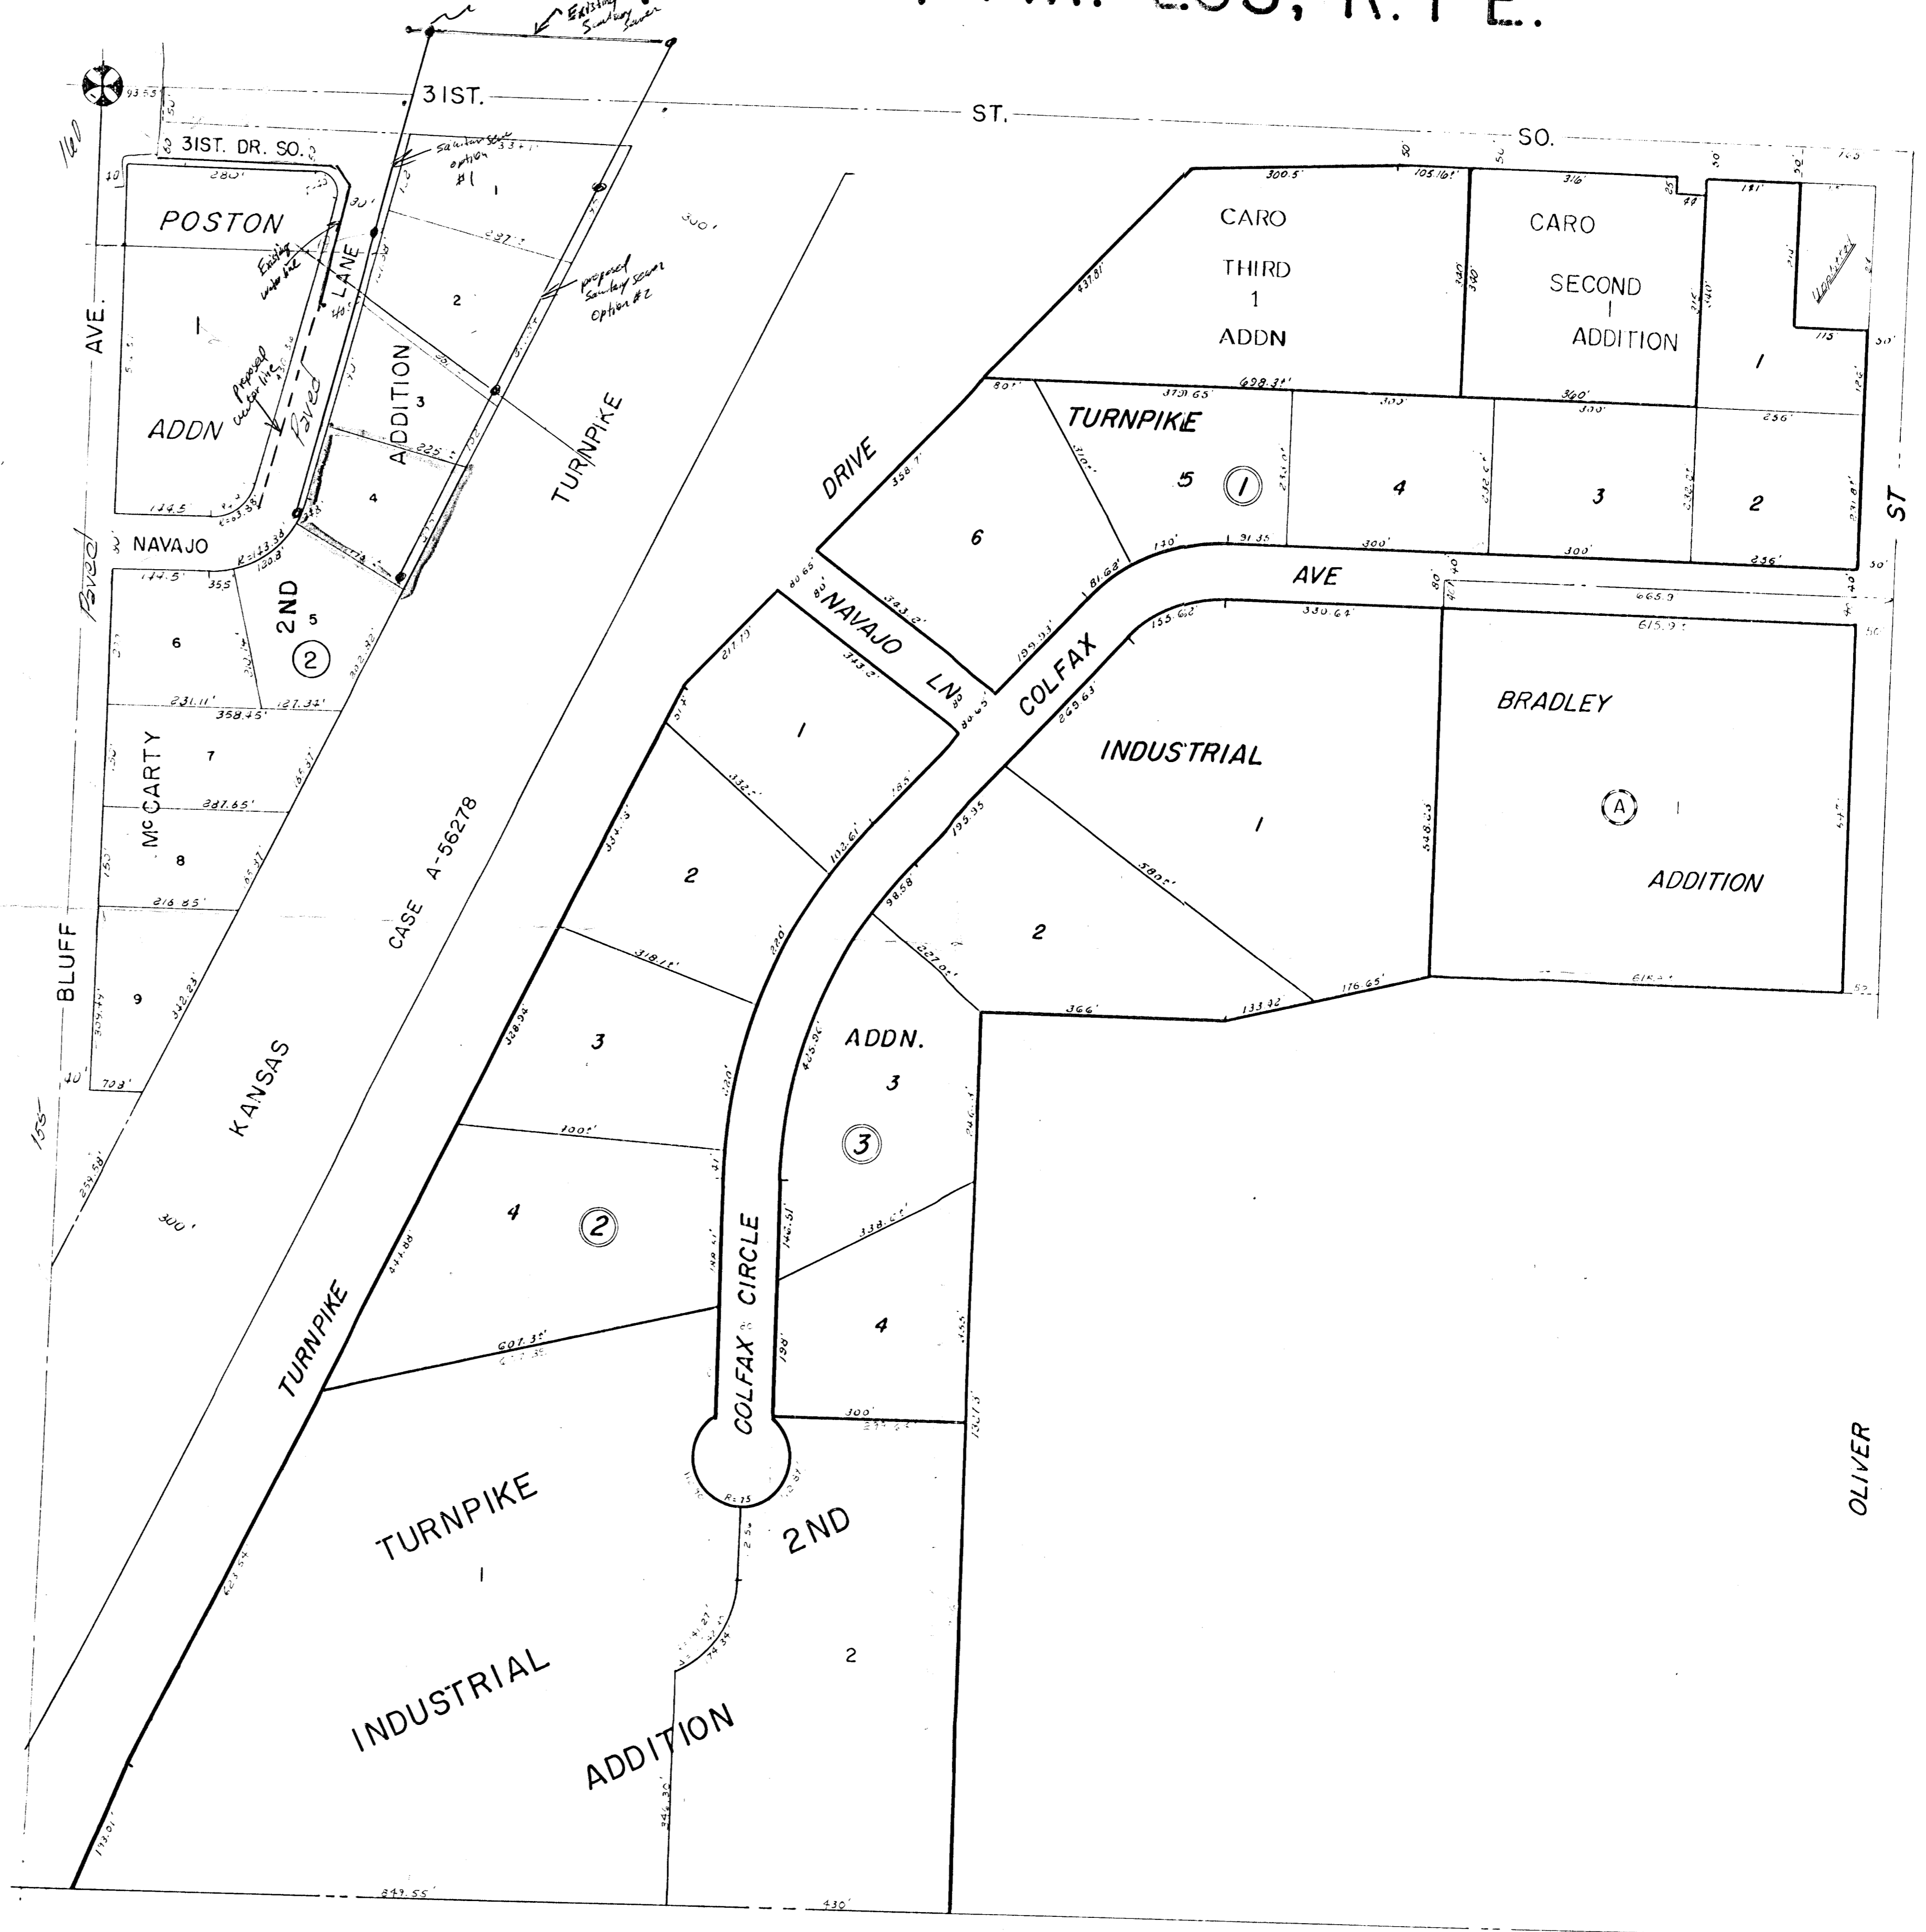

OLIVER

N. E. 1/4 SEC. 11, TWP. 28S, R. 1-E.

