PRELIMINARY PLAT

AMARADO ESTATES THIRD ADDITION

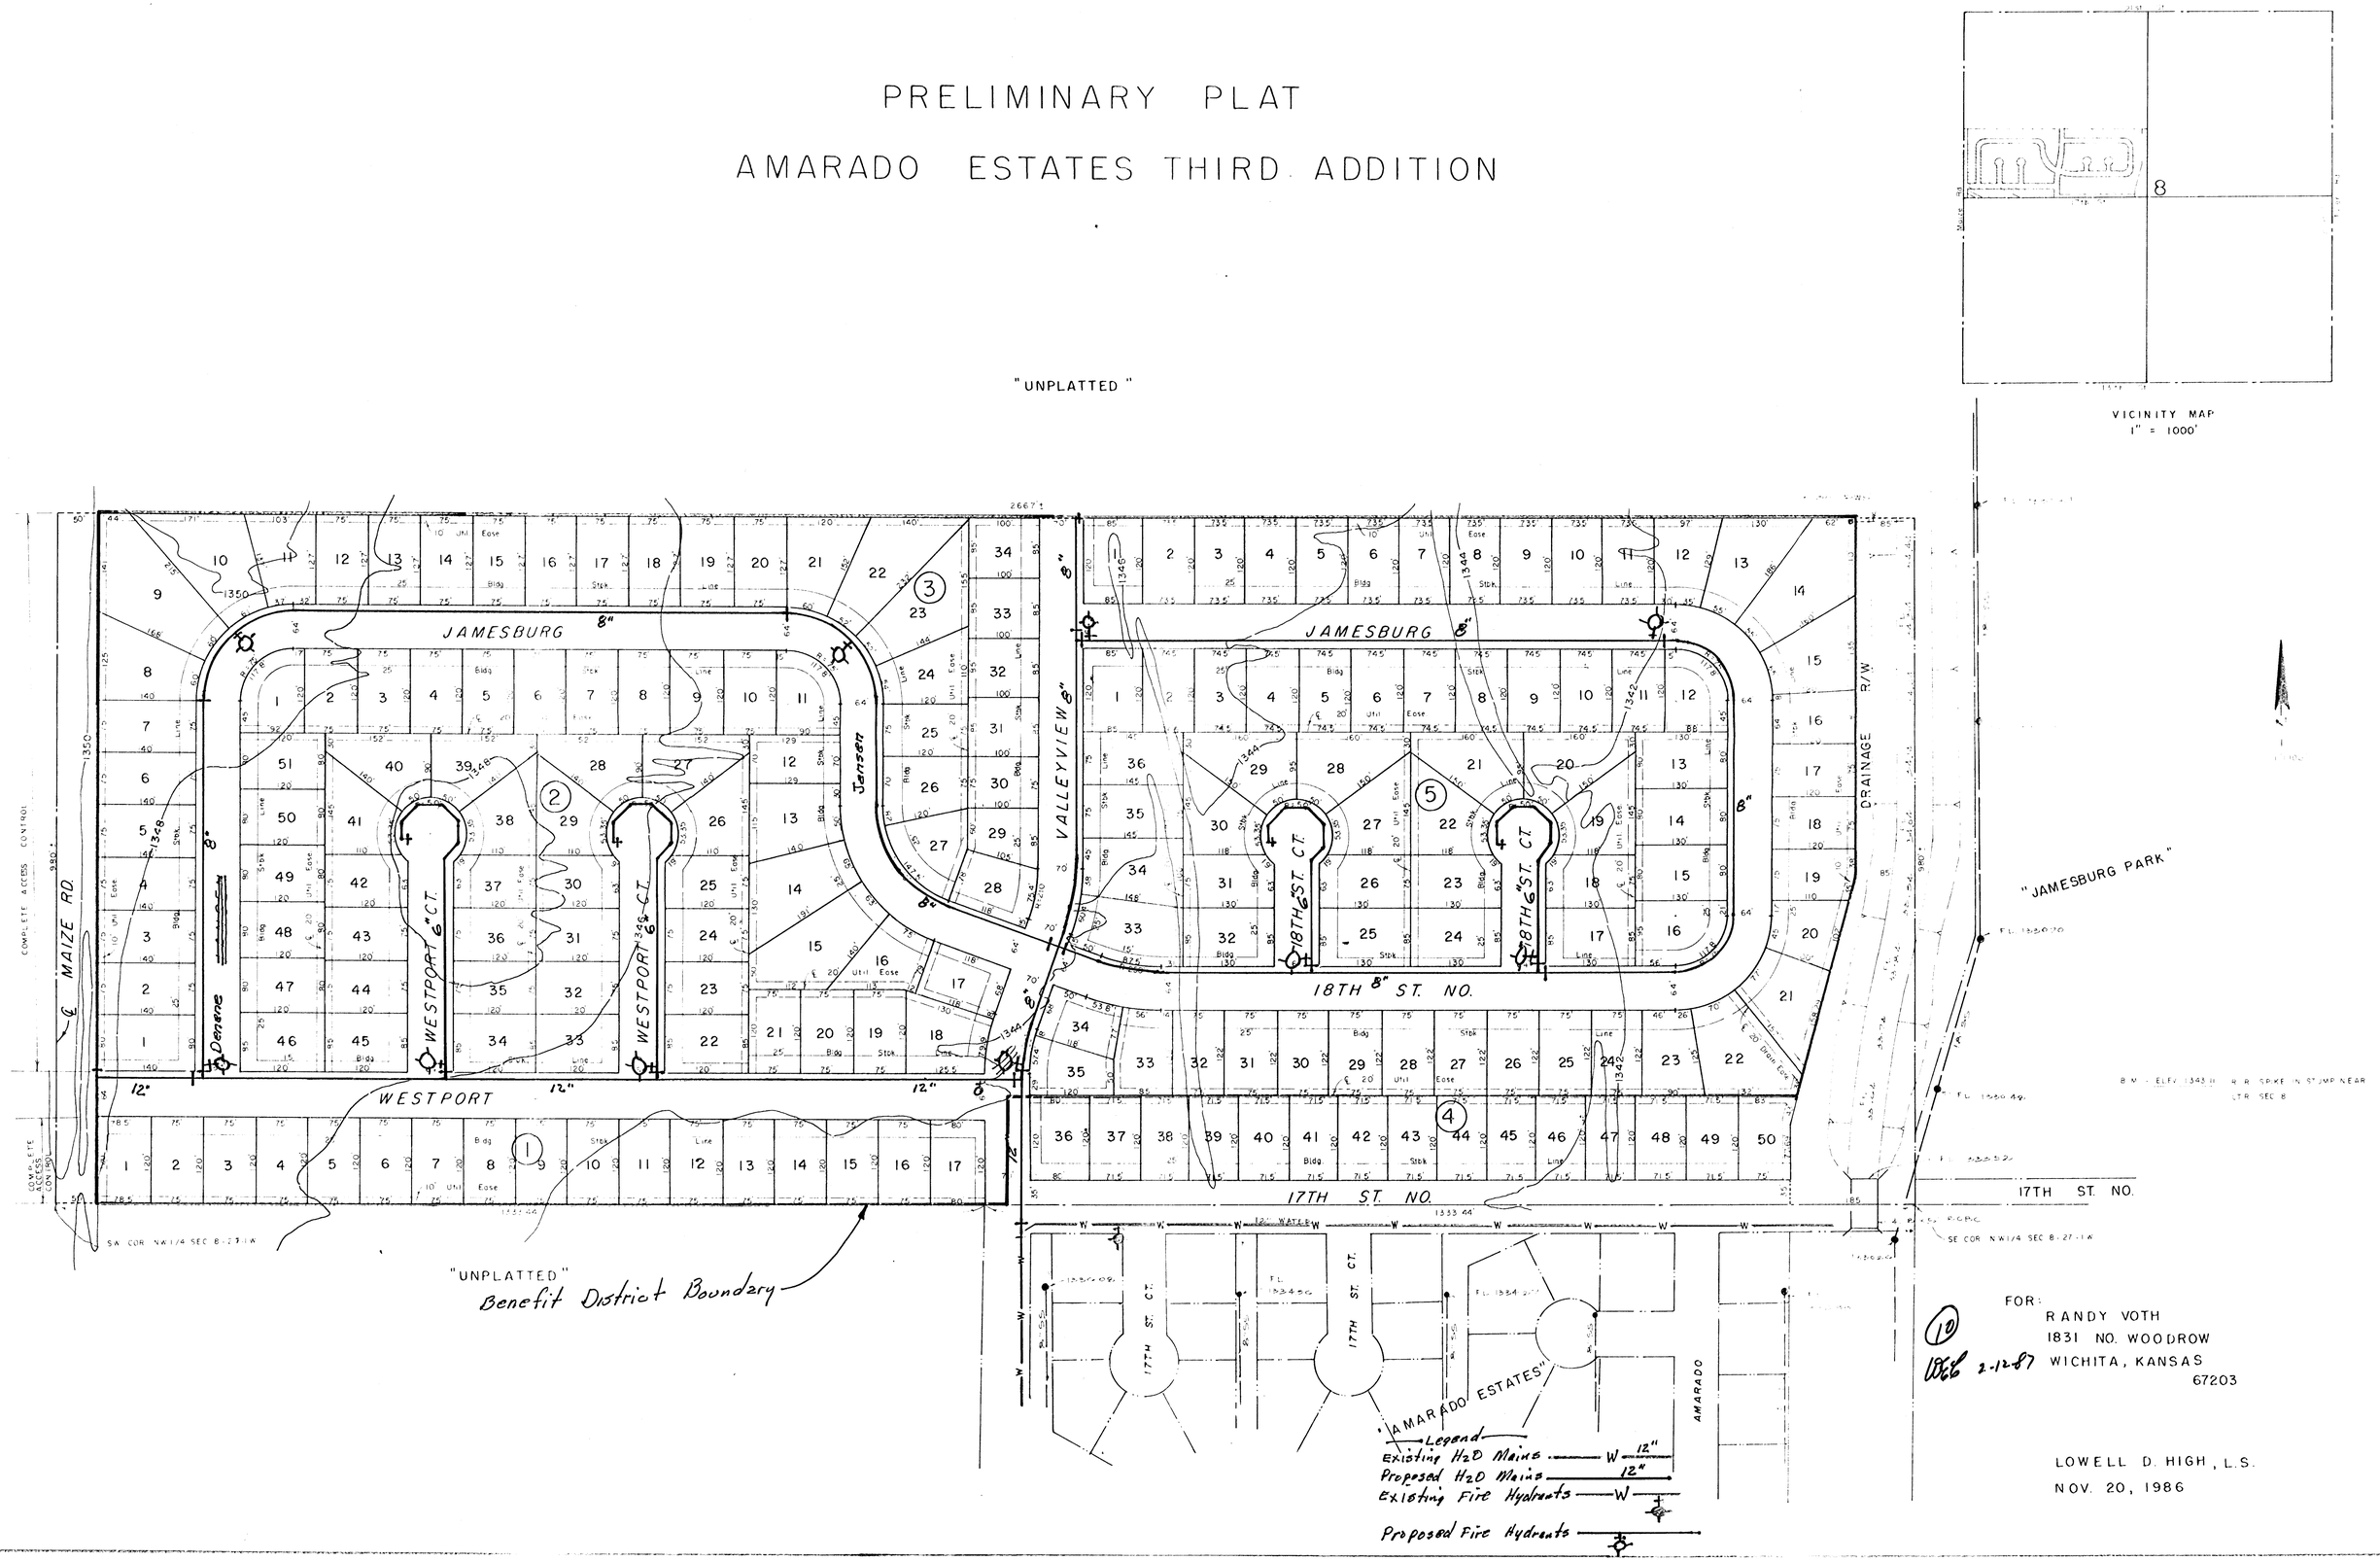

FOR:
RANDY VOTH
1831 NO. WOODROW
WICHITA, KANSAS
67203

(10)
2-12-87

LOWELL D. HIGH, L.S.
NOV. 20, 1986