


M.H. 1-32.3
 TOP ELEV. 188.9
 F.L. IN 181.58
 F.L. OUT 181.56

M.H. 2-95
 TOP ELEV. 191.9
 F.L. 181.2

THE HERITAGE ZONED R-5
 609.74'

ROCK ROAD

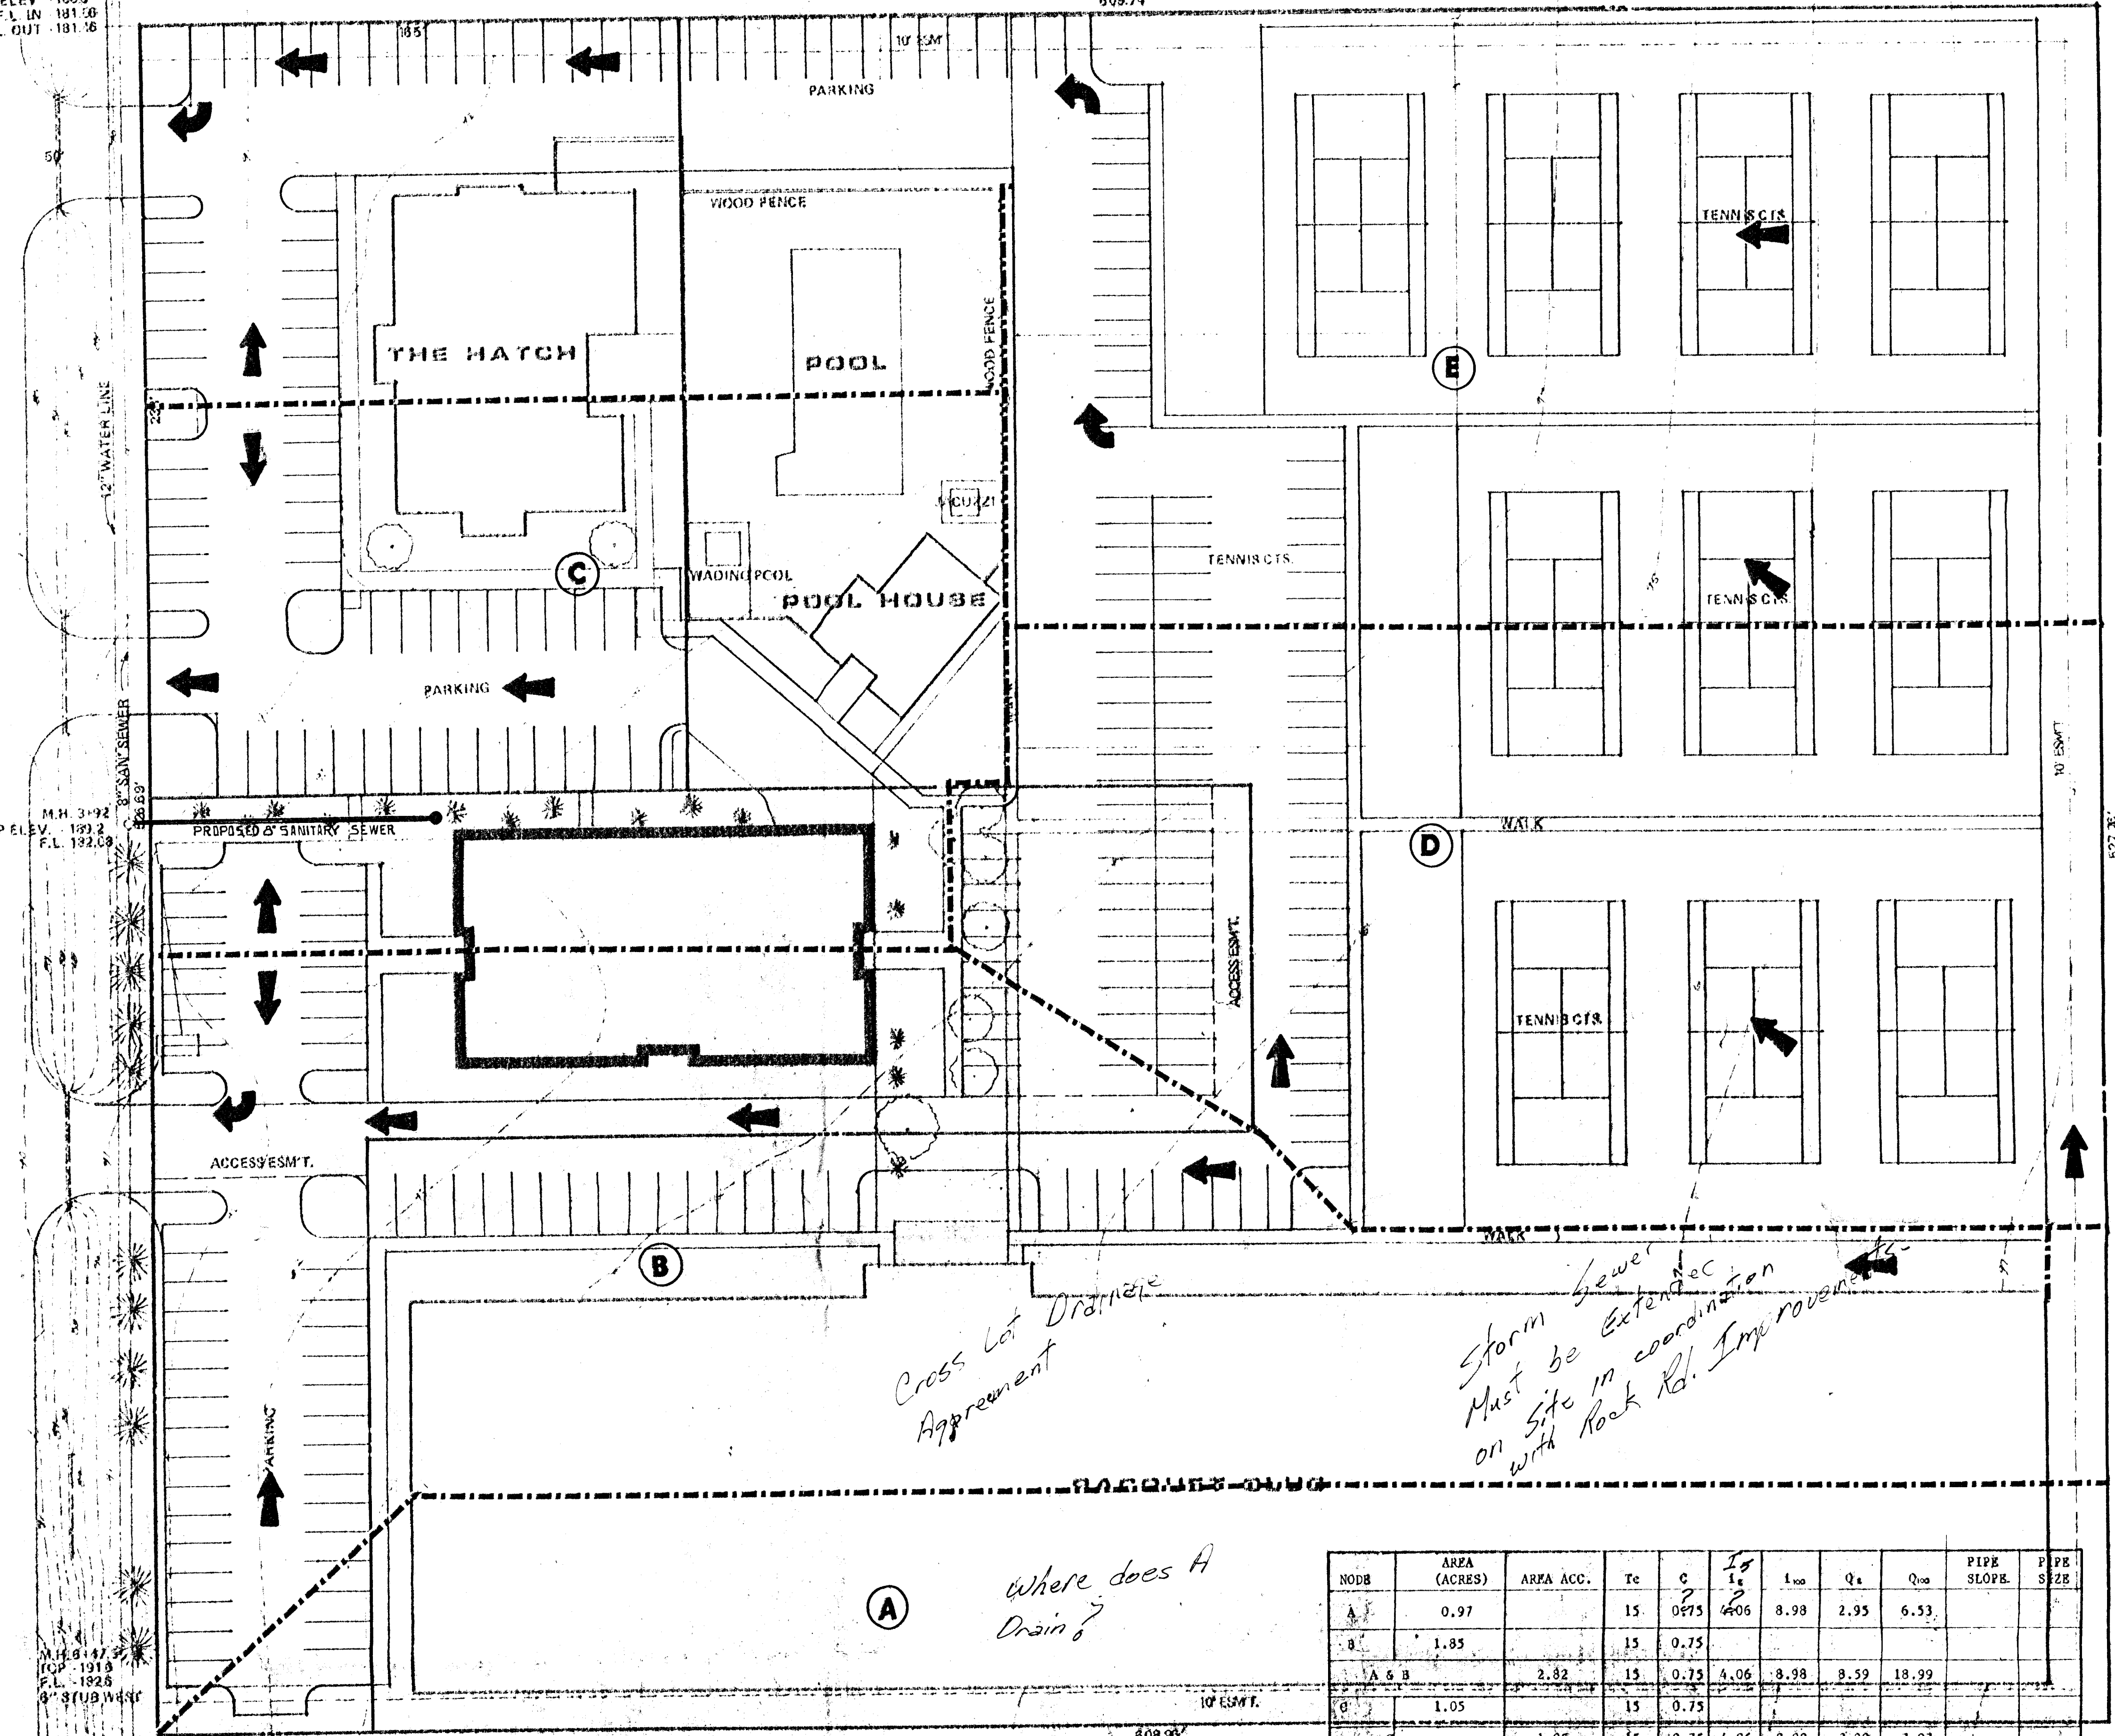


DRAINAGE PLAN FOR RUBY J. 3ND ADDITION

Cross lot Drainage Agreement

Storm Sewer Must be Extension on Site in coordination with Rock Rd. Improvement

Where does A Drain?



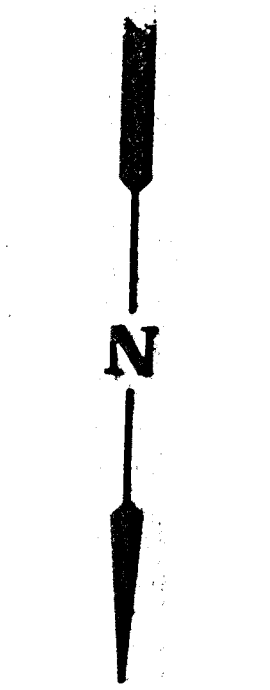

Scale: 1" = 30'

LEASURE LIVING VENTURES
 1ST ADD. ZONED R-5

B.M. - CITY STD. 42" N. AND 38" E. OF INTERSECTION OF 13TH STREET AND ROCK ROAD.

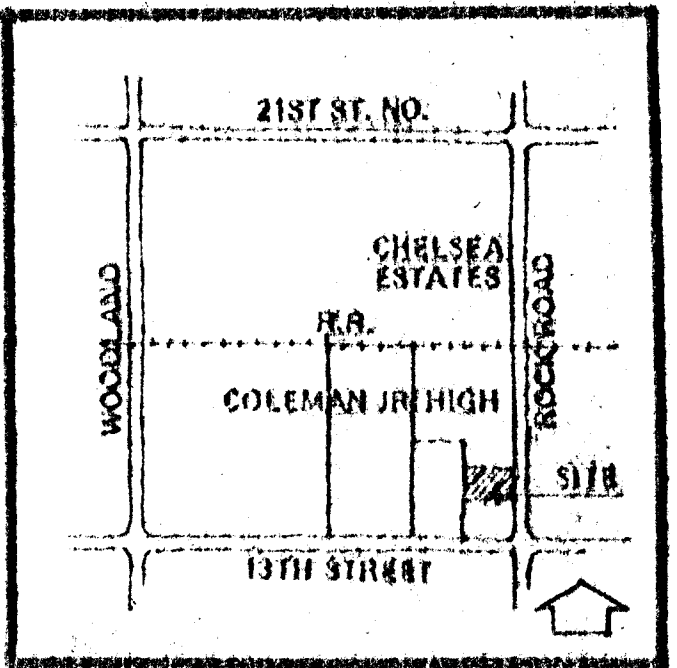

MID-KANSAS ENGINEERING CONSULTANTS PA
 240 NORTH ROCK ROAD
 SUITE 100
 WICHITA, KANSAS 67206

Design: KHB
 Drawn by: DLM
 Checked by: KHB
 Date: AUGUST 1988
 Scale:

Sheet: 1
 of: 1
 682-6561