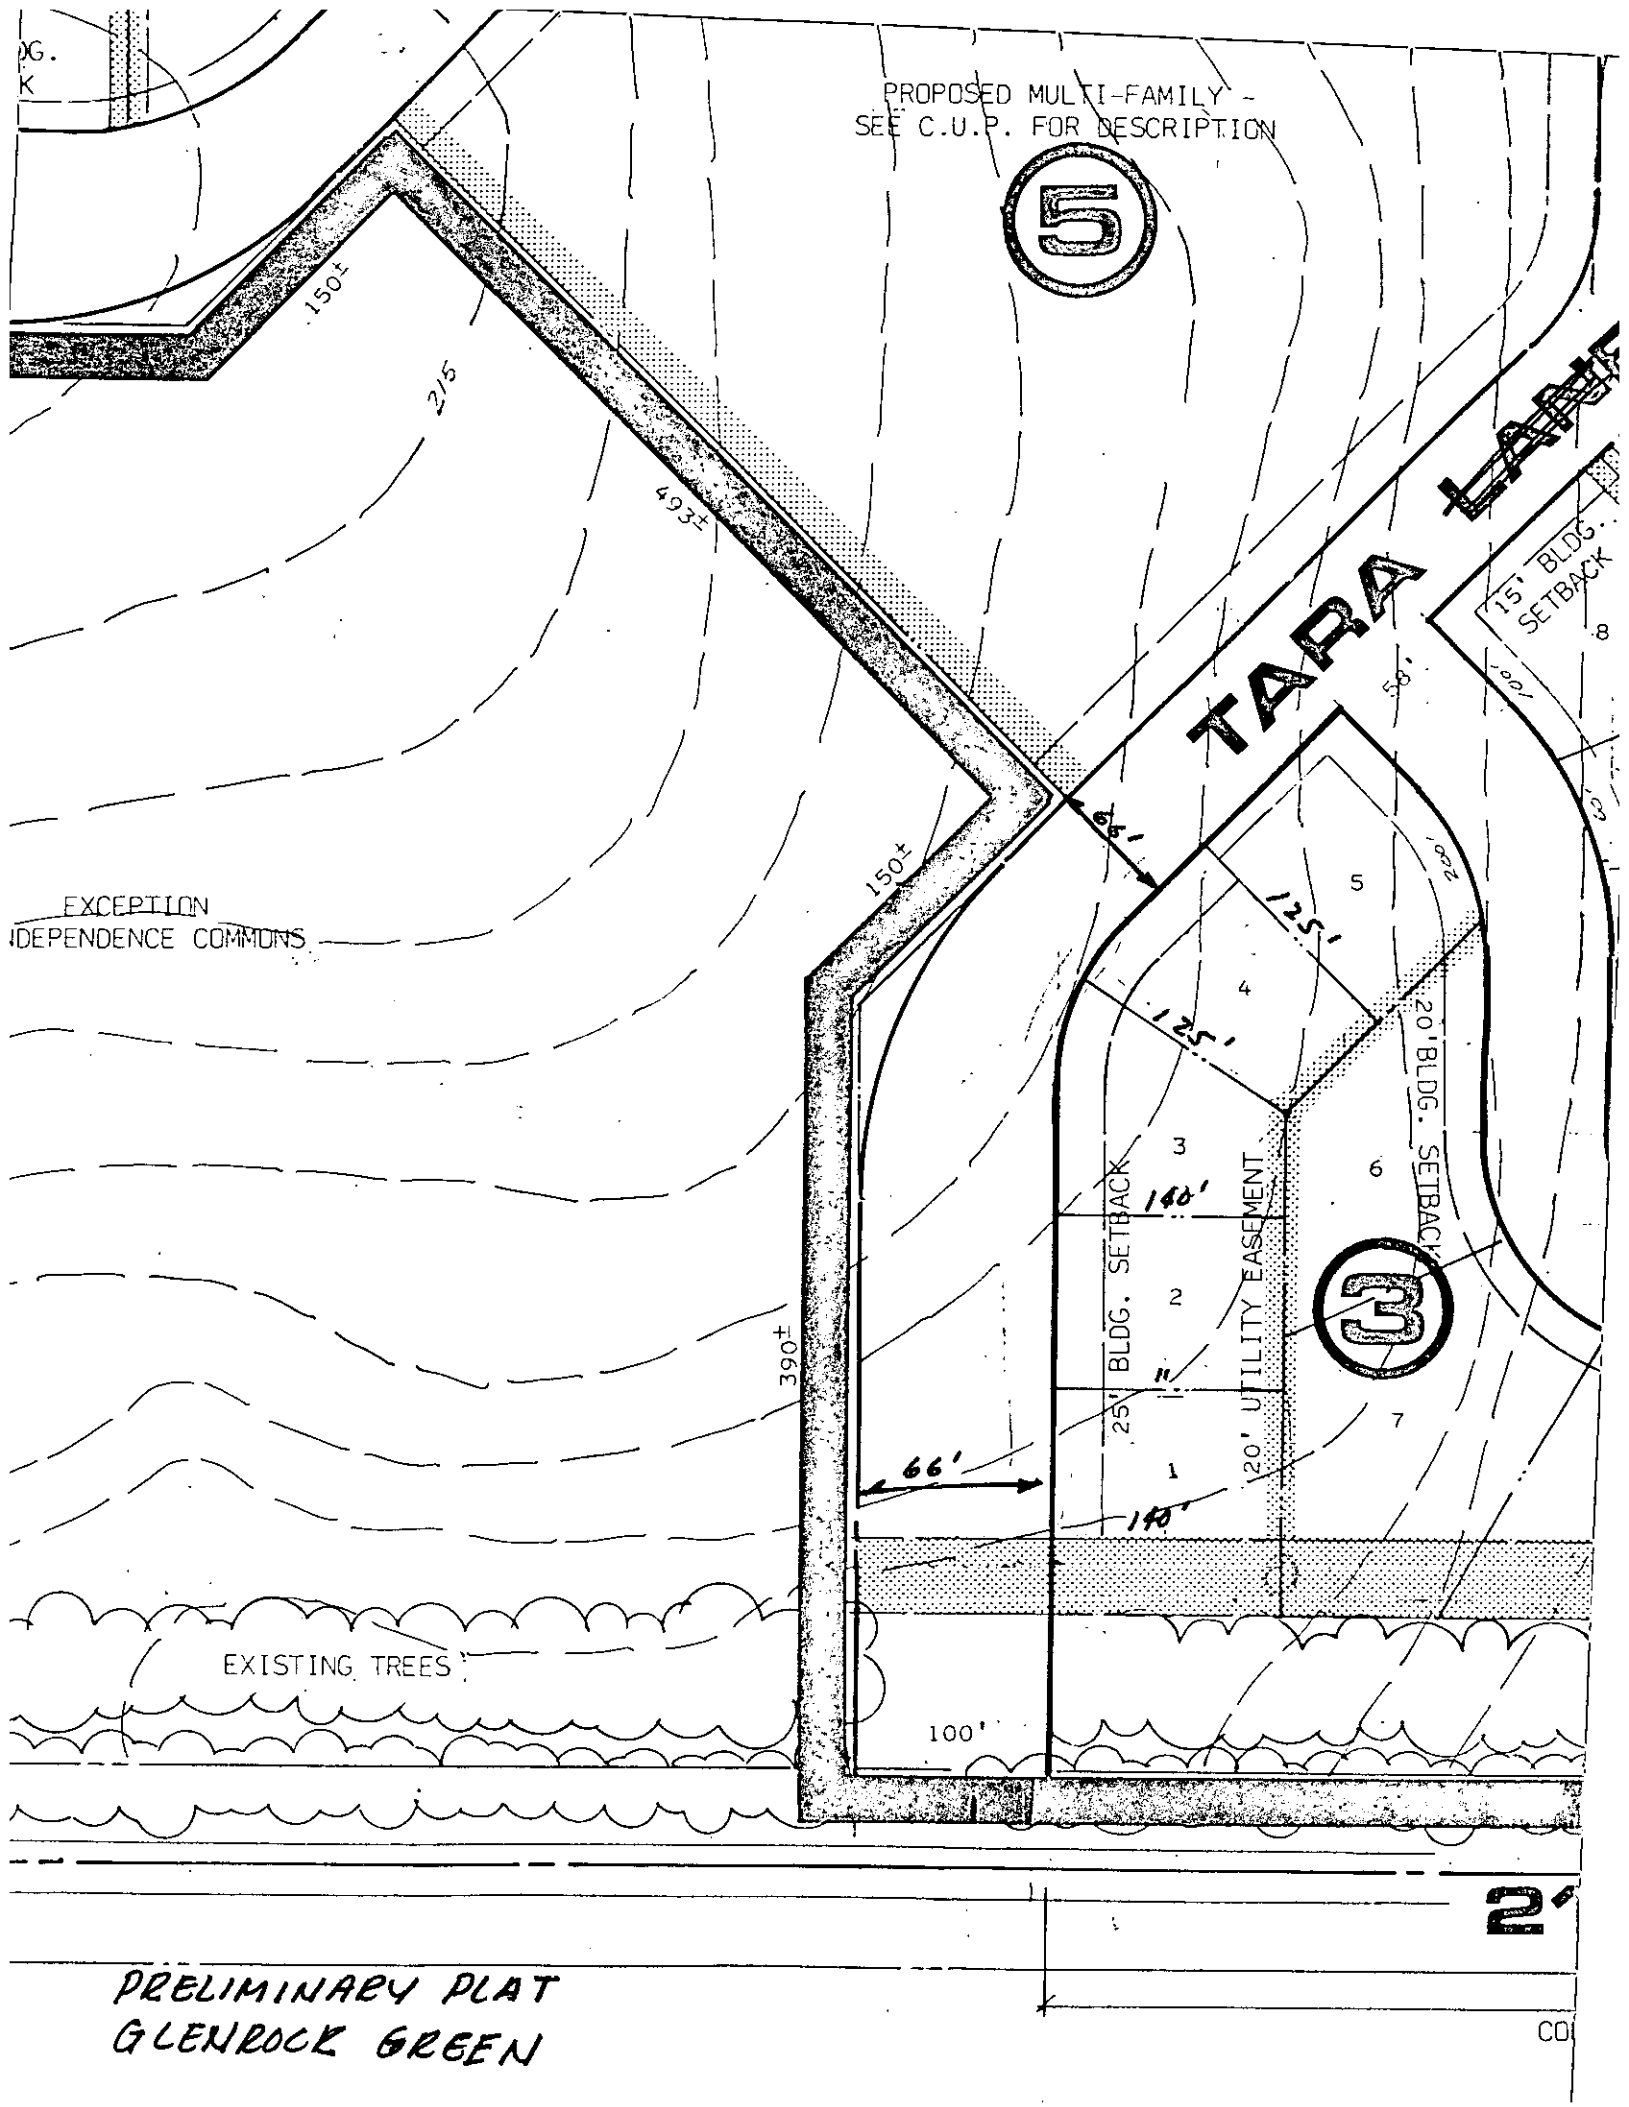

PRELIMINARY PLAT
GLENROCK GREEN