


VICINITY MAP
1" = 1000'

DRAINAGE PLAN
~~SKETCH~~ ~~PLAT~~

MURDOCK INDUSTRIAL ADDITION

FOR: CITY OF WICHITA

Not approved

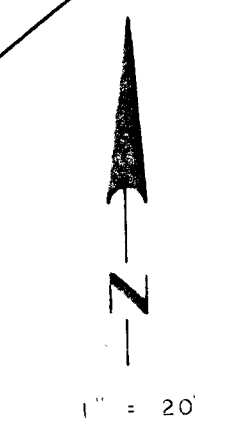

DRAIN LOT I TO MURDOCK & WABASH
AS SHOWN BY THE ARROWS. *also SWS, Flood
or other approved method.*

B.M. = ELEV. 113.03 - R.R. SPIKE, S. FACE
LIGHT POLE, E. SIDE OHIO
275' S. S. L. 8TH ST.

LOWELL D. HIGH, L.S.
OCTOBER 24, 1985