PRELIMINARY PLAT OF

OAK KNOLL INDUSTRIAL PARK 2ND ADDITION

OWNER/DEVELOPER: CARL CHUZY
555 N. WOODLAWN
WICHITA, KANSAS 67208
(316) 686-7274

ENGINEER: PROFESSIONAL ENGINEERING CONSULTANTS, P.A.
303 S. TOPEKA
WICHITA, KANSAS 67202

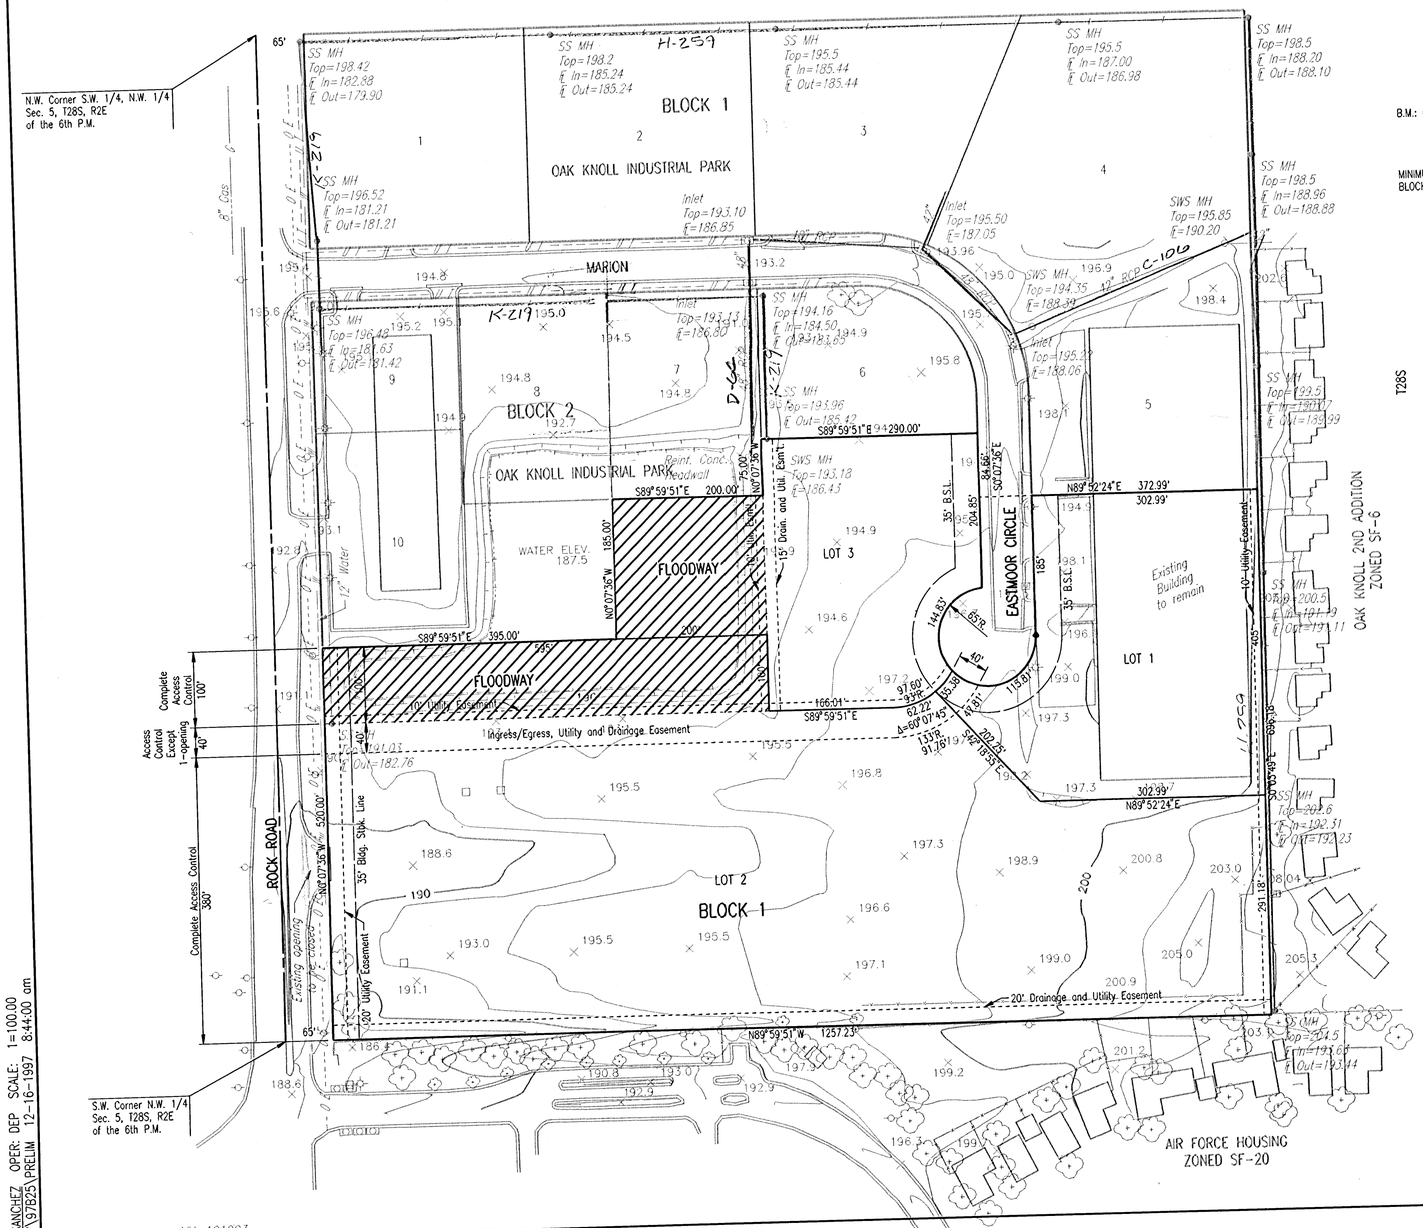

DRAWN: SANCHEZ OPER: DEP SCALE: 1=100.00
C:\1997\97B25\PRELIM 12-16-1997 8:44:00 am