

DRAINAGE PLAN

PACK ADDITION

WICHITA, SEDGWICK COUNTY, KANSAS



SCALE
1" = 30'

- = #4 REDAR W/ "BAUGHMAN" CAP (SET)
 - = #4 REDAR W/ "TERRA TECH" CAP (FOUND)
 - ◊ = #4 REDAR W/ "TERRA TECH" CAP (FOUND)
- (M) = MEASURED
(PRO) = PRORATED
(P) = PLATTED
(C-P) = CALCULATED PER PLATTED INFO.

COUNTOURS @ 1' INTERVALS

LEGEND

- - Power Pole
- - Southwestern Bell Pedestal
- - - Guy Wire

LEGAL


A replat of Lots 37, 39, 40, 41, 43, 45, 47, 49, 51 and Lots 38, 40, 42, 44, 46, 48, 50, 52, Block 3, and the 10 foot alley lying between the even and odd number lots, Orienta Park Second Addition to Wichita, Kansas.

BENCHMARK


City of Wichita Bench Mark Disc. 53' south of center line Pawnee and 6' east of Quarter section line south (center line Sheridan north). Elevation = 103.29 City Datum

OWNER

Sam Puck
640 N. Rock Road, Suite 25
Wichita, Kansas 67216
(316) 636-5225

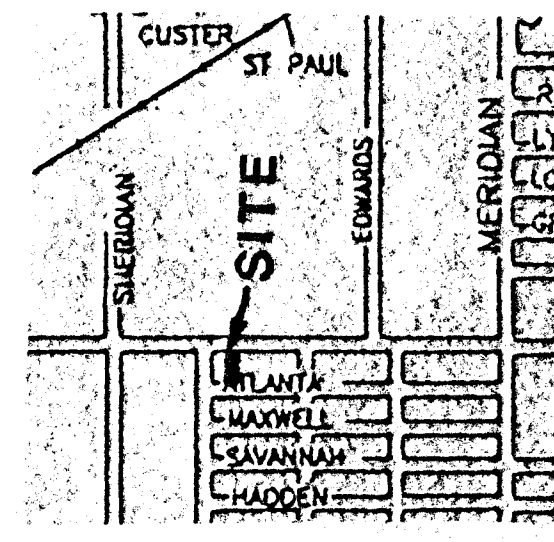

Vicinity Map

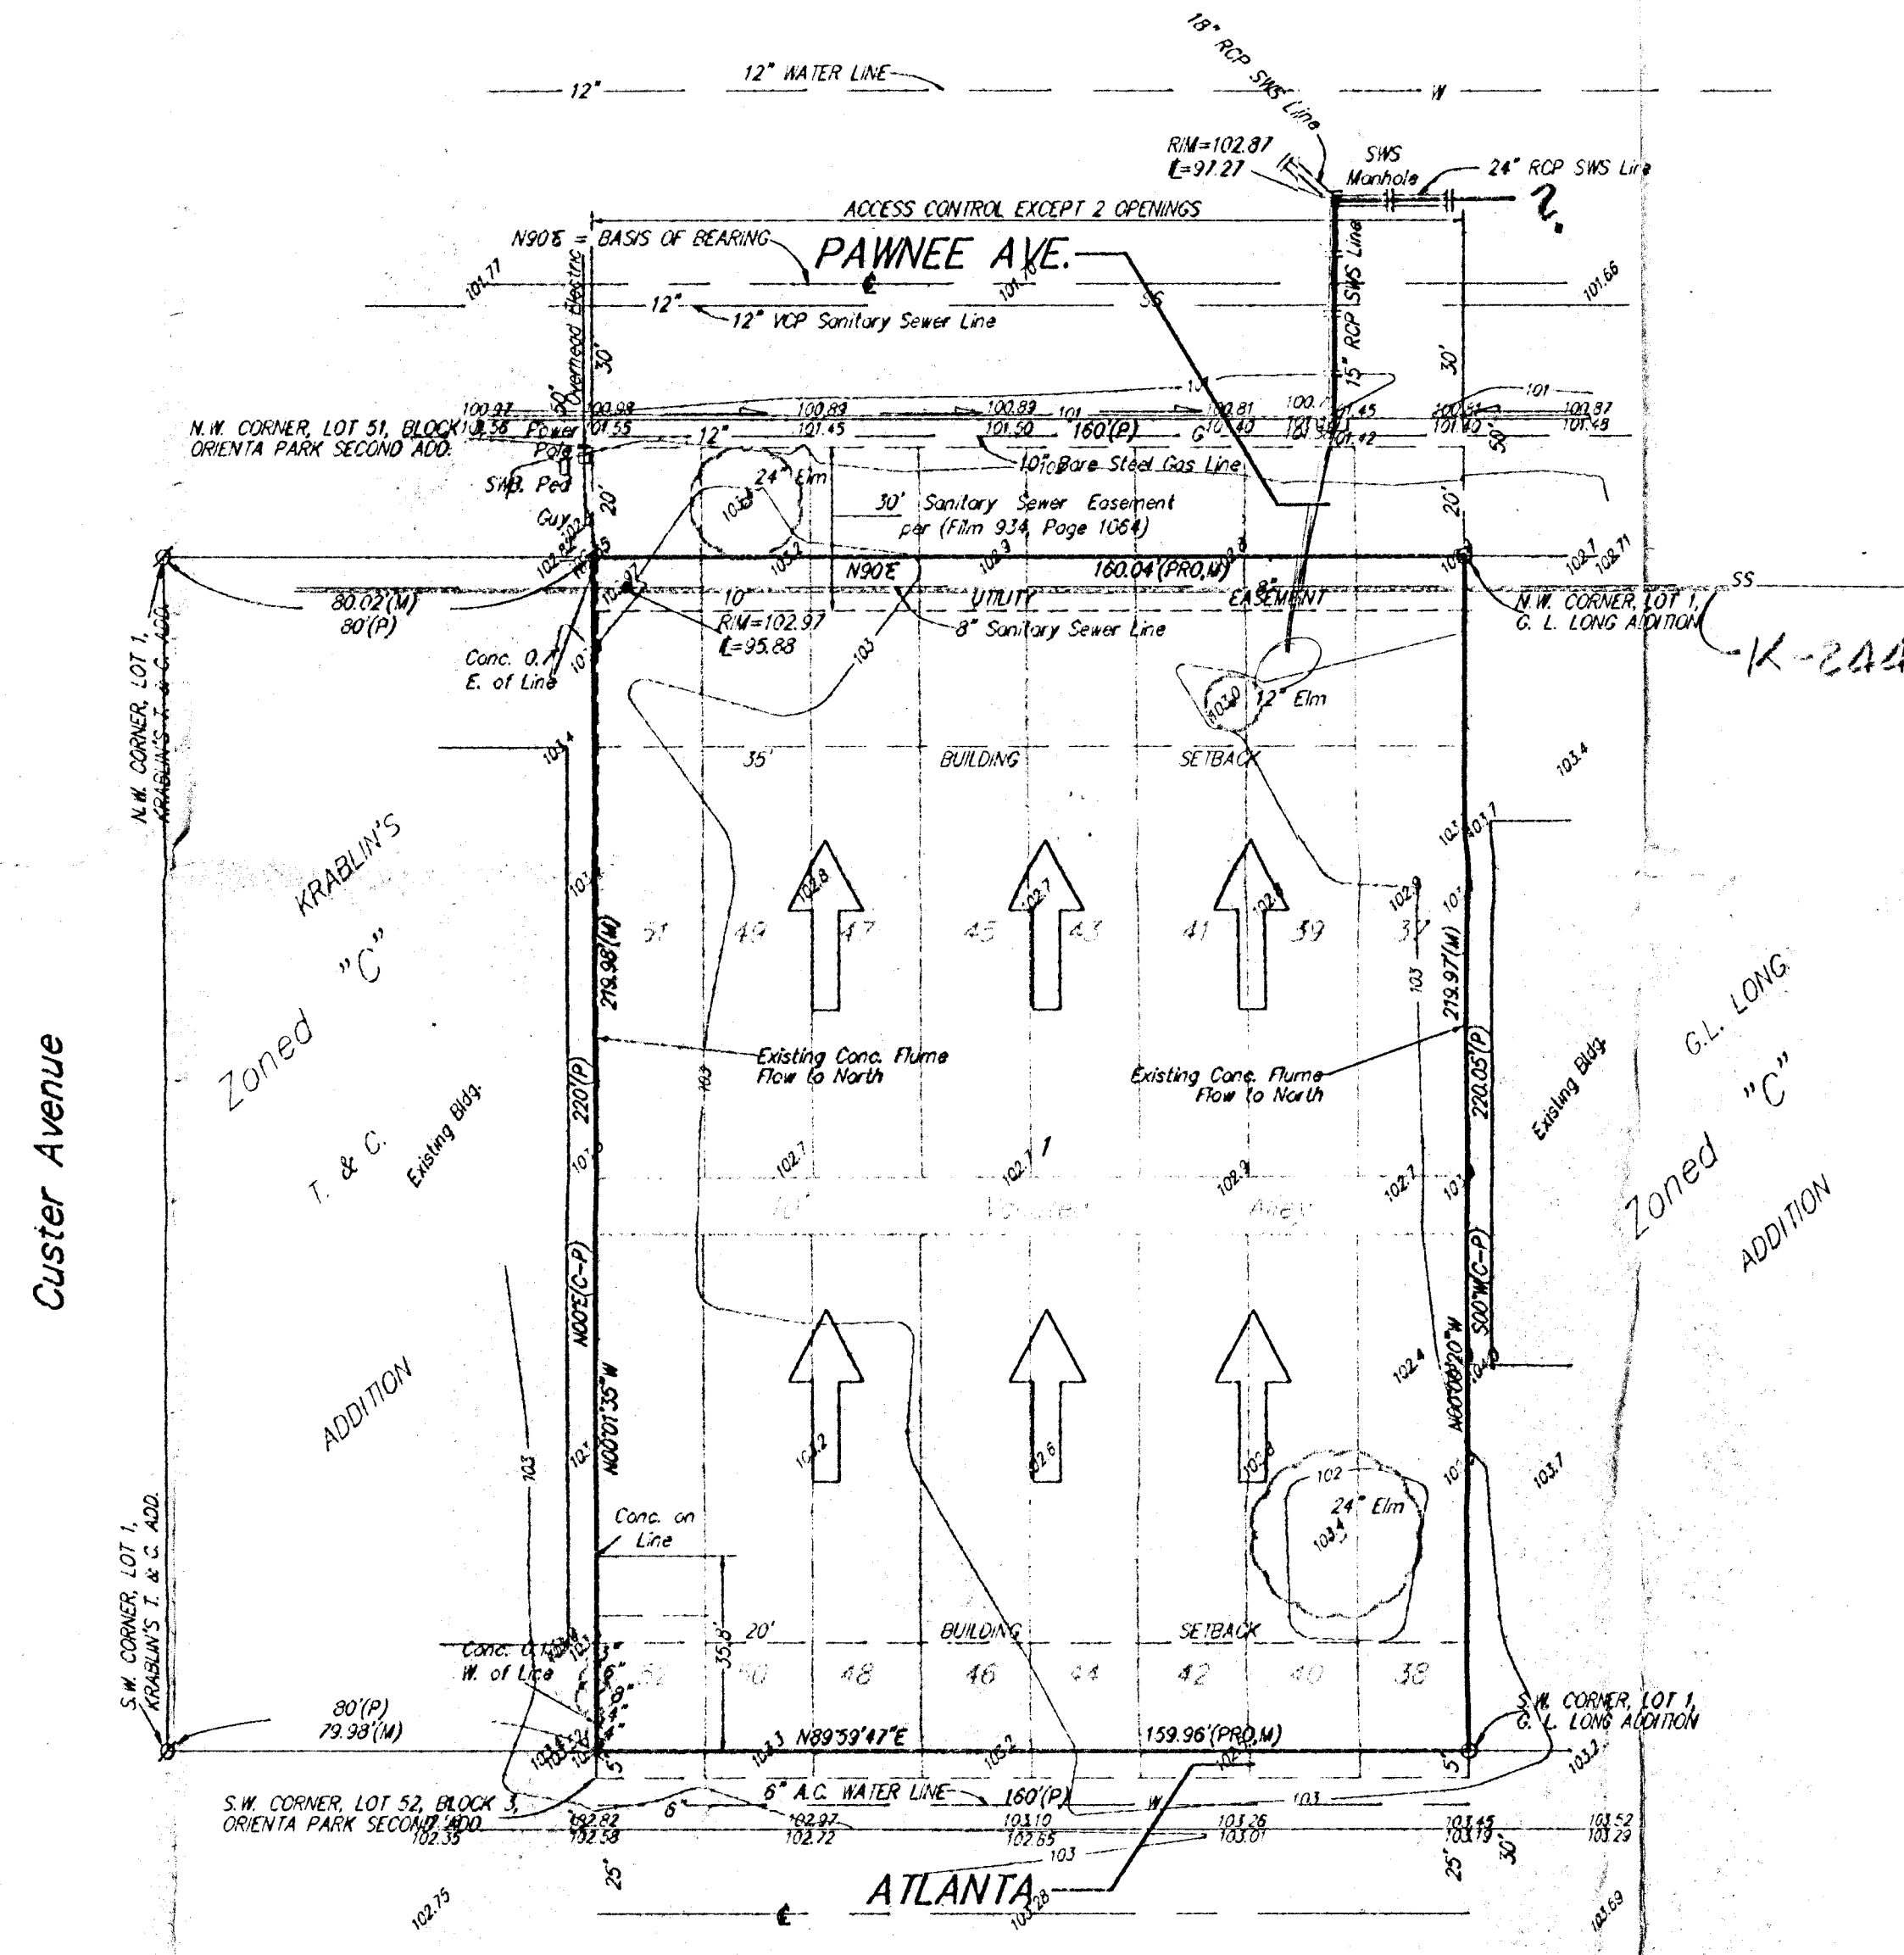

DRAINAGE AREA = 0.81 ac.
 C = 0.9
 Q₅ = 3.3 cfs
 Q₁₀₀ = 5.4 cfs

Private SWS at time of site level.

16 JAN 1995