


# SKETCH PLAN J. ROGERS ADDITION WICHITA, SEDGWICK COUNTY, KANSAS

R.G. STORCK ADDITION AND LOT 14, CENTRAL PHASE EXCEPT THAT PORTION  
CONDEMNED FOR FLOOD CONTROL RIGHT-OF-WAY IN CONDEMNATION CASE A-31849

SCALE 1" = 60'  
 ○ = 1/2" REBAR W/ "X" LAYOUT OF ST  
 □ = REBAR FOUND  
 ○ = 1/2" REBAR FOUND

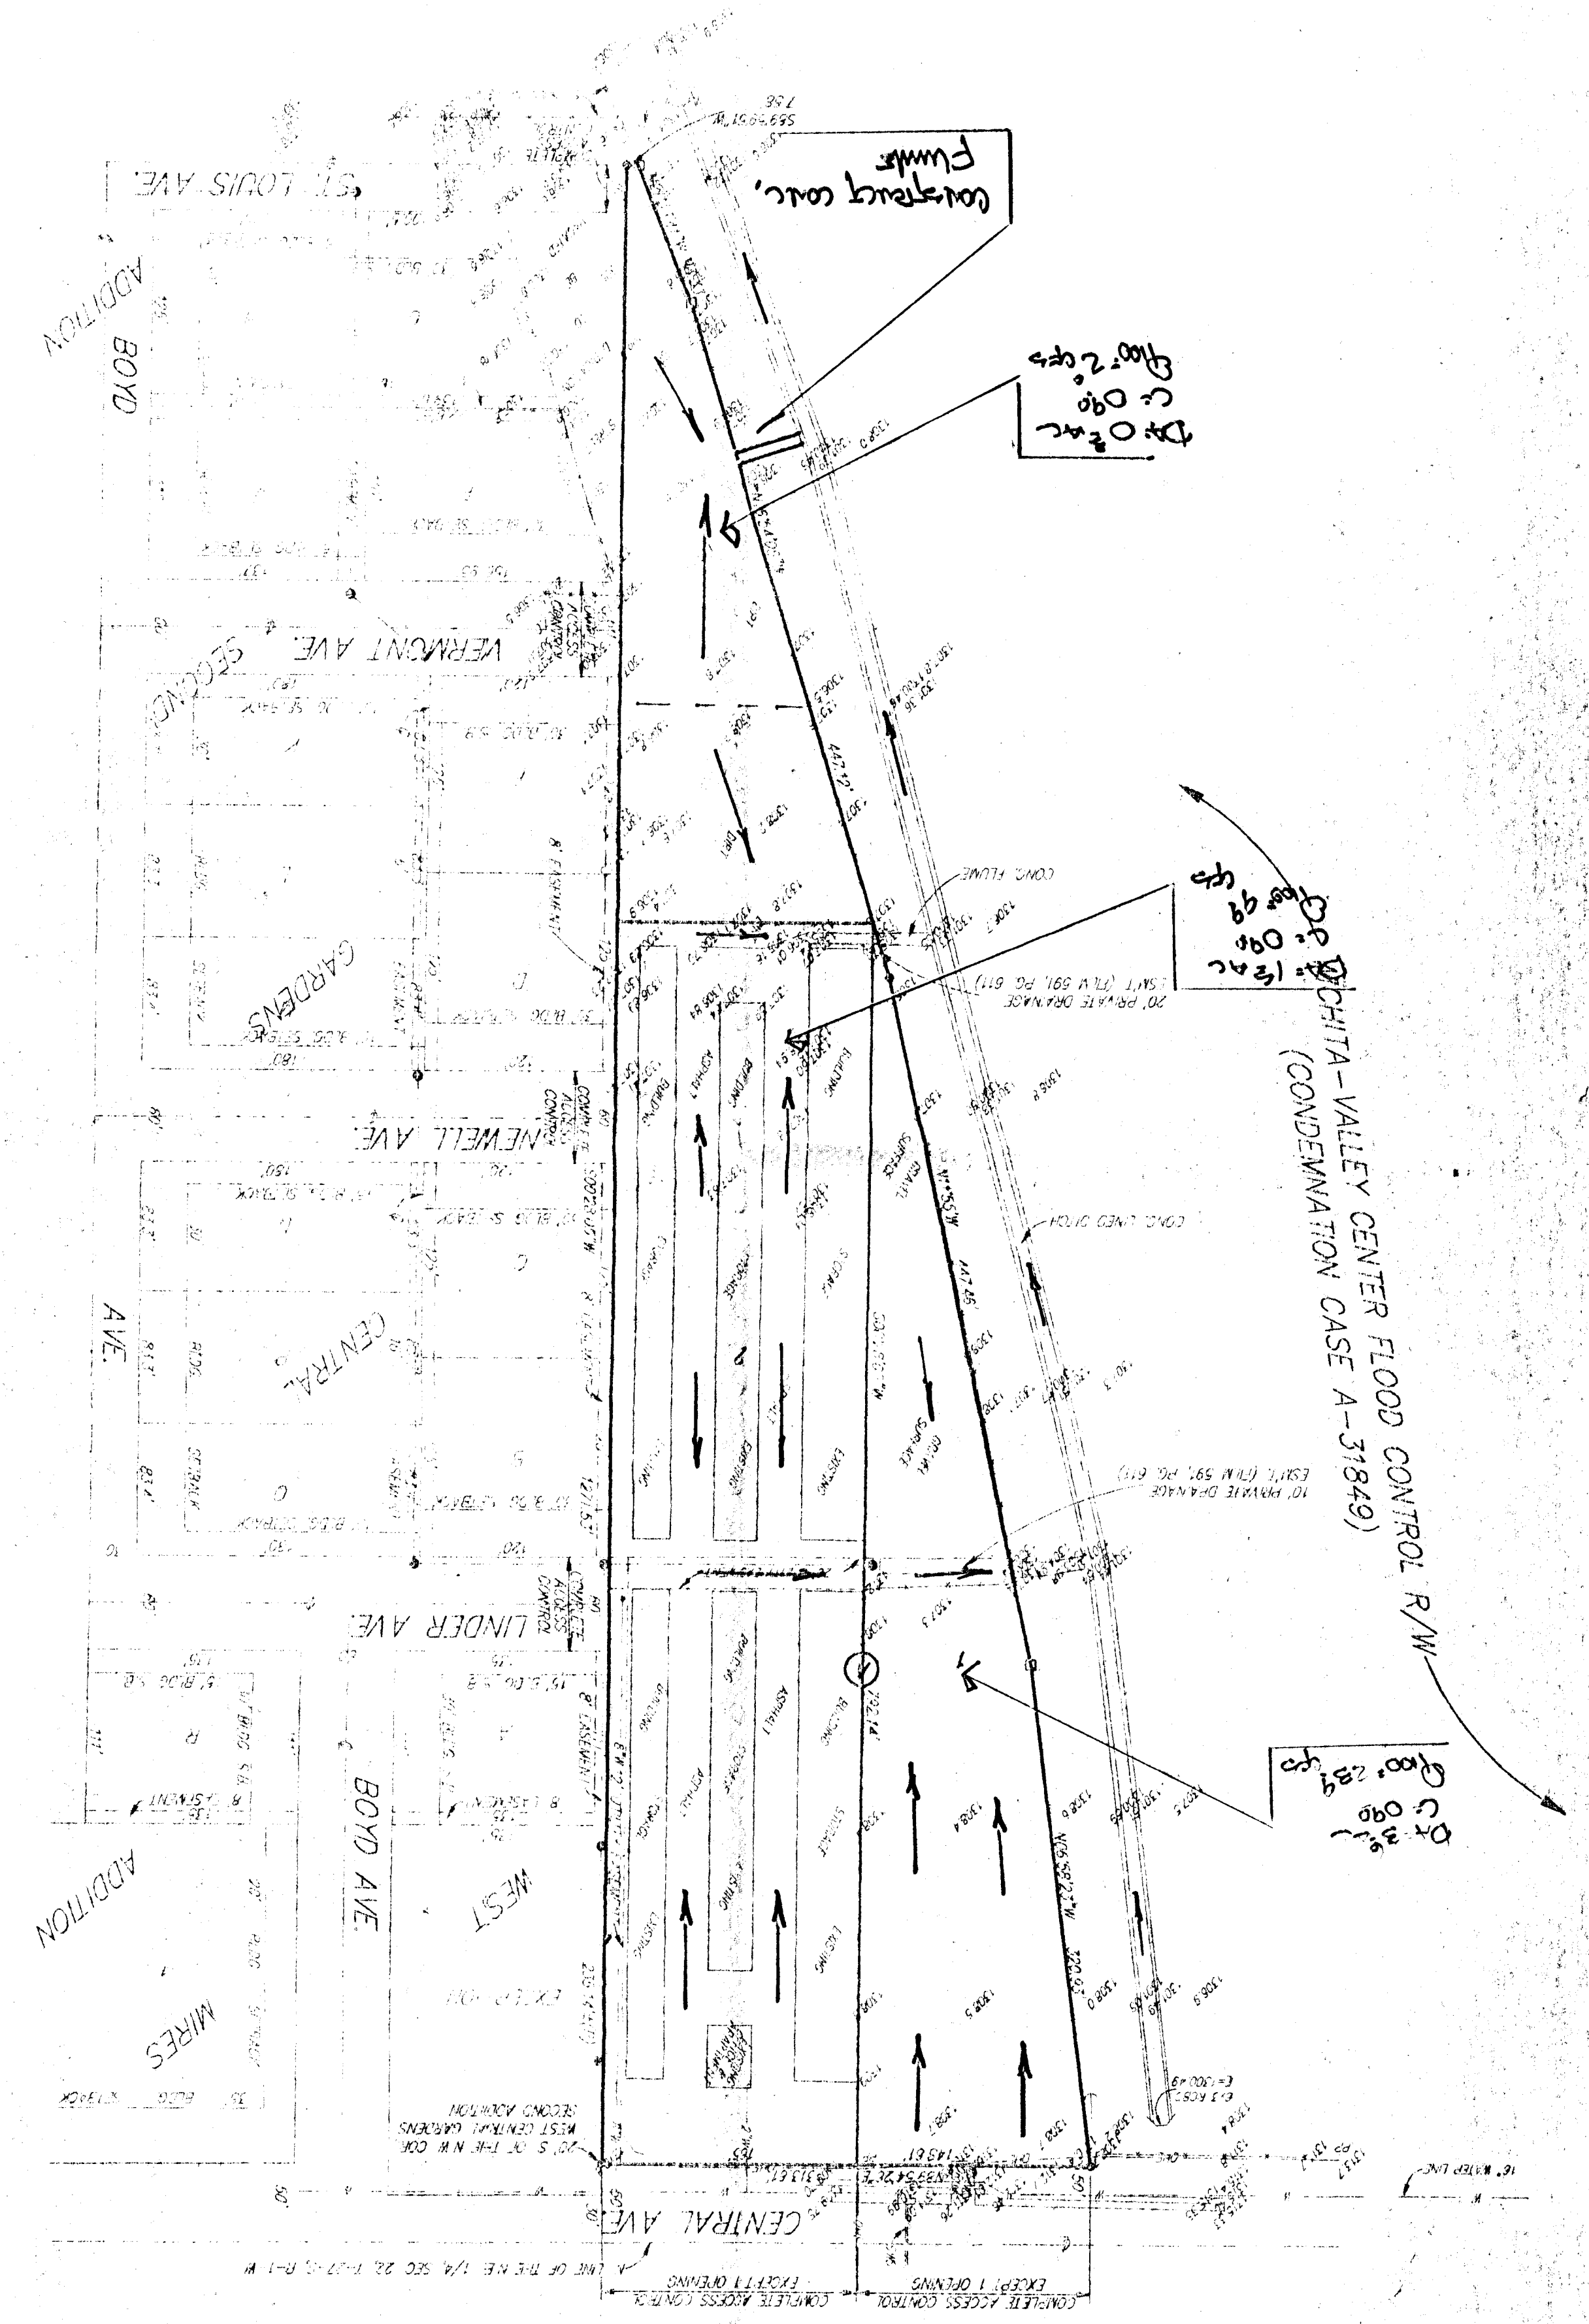

# DRAINAGE PLAN

BAUGHMAN COMPANY P. A.  
 SURVEYING & ENGINEERING  
 316/234-271 • 315 ELLIS • WICHITA, KANSAS 67201  
 15 JAN 1963