SECTION 5

TOWNSHIP 28 RANGE 2E COUNTY SEDGWICK STATE KANSAS

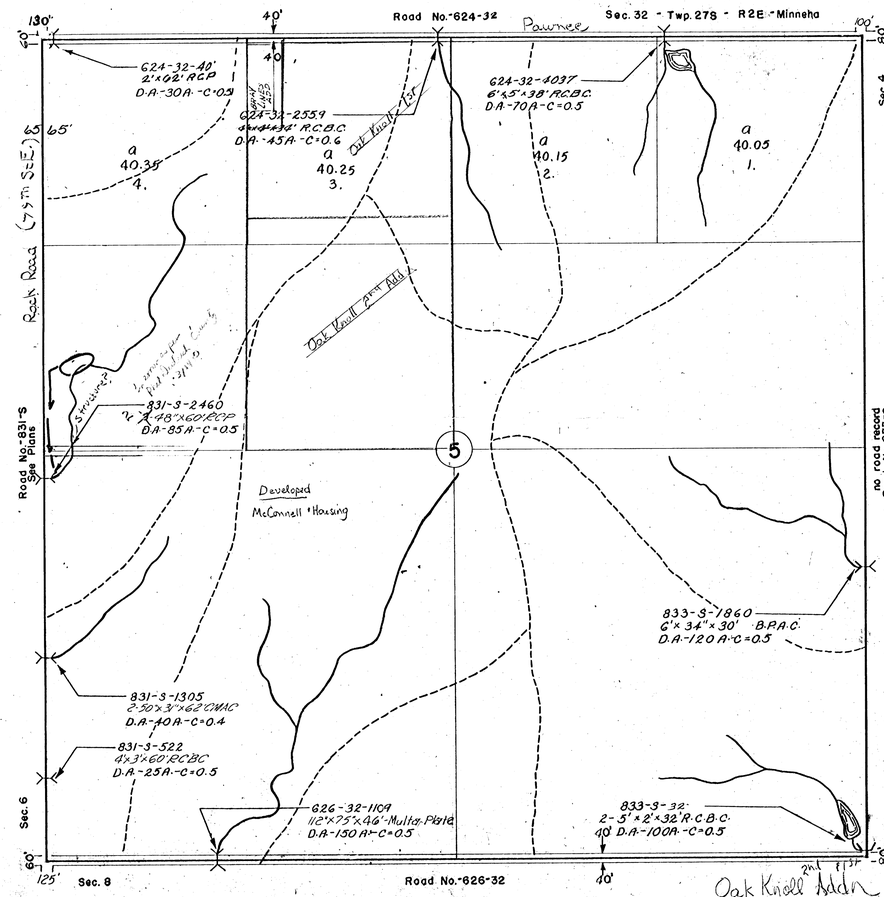

RECEIVED MAR 6 1989
Fm Phil