Fed. Aid Proj. No.	State	Job No.	Year	Sheet No.	Total Sheets
5	Kansas	87-50-1348(3)	1963	23	115

Sta. 583+59.0
N.W. Cor. Sec. 8 - Gypsum
Iron
1. 42.8' S.E. to 3ns in H.L.P.
2. 59.5' S.W. to X on Gate Post
3. 59.7' N.W. to " " " "

P.I. Sta. 604+50
Iron Pin
1. 67.15' N.E. to "x" on steel fc. post
2. 60.55' E. " " " " " "
3. 68.00' S.E. " " " " " "

Sec. 6 - T28S - R2E

Sta. 610+15.1
W. ¼ Cor. Sec. 5 - Gypsum
Thimble in conc. pavement
1. In line of fc. E. & W.
2. 65.40' W. to 3ns in fc. cor. post
3. 70.55' N.W. " " " " post
4. 86.20' S.W. to N.W. cor. of conc. block bldg.
5. 65.25' E. to fc. cor. post of fc. E.

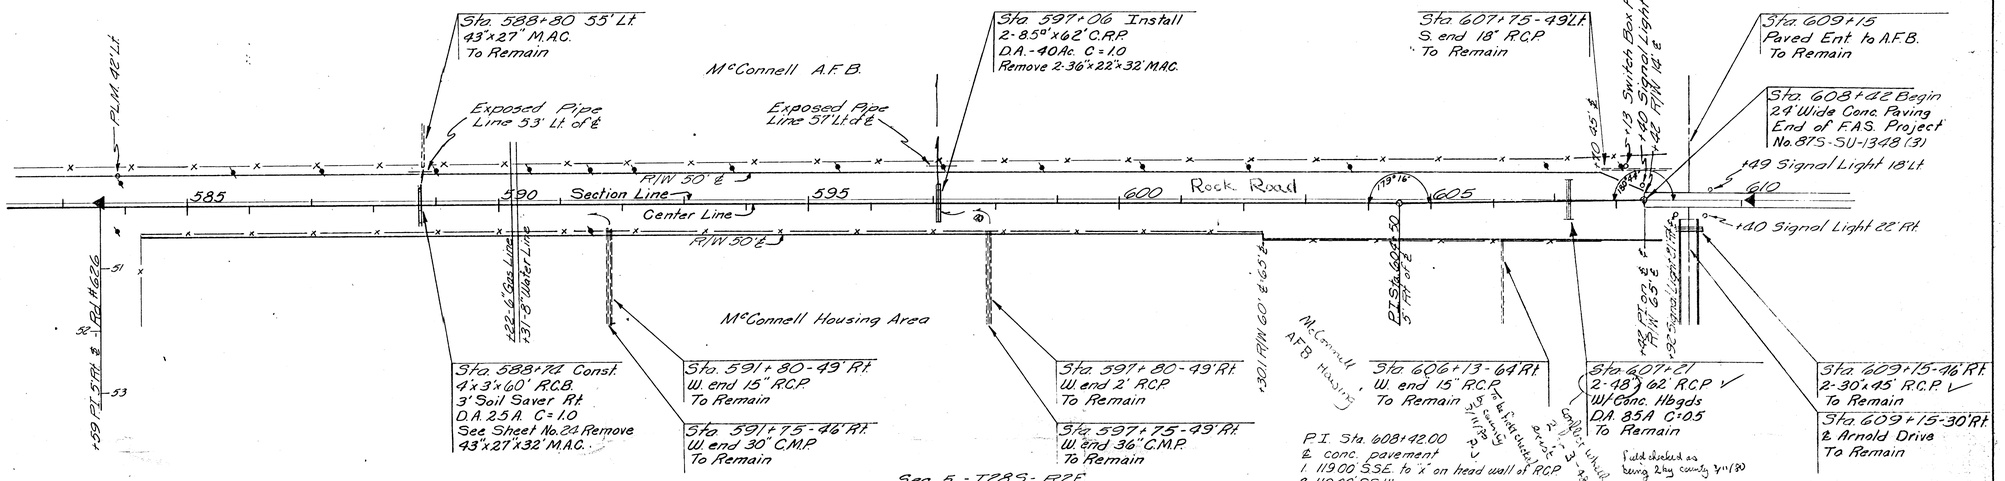

P.I. Sta. 608+42.00
℄ conc. pavement
1. 119.00' S.S.E. to "x" on head wall of R.C.P.
2. 119.00' S.S.W. " " " " " " "
3. 21.50' W.S.W. " " " base of signal light

Field checked as being 2 day county 4/11/80

BM #20 - " on S. Curb of Gate ent. 60' S.W. of Cor. (N.W. Cor. Sec. 8 Gypsum) El. 1371.08

BM #21 - 60d in H.L.P. 75' N.E. of ¼ Cor. (W. ¼ Cor. Sec. 5 - Gypsum Twp.) El. 1372.57

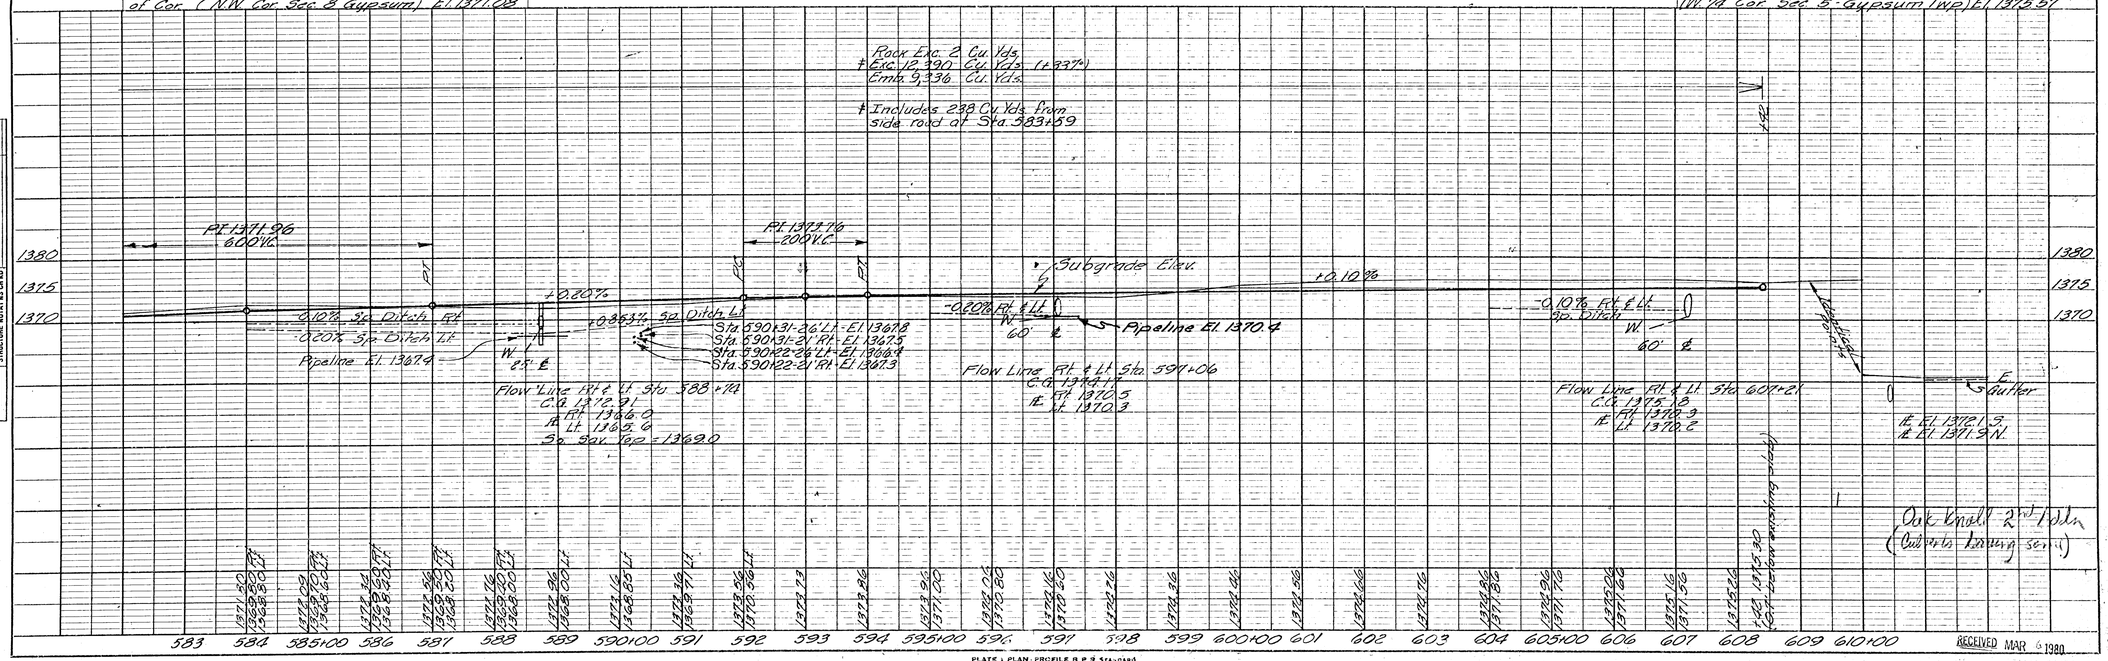

Oak Knoll 2nd Addn
(Quinton Lining Sewer)

RECEIVED MAR 6 1980

PLAN
SURVEYED
PLOTTED
ALIGNMENT CHECKED
NOTE BOOK
NO.
ALT. OF MAT CHECKED.
DATE
BY

PROFILE
SURVEYED
PLOTTED
GRADES CHECKED
NOTE BOOK
NO.
B.M.'s NOTED
STRUCTURE NOTATIONS CHKD.
DATE
BY

Printed in U.S.A.

PLATE 1 PLAN - PROFILE B P R STANDARD
EUCLID DIV. SEN CO. CHICAGO - NEW YORK

Printed in U.S.A.
On ARKWRIGHT Tracing Cloth