


LEGEND

- Inlet location
- Manhole location
- ◀ Outlet location
- 0.32% Low flow direction, street grade
- ◀ 100 Yr. flood routing
- 81.70 Top of curb elevation
- <—> Cross Road Culvert
- Drainage area limits
- Channel protection

Scale 1" = 100'

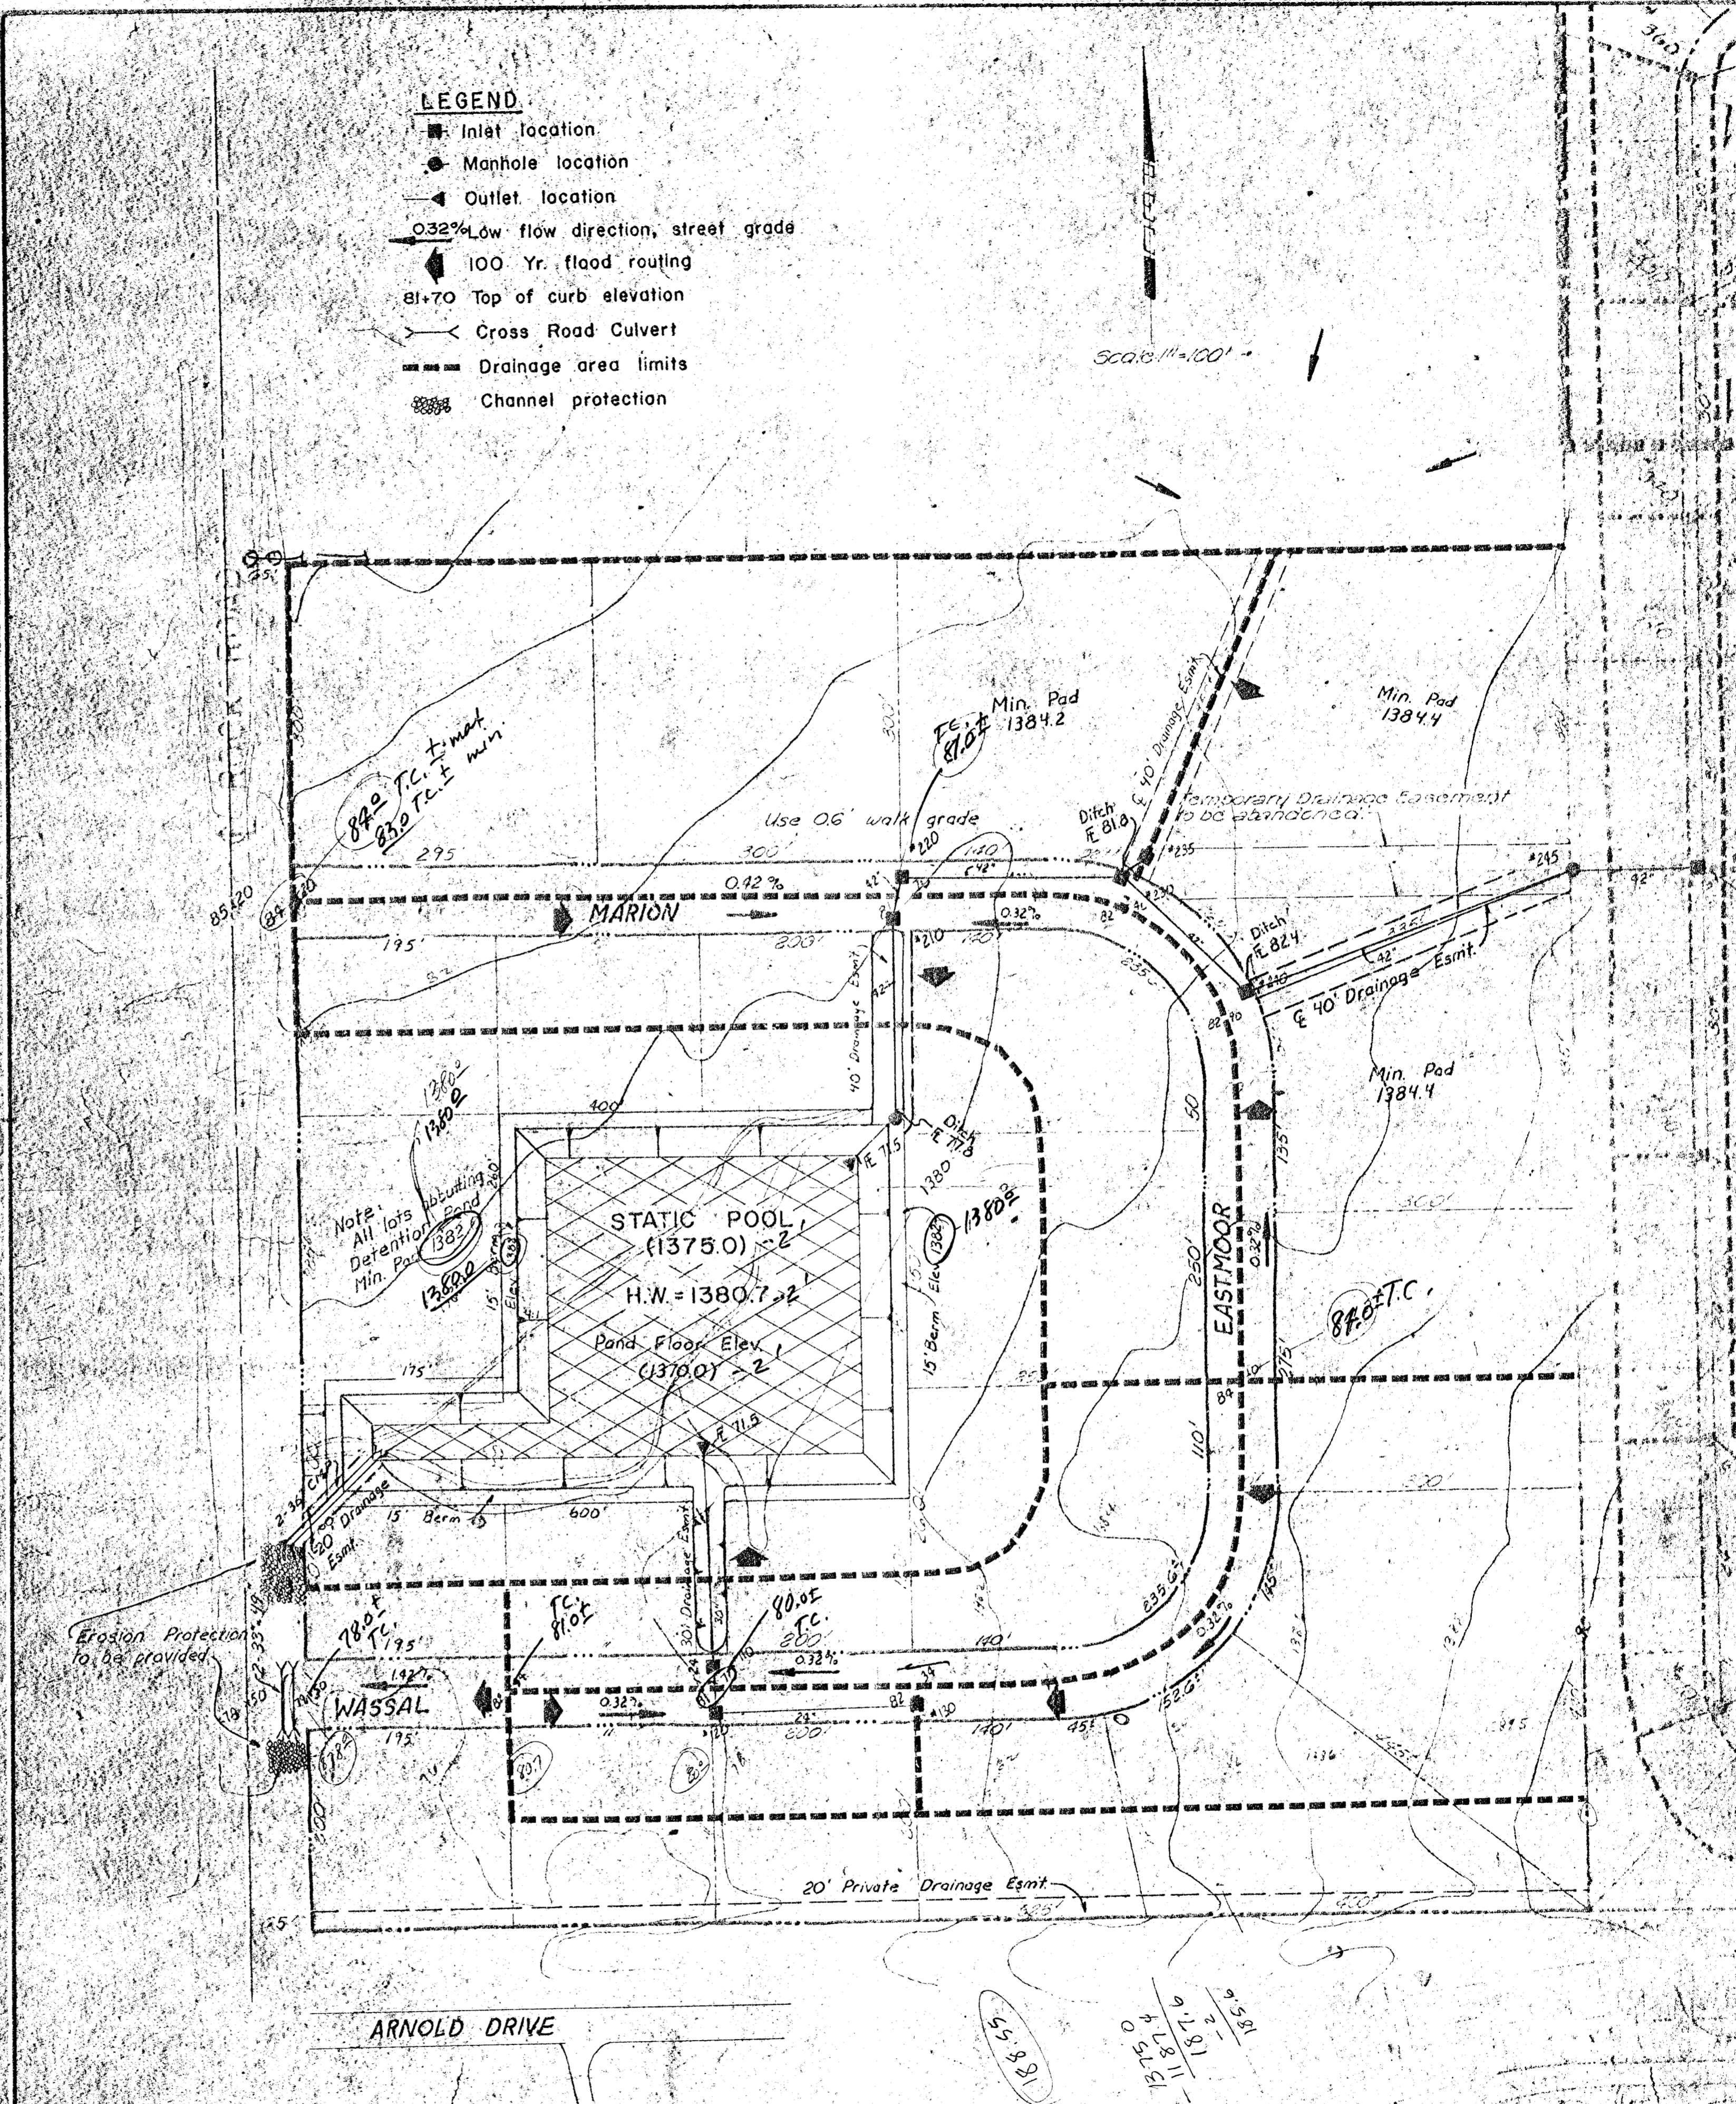

DRAINAGE PLAN
OAK KNOLL INDUSTRIAL PARK ADDITION

Revised 6/9/80
 3/19/81