
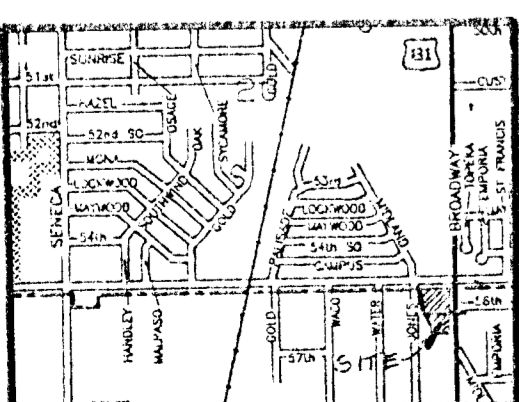


PRELIMINARY PLAT  
**WONG 2ND ADDITION**

WICHITA, SEDGWICK COUNTY, KANSAS

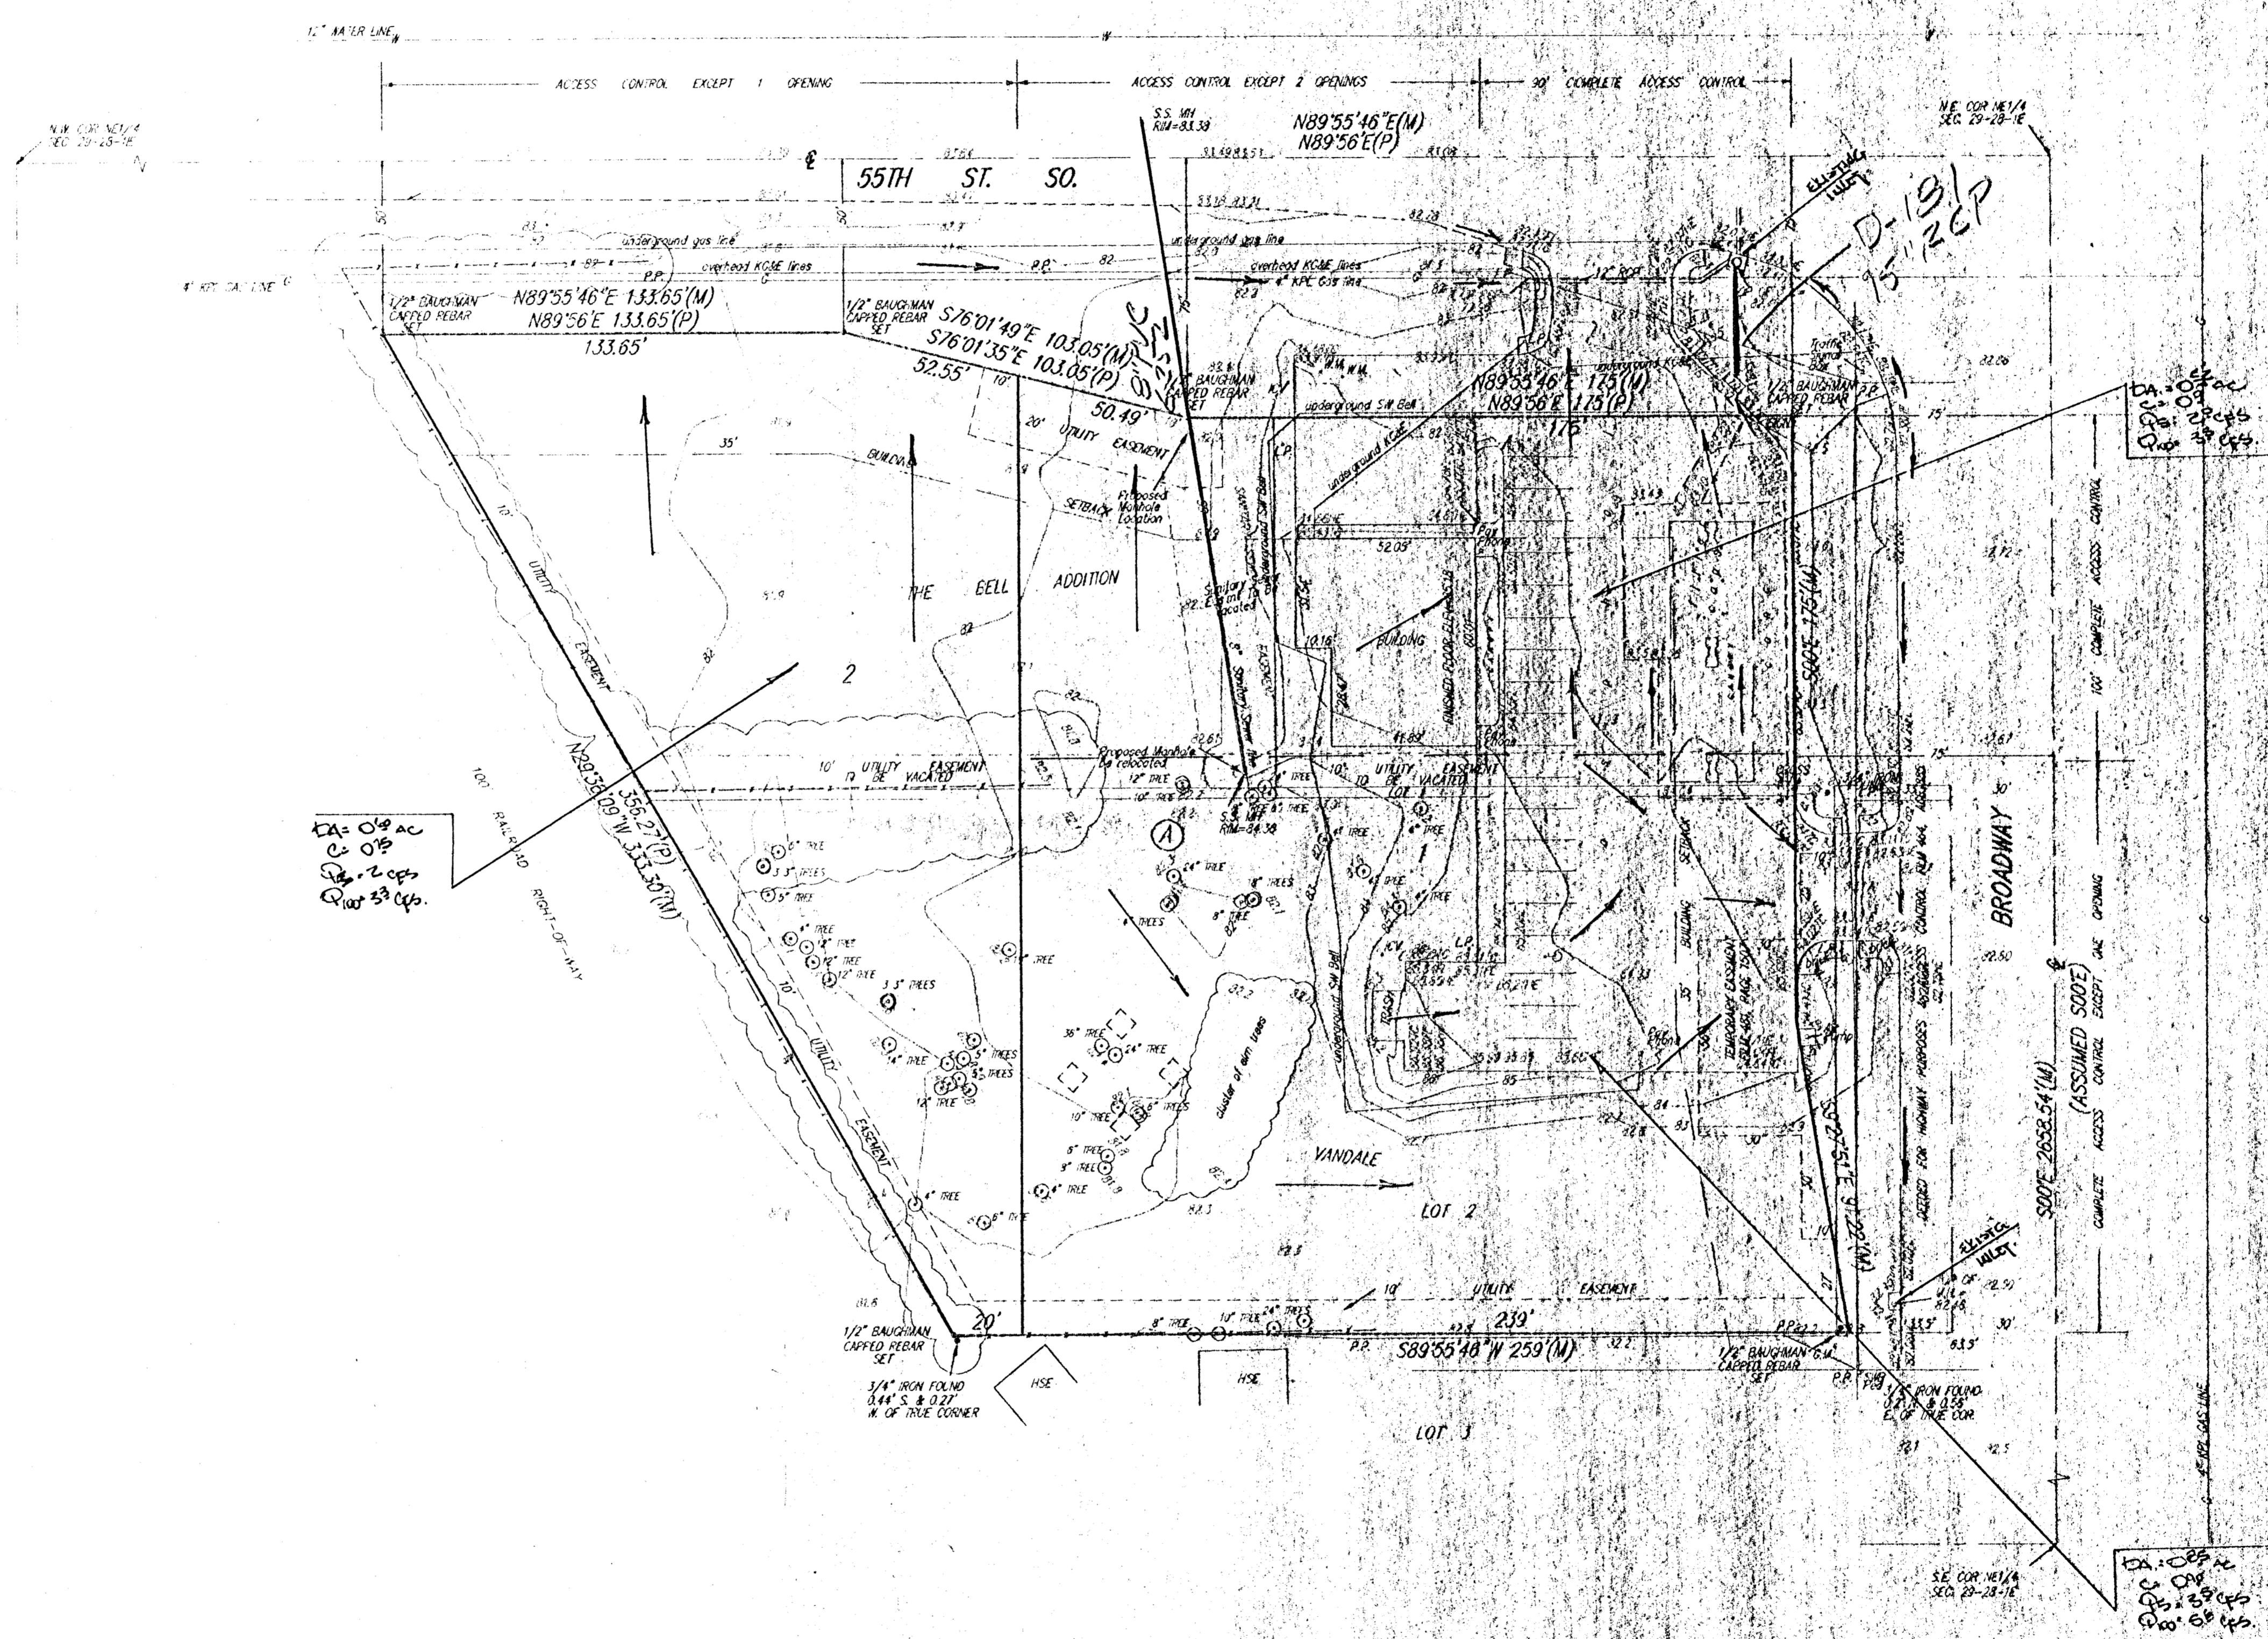

Scale 1"=20'  
 Found Corners are of unidentified origin unless identified on sketch  
 (P) = Plotted  
 (M) = Measured  
 Bearing Base = Assumed

**DRAINAGE PLAN**