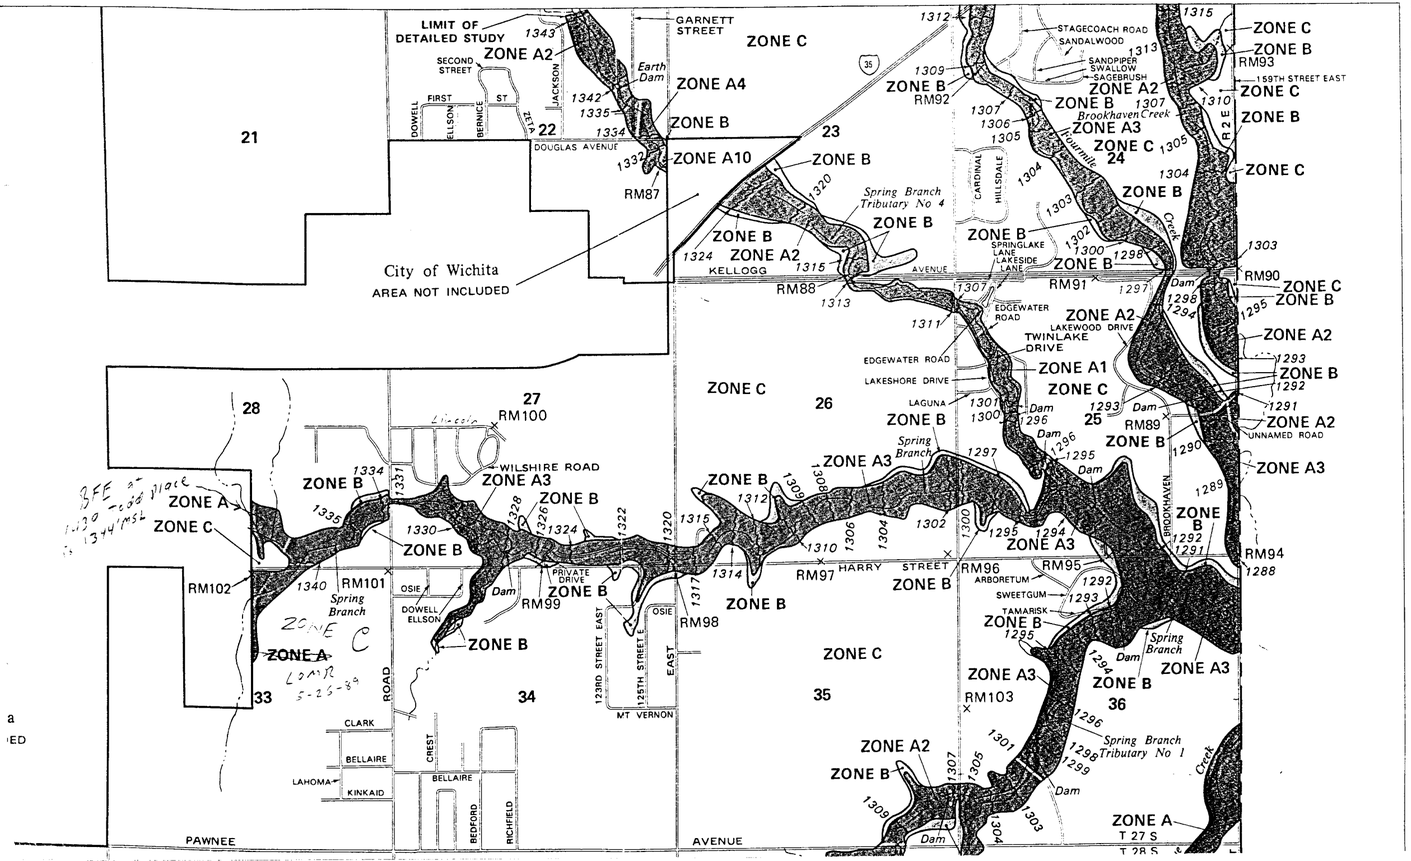
LIMIT OF DETAILED STUDY
City of Wichita
AREA NOT INCLUDED
GARNETT STREET
SECOND STREET
FIRST ST.
DOWELL
ELLSON
BERNICE
JACKSON
ZETA
DOUGLAS AVENUE
Earth Dam
KELLOGG
AVENUE
Spring Branch Tributary No 4
STAGECOACH ROAD
SANDALWOOD
SANDPIPER SWALLOW
SAGEBRUSH
159TH STREET EAST
Brookhaven Creek
CARDINAL
HILLSDALE
Thurmile Creek
SPRINGLAKE LANE
LAKESIDE LANE
EDGEWATER ROAD
LAKEWOOD DRIVE
TWINLAKE DRIVE
LAKESHORE DRIVE
LAGUNA
UNNAMED ROAD
BROOKHAVEN
WILSHIRE ROAD
PRIVATE DRIVE
OSIE
HARRY STREET
ARBORETUM
SWEETGUM
TAMARISK
123RD STREET EAST
125TH STREET EAST
MT VERNON
Spring Branch Tributary No 1
CLARK
BELLAIRE
LAHOMA
KINKAID
CREST
BEDFORD
RICHFIELD
PAWNEE
T 27 S
T 28 S
21
22
23
24
25
26
27
28
33
34
35
36
RM87
RM88
RM89
RM90
RM91
RM92
RM93
RM94
RM95
RM96
RM97
RM98
RM99
RM100
RM101
RM102
RM103
ZONE A
ZONE A0
ZONE A1
ZONE A2
ZONE A3
ZONE A4
ZONE A10
ZONE B
ZONE C