


SKETCH PLAT
ZIP'S ADDITION

PART OF LOT 3, BLOCK 1, GENTRY
 4TH ADDITION, WICHITA, KANSAS

OWNER: RIDGE ROAD BOWL, INC.
 JOHN KRUM PRES.

J 185
 L 107
 D L

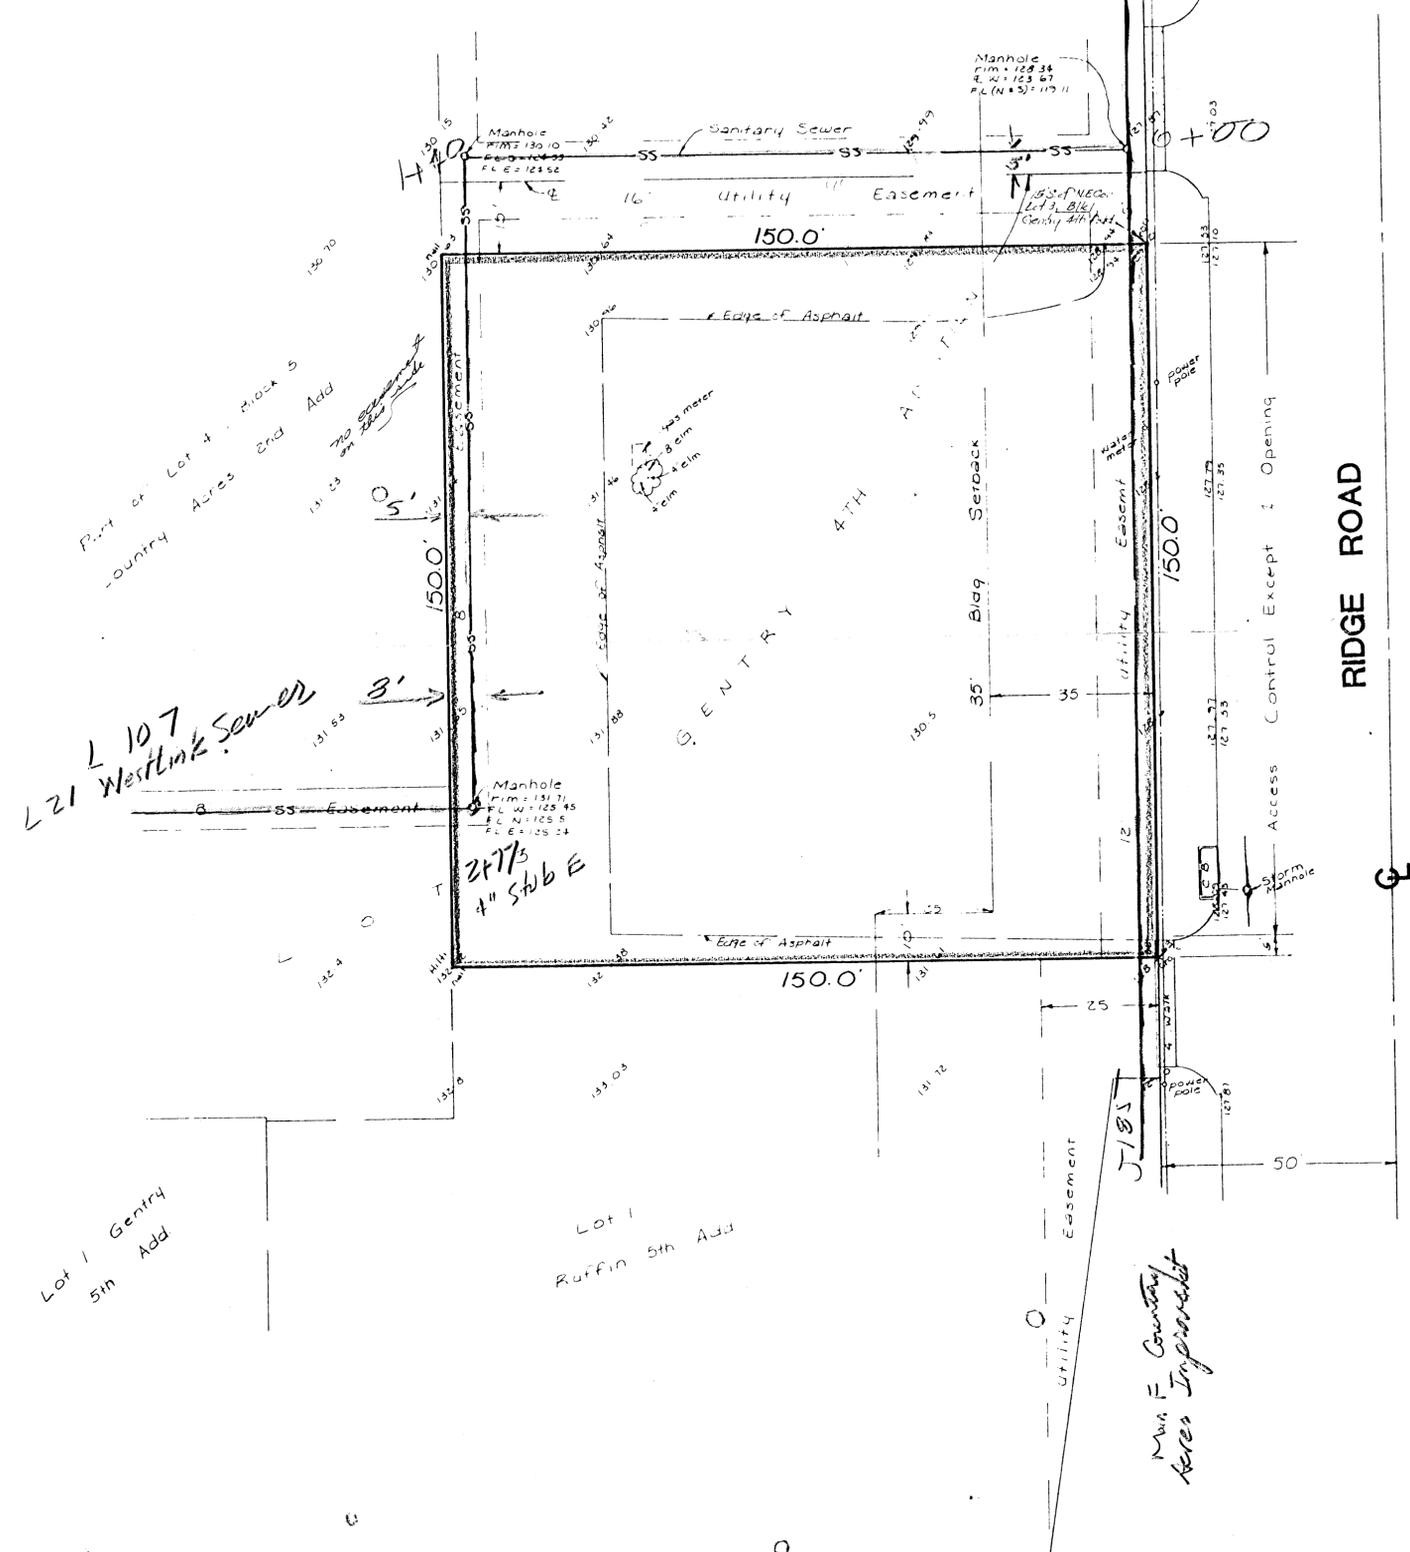

Part of Lot 4 Block 5
 Country Acres End Add

L 107
 Westlink Sewer

Lot 1 Gentry
 5th Add

Lot 1
 Ruffin 5th Add

Mrs. F. Country
 Acres Improved

RIDGE ROAD