GOEDECKE ENGINEERING CO.
P. O. BOX 629
EL DORADO, KANSAS 67042
PHONE 316-321-3773
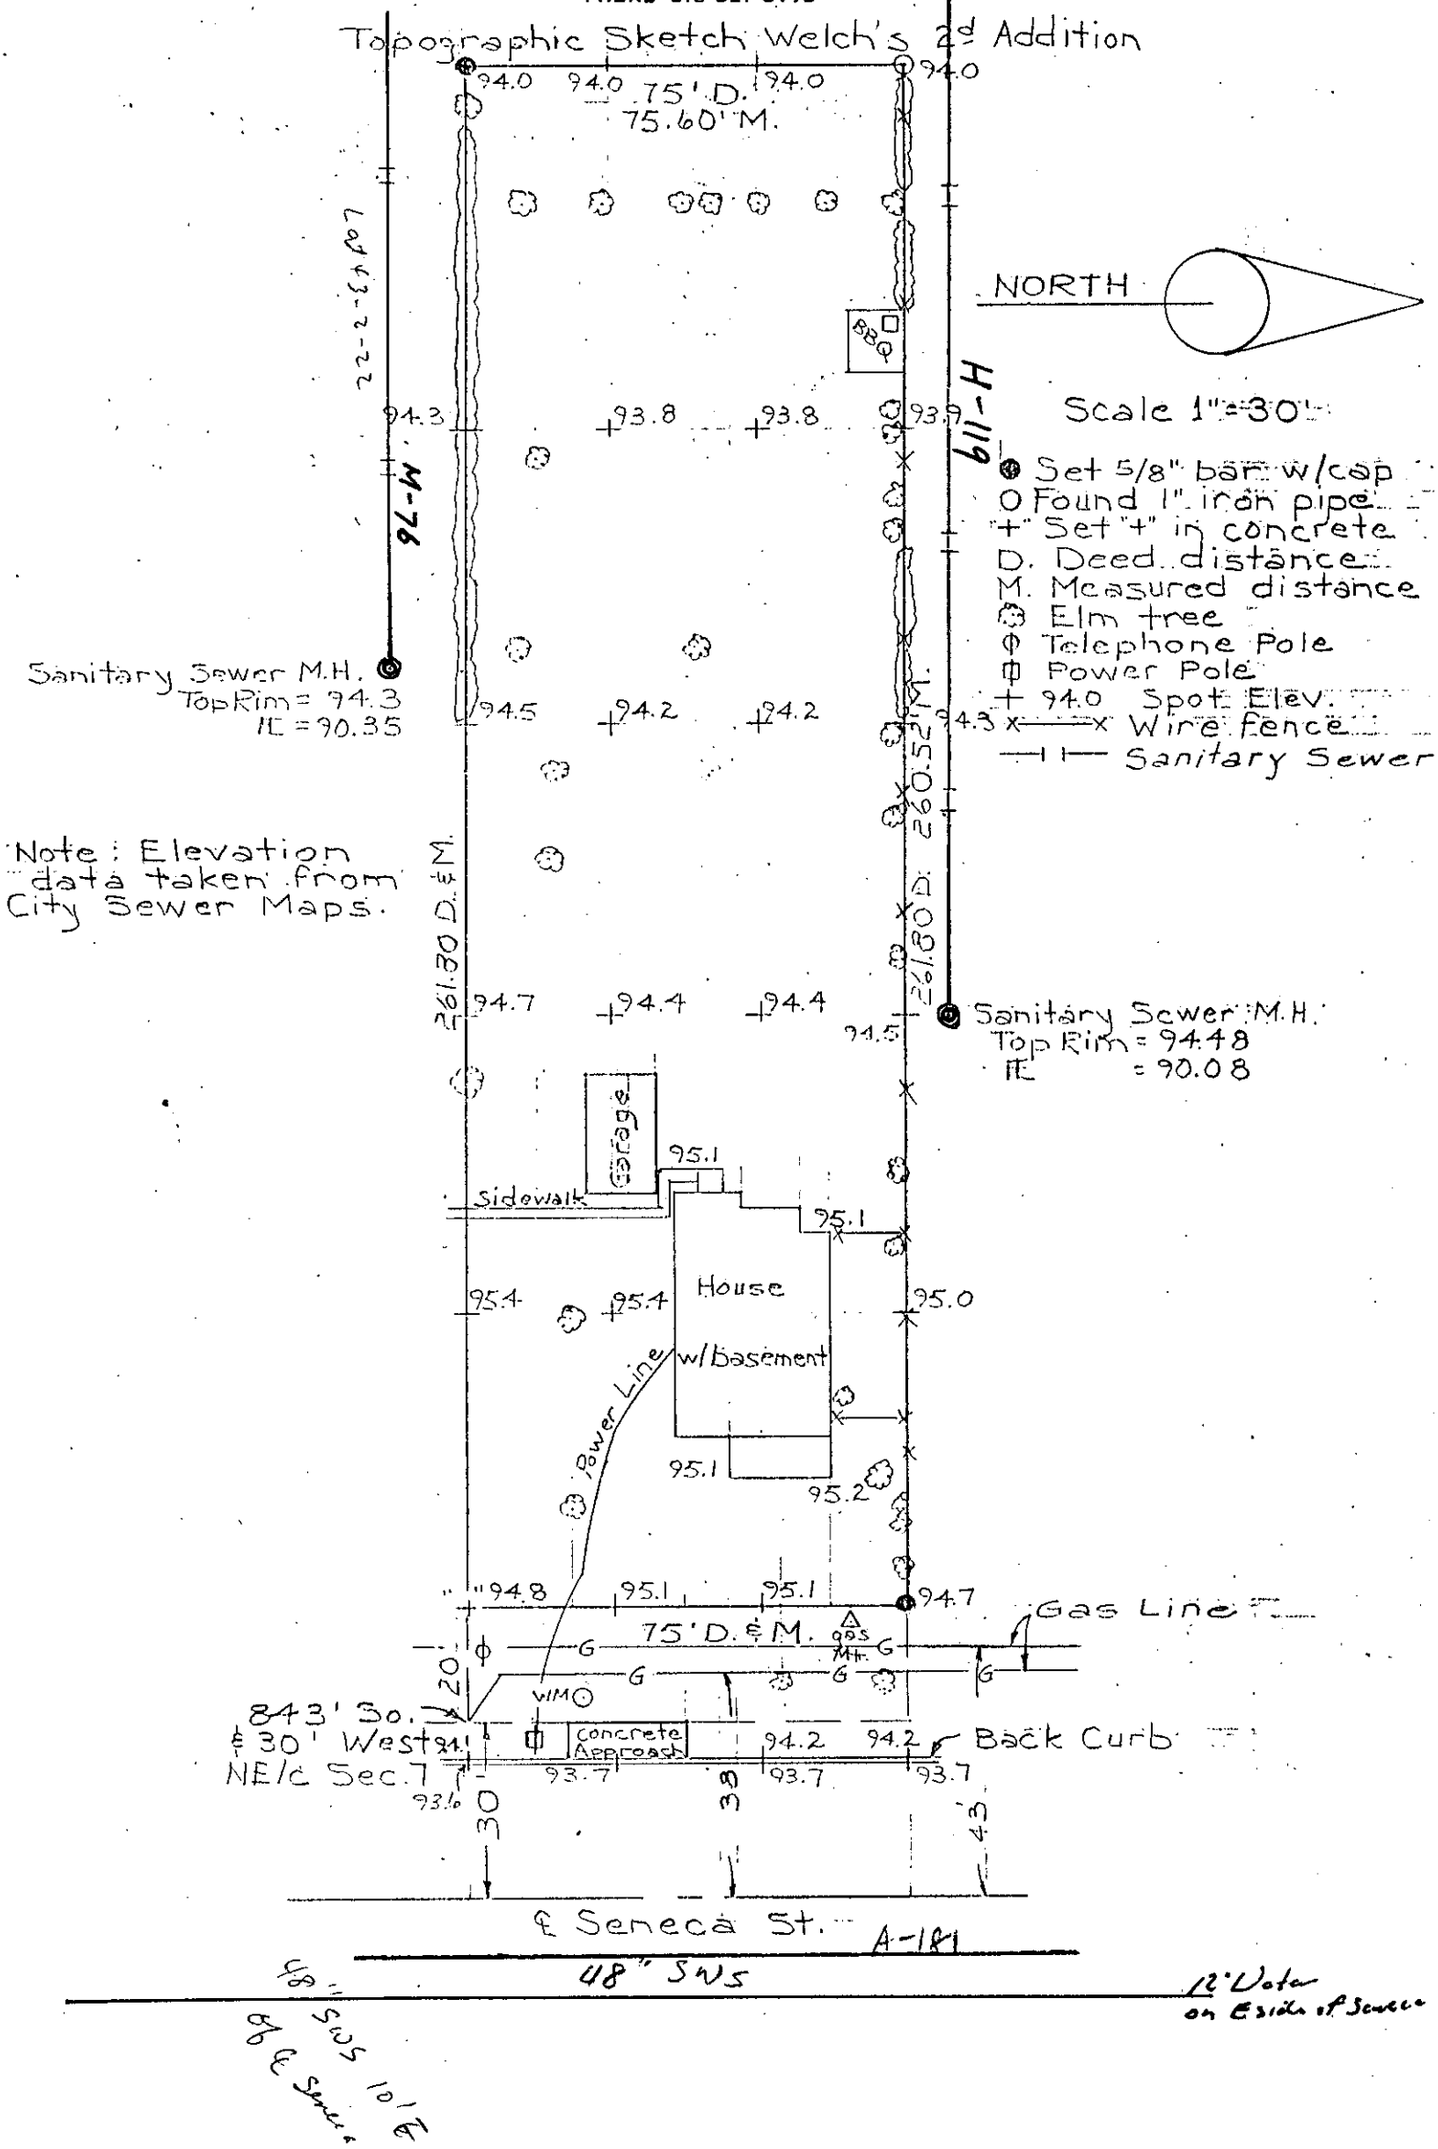
Topographic Sketch Welch's 2nd Addition