



*Handwritten notes:*  
 1  
 2  
 3  
 4  
 5  
 6  
 7  
 8  
 9  
 10  
 11  
 12  
 13  
 14  
 15  
 16  
 17  
 18

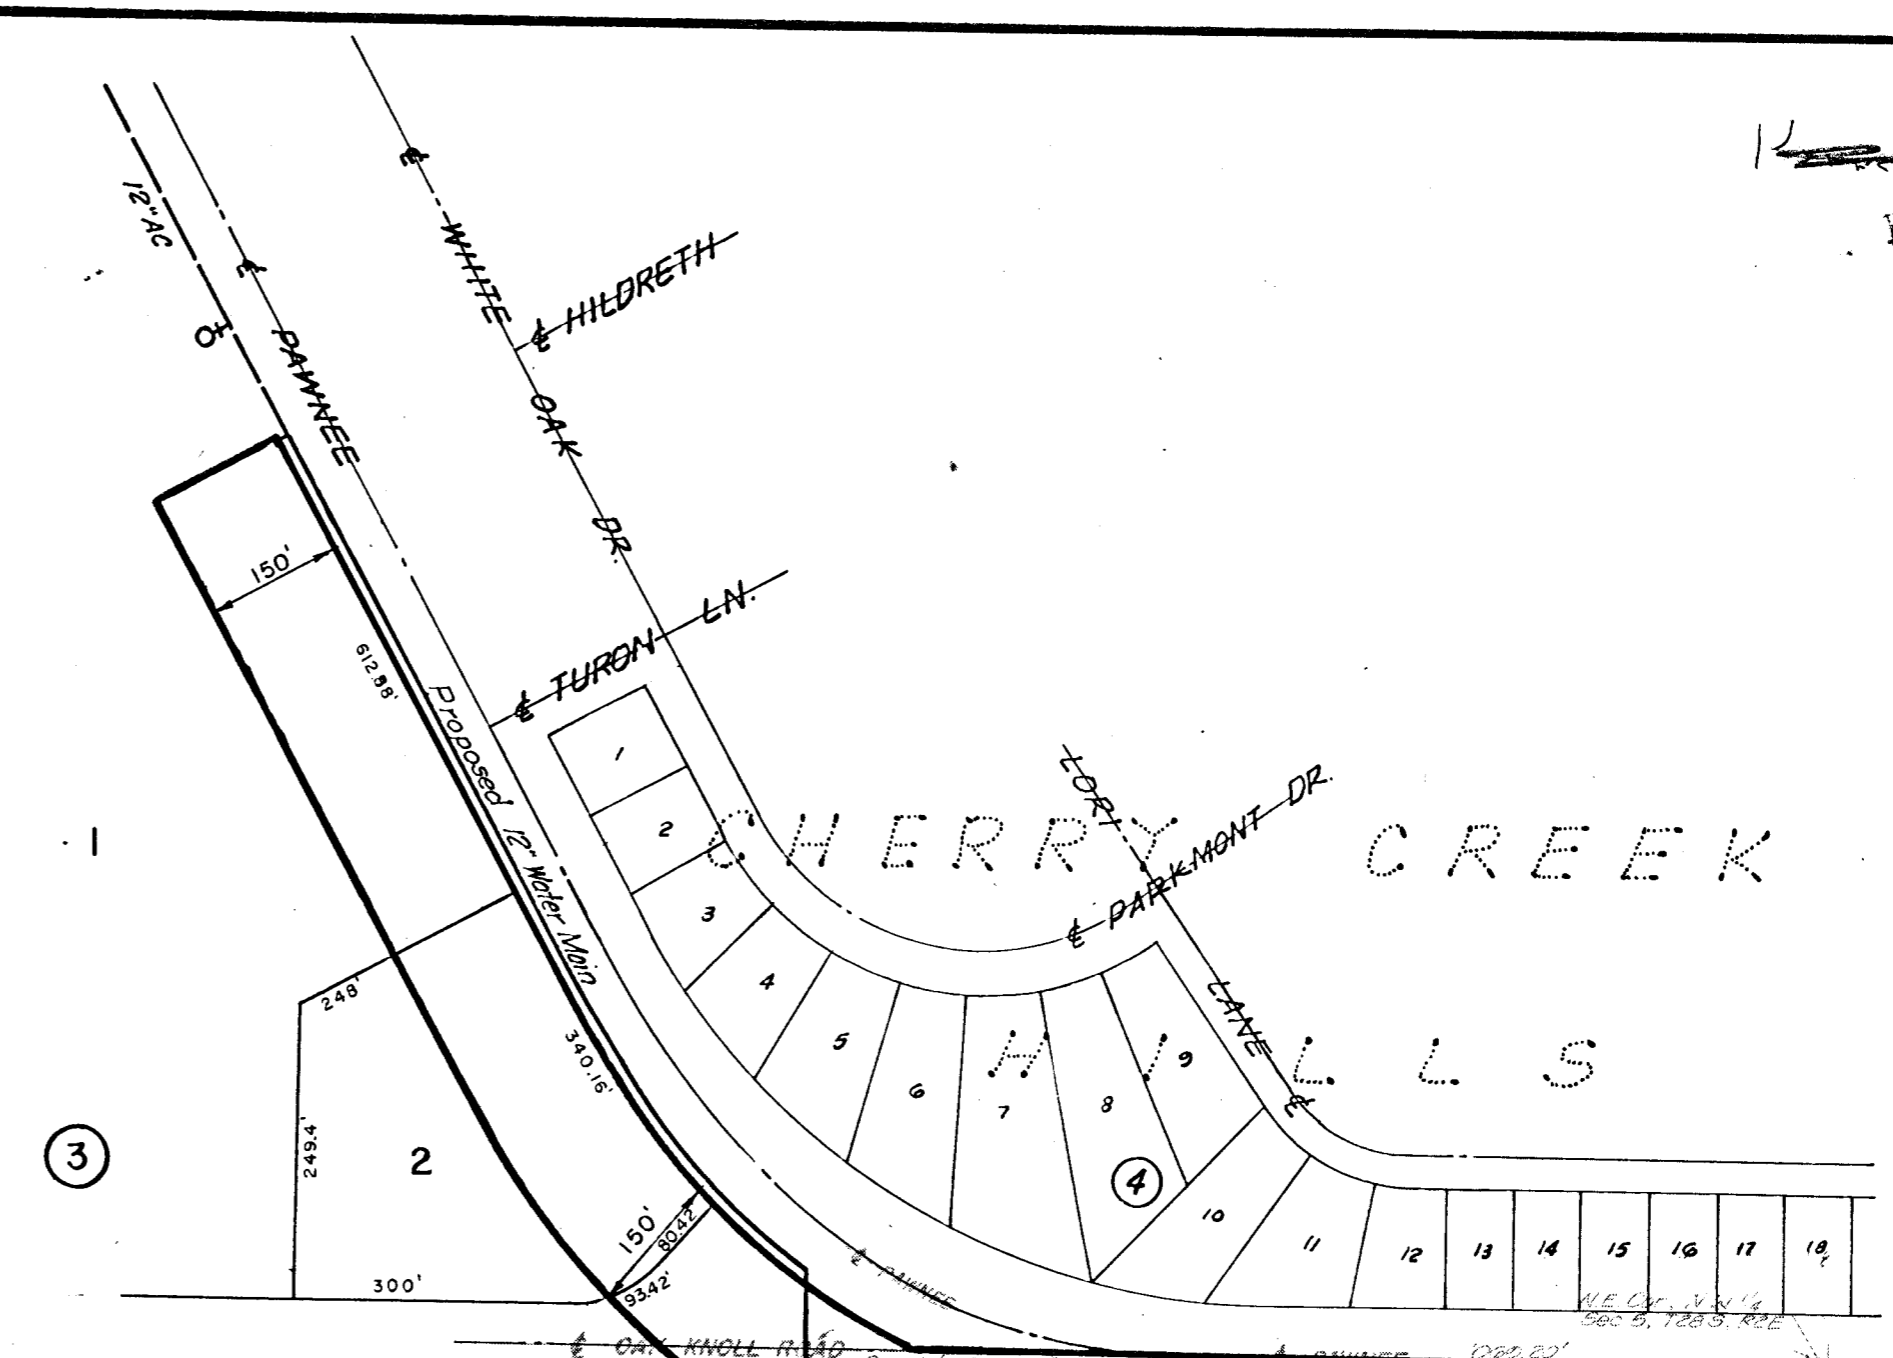

BM - Rock #2, Pawnee, East  
 City of Wichita B.M. data  
 62 ft east and 53 ft north of  
 centerline both. 10/73  
 Elev. = 1281.250

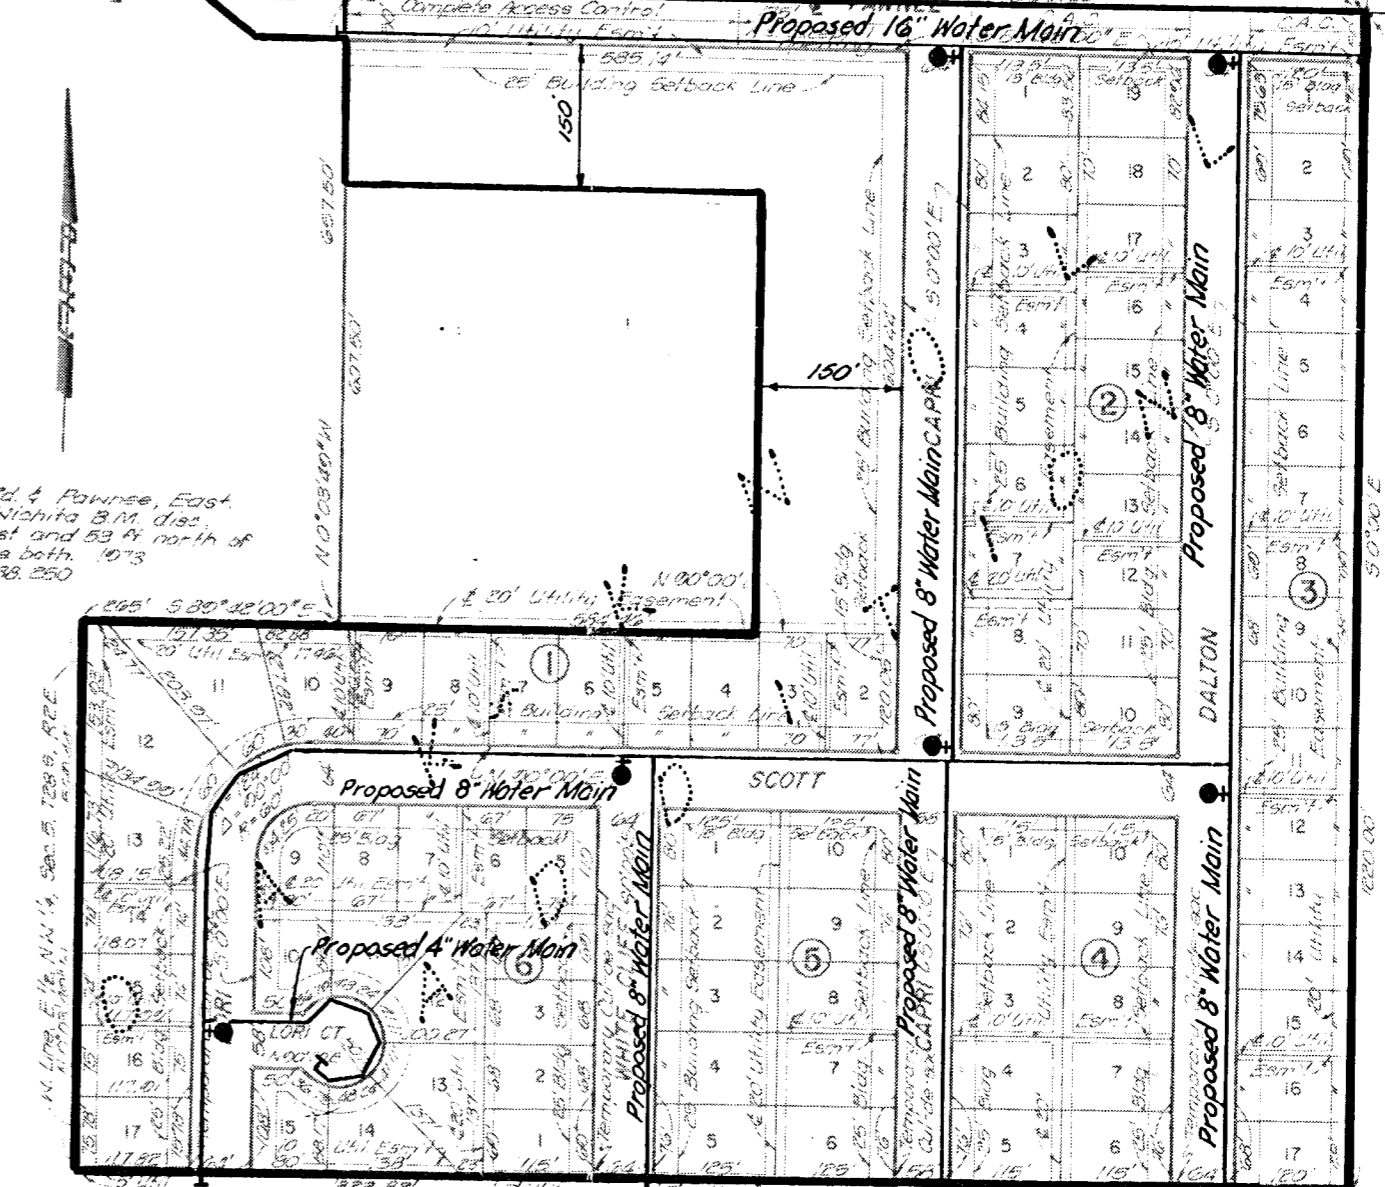

**L E G E N D**

Proposed Benefit District Boundaries	
Existing Water Main	
Proposed Water Main	
Existing Fire Hydrant	
Proposed Fire Hydrant	

Proposed Benefit District Boundaries

Approved By *[Signature]* Date 9-26-79  
 J.D.W. *[Signature]*  
 B.H.O. *[Signature]* 9-26-79

CITY OF WICHITA WATER DEPARTMENT ENGINEERING DIVISION			
DRAWN	SCALE	REVISIONS	DATE
PEC, JS	1" = 200'		
CHECKED			
APPROVED			
DATE			
TITLE Oak Knoll Addition Benefit District 708-79			NO 587-80-925 80667-000-000-001